


FHWA REGION NO.	STATE	PROJECT NO.	YEAR	SHEET NO.	TOTAL SHEETS
7	KANSAS	54-87 K-6657-01	2002	691	1122

DATE	BY	REFERENCES NOTED	REFERENCES CHECKED

DSNR: WDH OPER: JGP SCALE: 1:500
1:1997/97362/Marking/PL178.DGN 11-19-1999 14:46:26 LAST REV: 1-24-2002 BY: svb

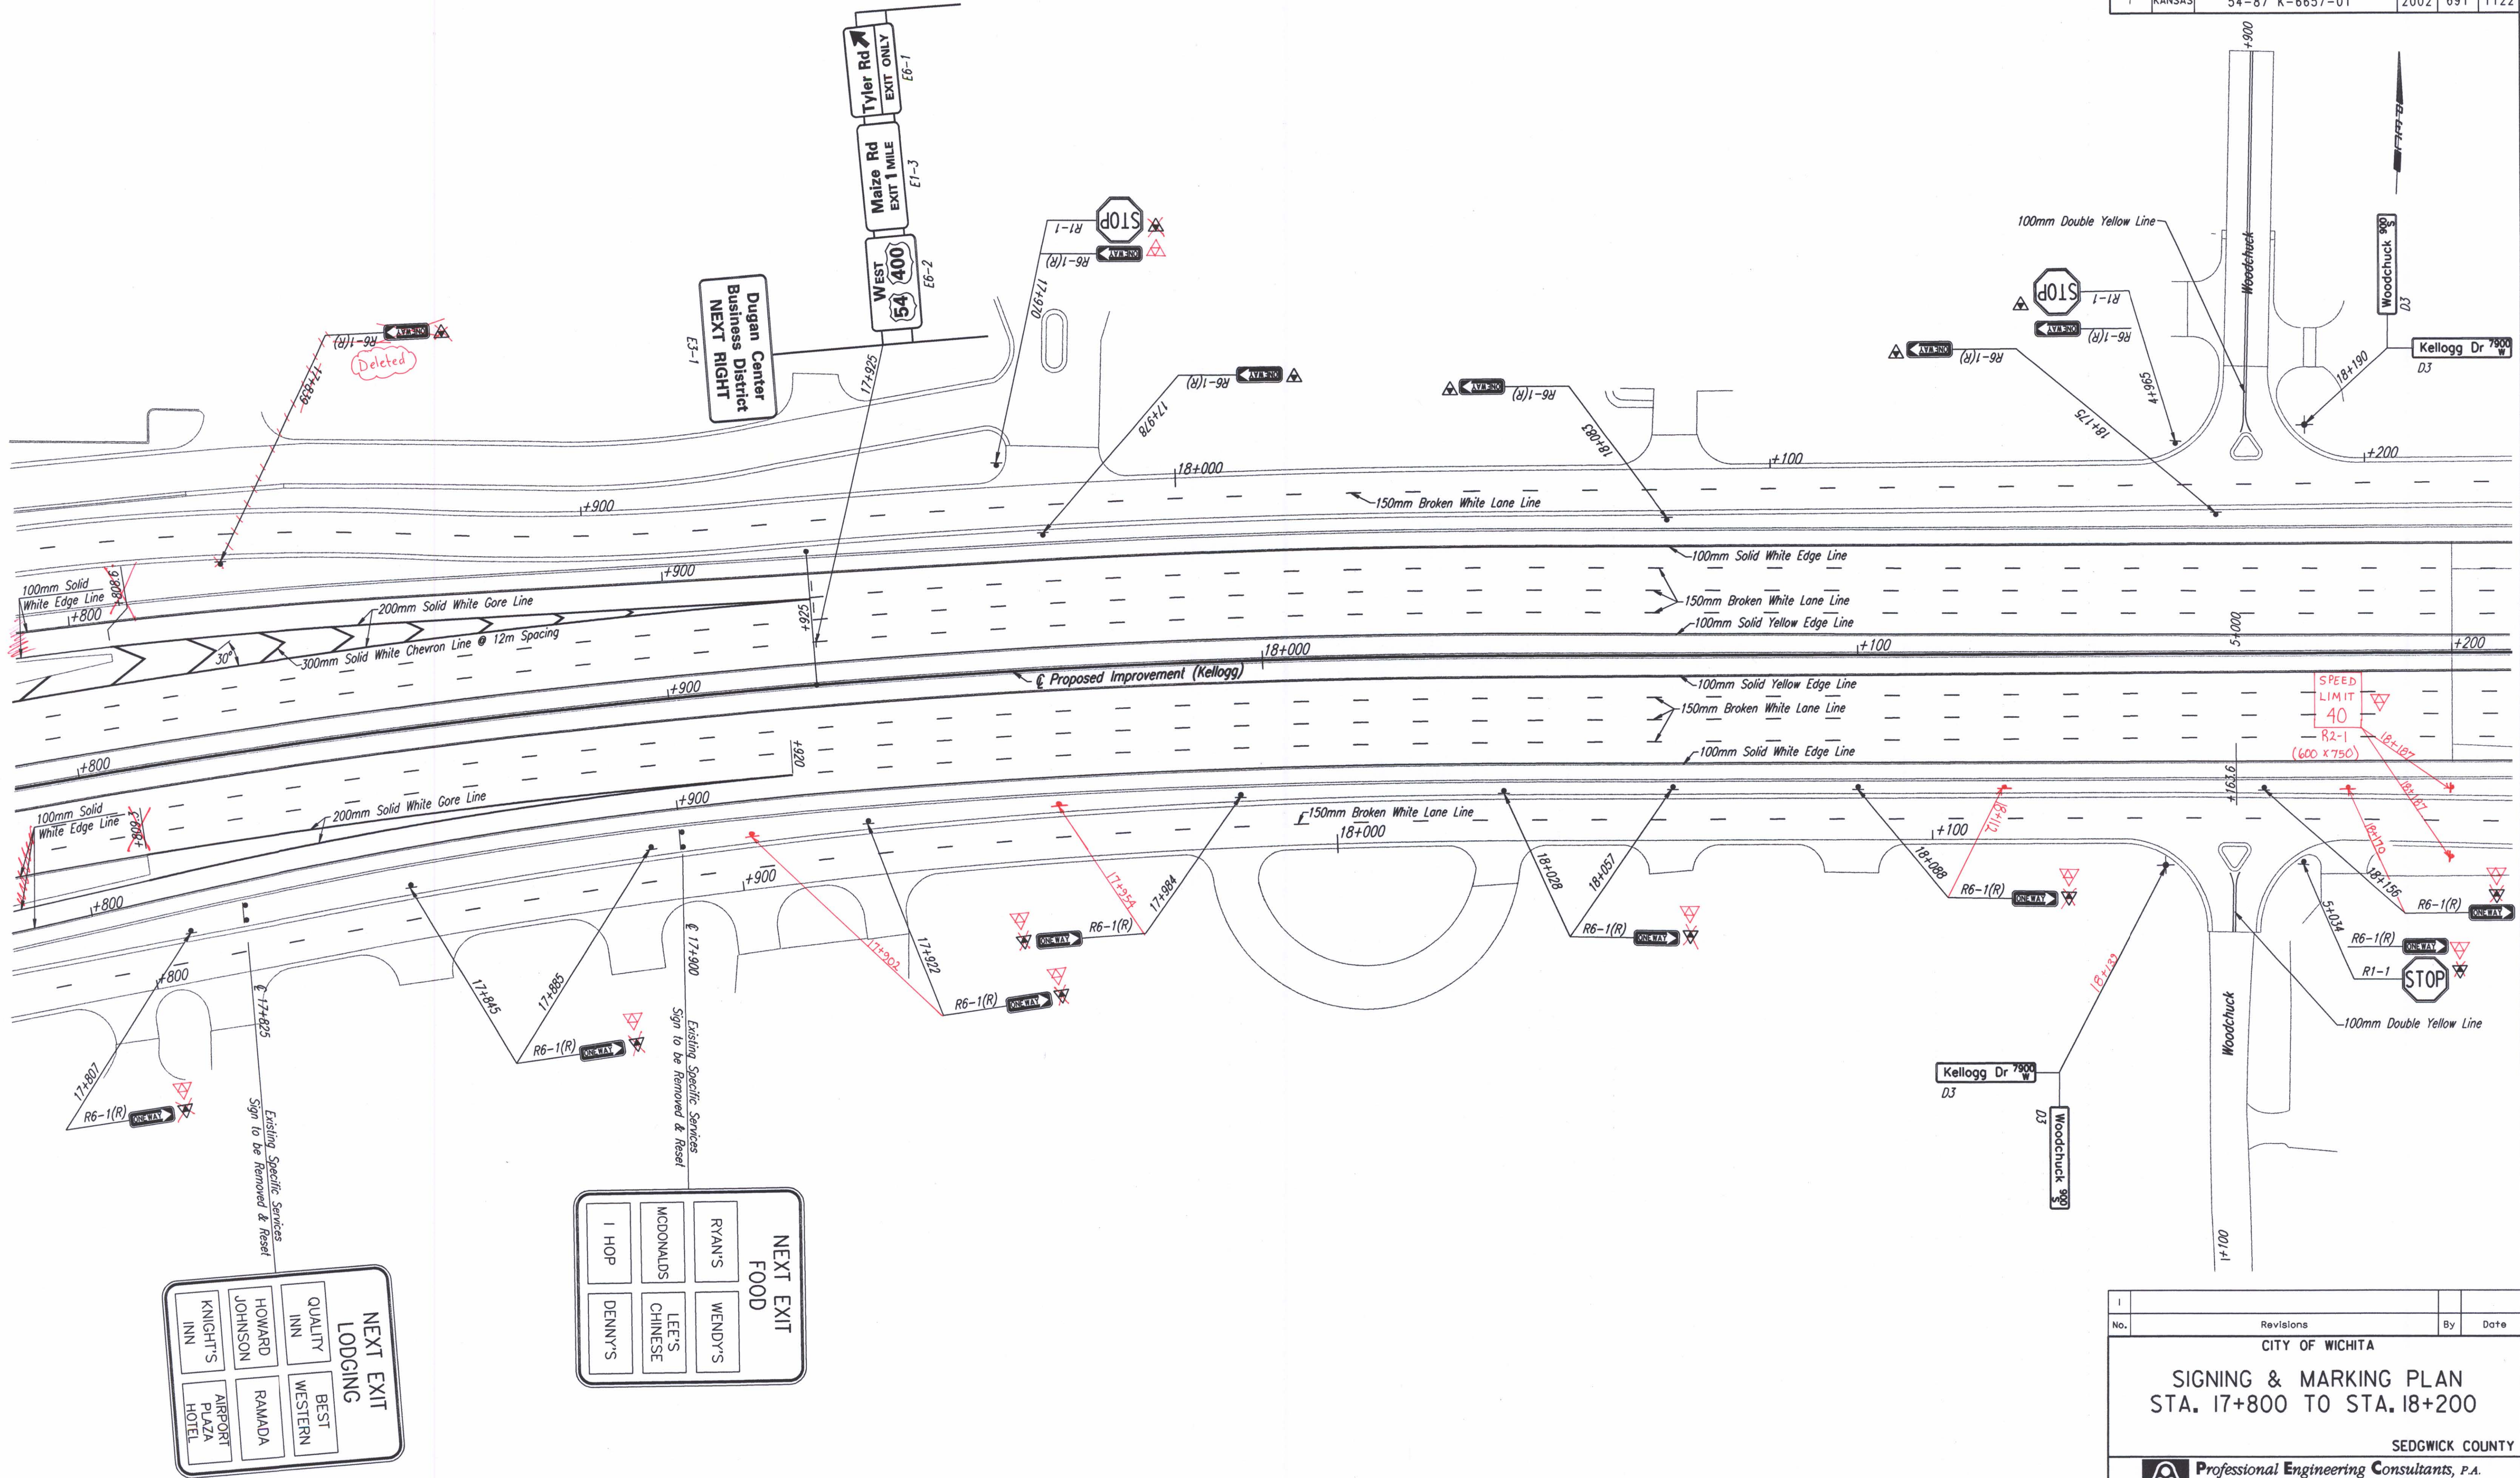

NEXT EXIT
LODGING

QUALITY INN

HOWARD JOHNSON


AIRPORT PLAZA HOTEL

BEST WESTERN

RAMADA

NEXT EXIT
FOOD

RYAN'S

WENDY'S

LEE'S CHINESE

DENNY'S

MCDONALDS

I HOP

No.		Revisions		By	Date
CITY OF WICHITA					
SIGNING & MARKING PLAN STA. 17+800 TO STA. 18+200					
SEDGWICK COUNTY					
 Professional Engineering Consultants, P.A. 303 S. TOPEKA • WICHITA, KANSAS 67202 316-262-2691 • FAX 316-262-3003					
Designed by RPG		Checked by WDH			
Drawn by SVB		Date April, 2002		Job No. 97362	