

FHWA REGION NO.	STATE	PROJECT NO.	YEAR	SHEET NO.	TOTAL SHEETS
7	KANSAS	54-87 K-6657-01	2002	696	1122

DATE	BY	REFERENCES NOTED	REFERENCES CHECKED

DSNR: WDH

OPER: JGP


SCALE: 1:500

11/1997/97362/MARKING/PL198.DGN

3-09-2001 13:53:58

LAST REV: 1-24-2002

BY: svb

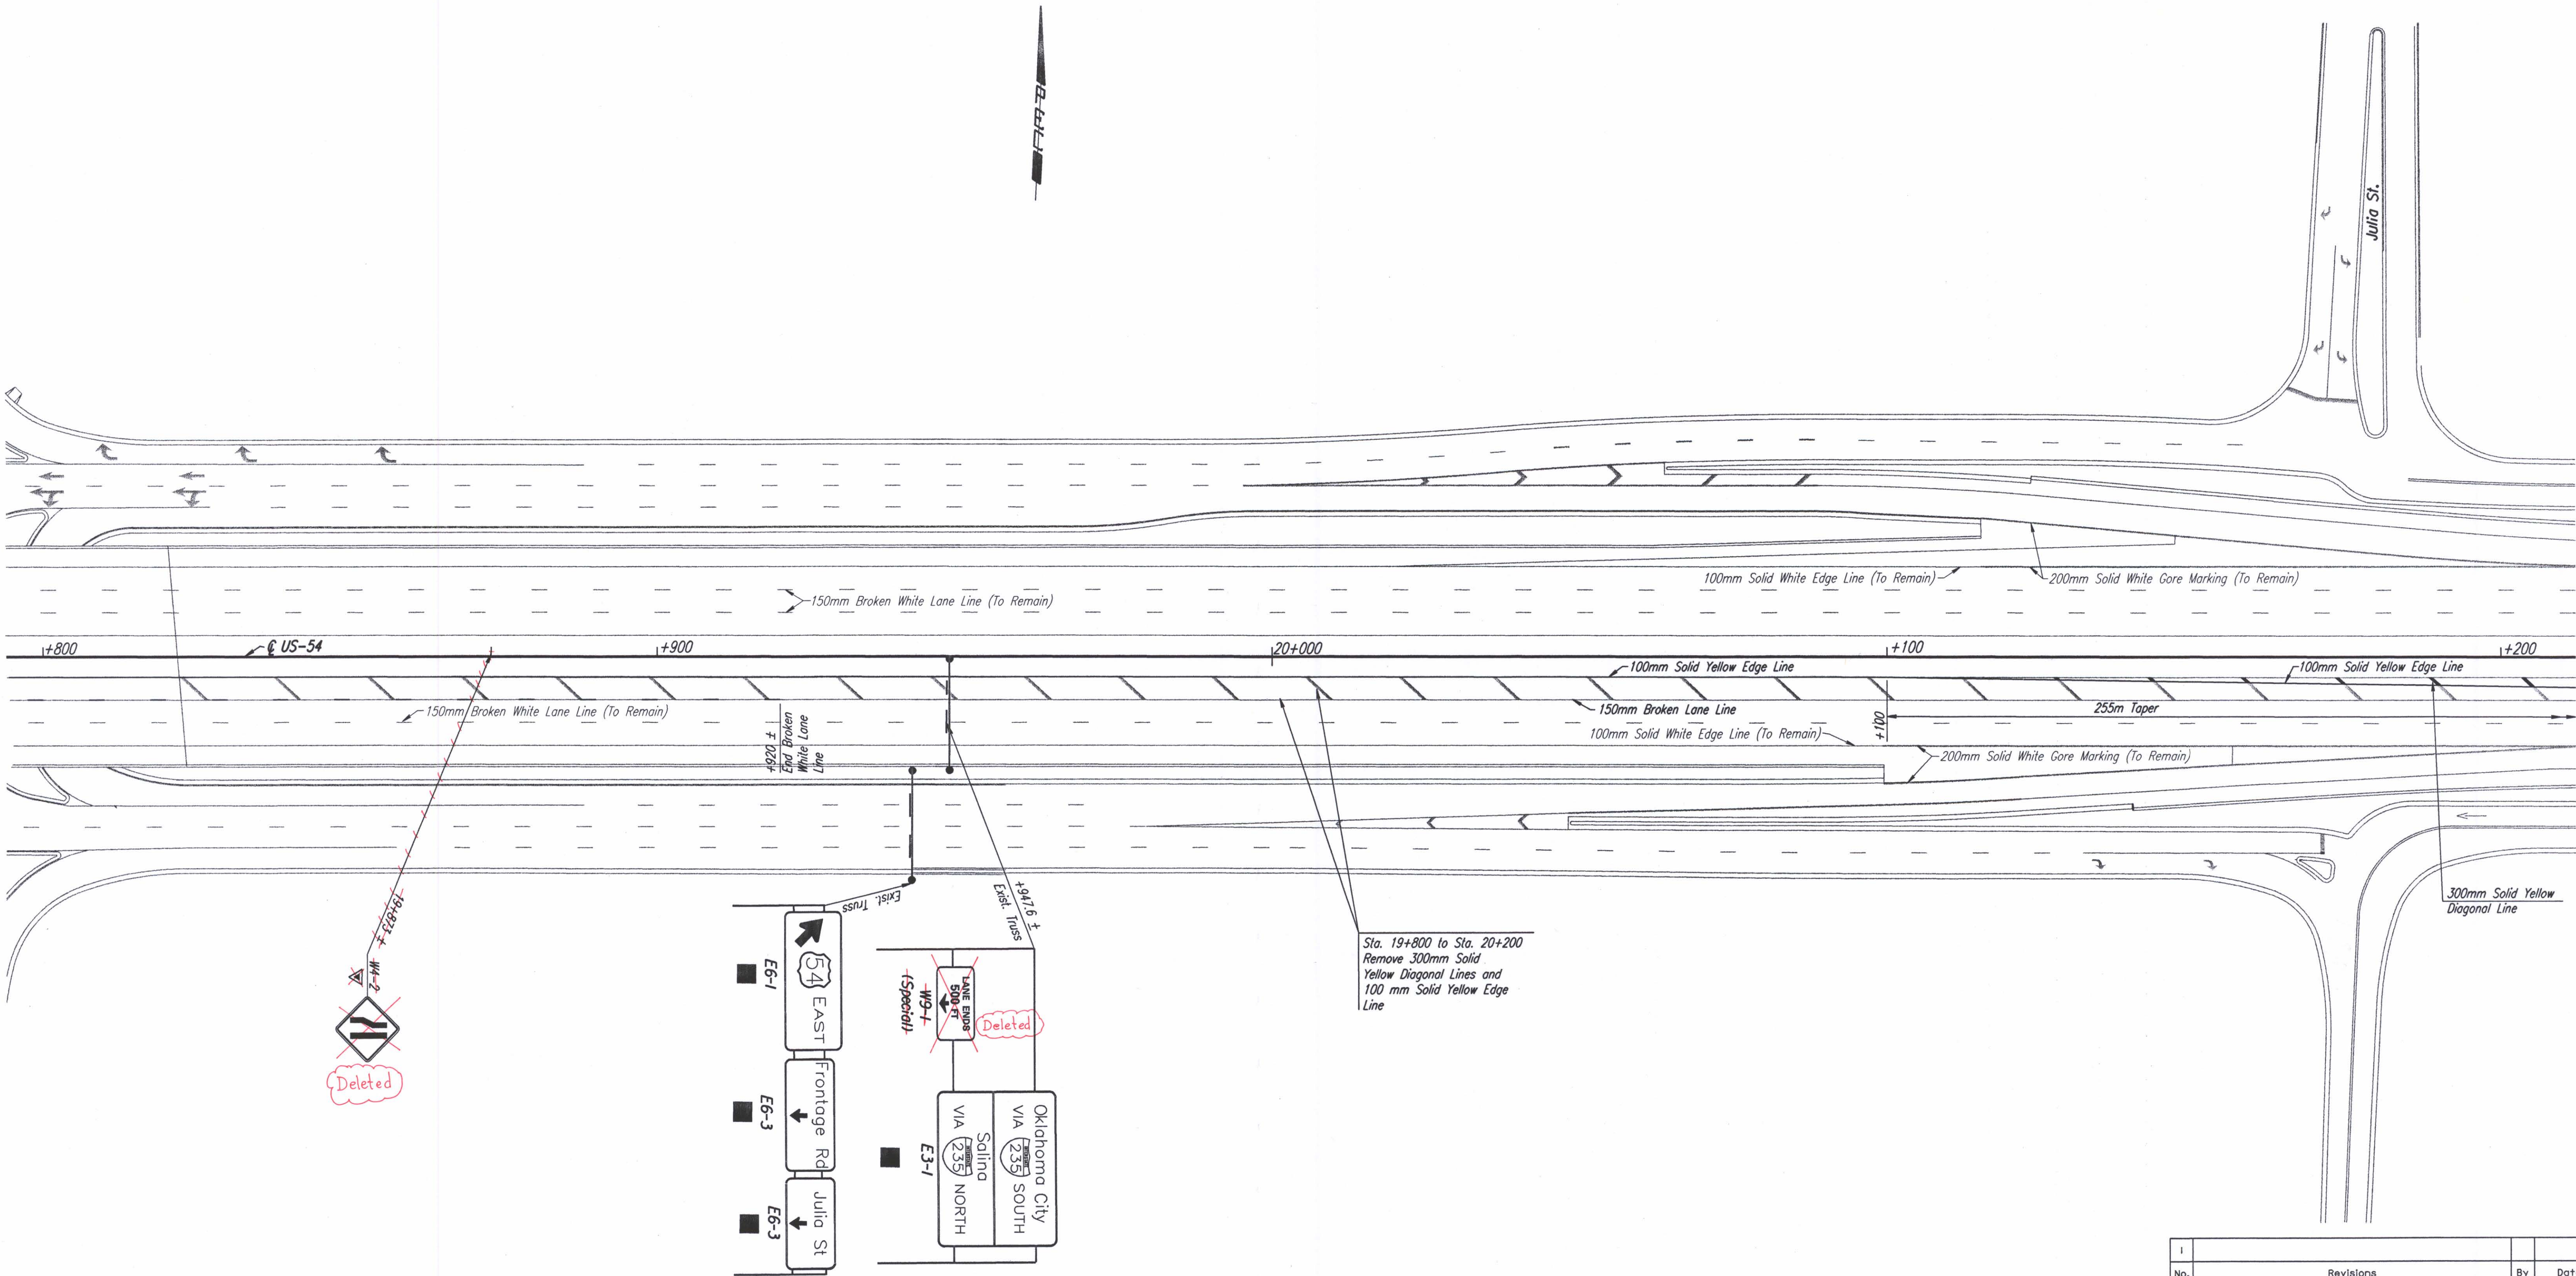

No.		Revisions		By	Date
CITY OF WICHITA					
SIGNING & MARKING PLAN STA. 19+800 TO STA. 20+200					
SEDGWICK COUNTY					
Professional Engineering Consultants, P.A. 303 S. TOPEKA • WICHITA, KANSAS 67202 316-262-2691 • FAX 316-262-3003					
Designed by	RPG	Checked by	WDH		
Drawn by	SVB	Date	April, 2002	Job No.	97362