


DATE	
BY	
REFERENCES NOTED	
REFERENCES CHECKED	

DSNR: WDH OPER: JGP SCALE: 1:500
 1/1997/97362/MARKING/MAIZE RD/PL3670.DGN 11-24-1999 14:08:23 LAST REV: 1-25-2002 BY: svb

FHWA REGION NO.	STATE	PROJECT NO.	YEAR	SHEET NO.	TOTAL SHEETS
7	KANSAS	54-87 K-6657-01	2002	698	1122


 Scale: 1:500

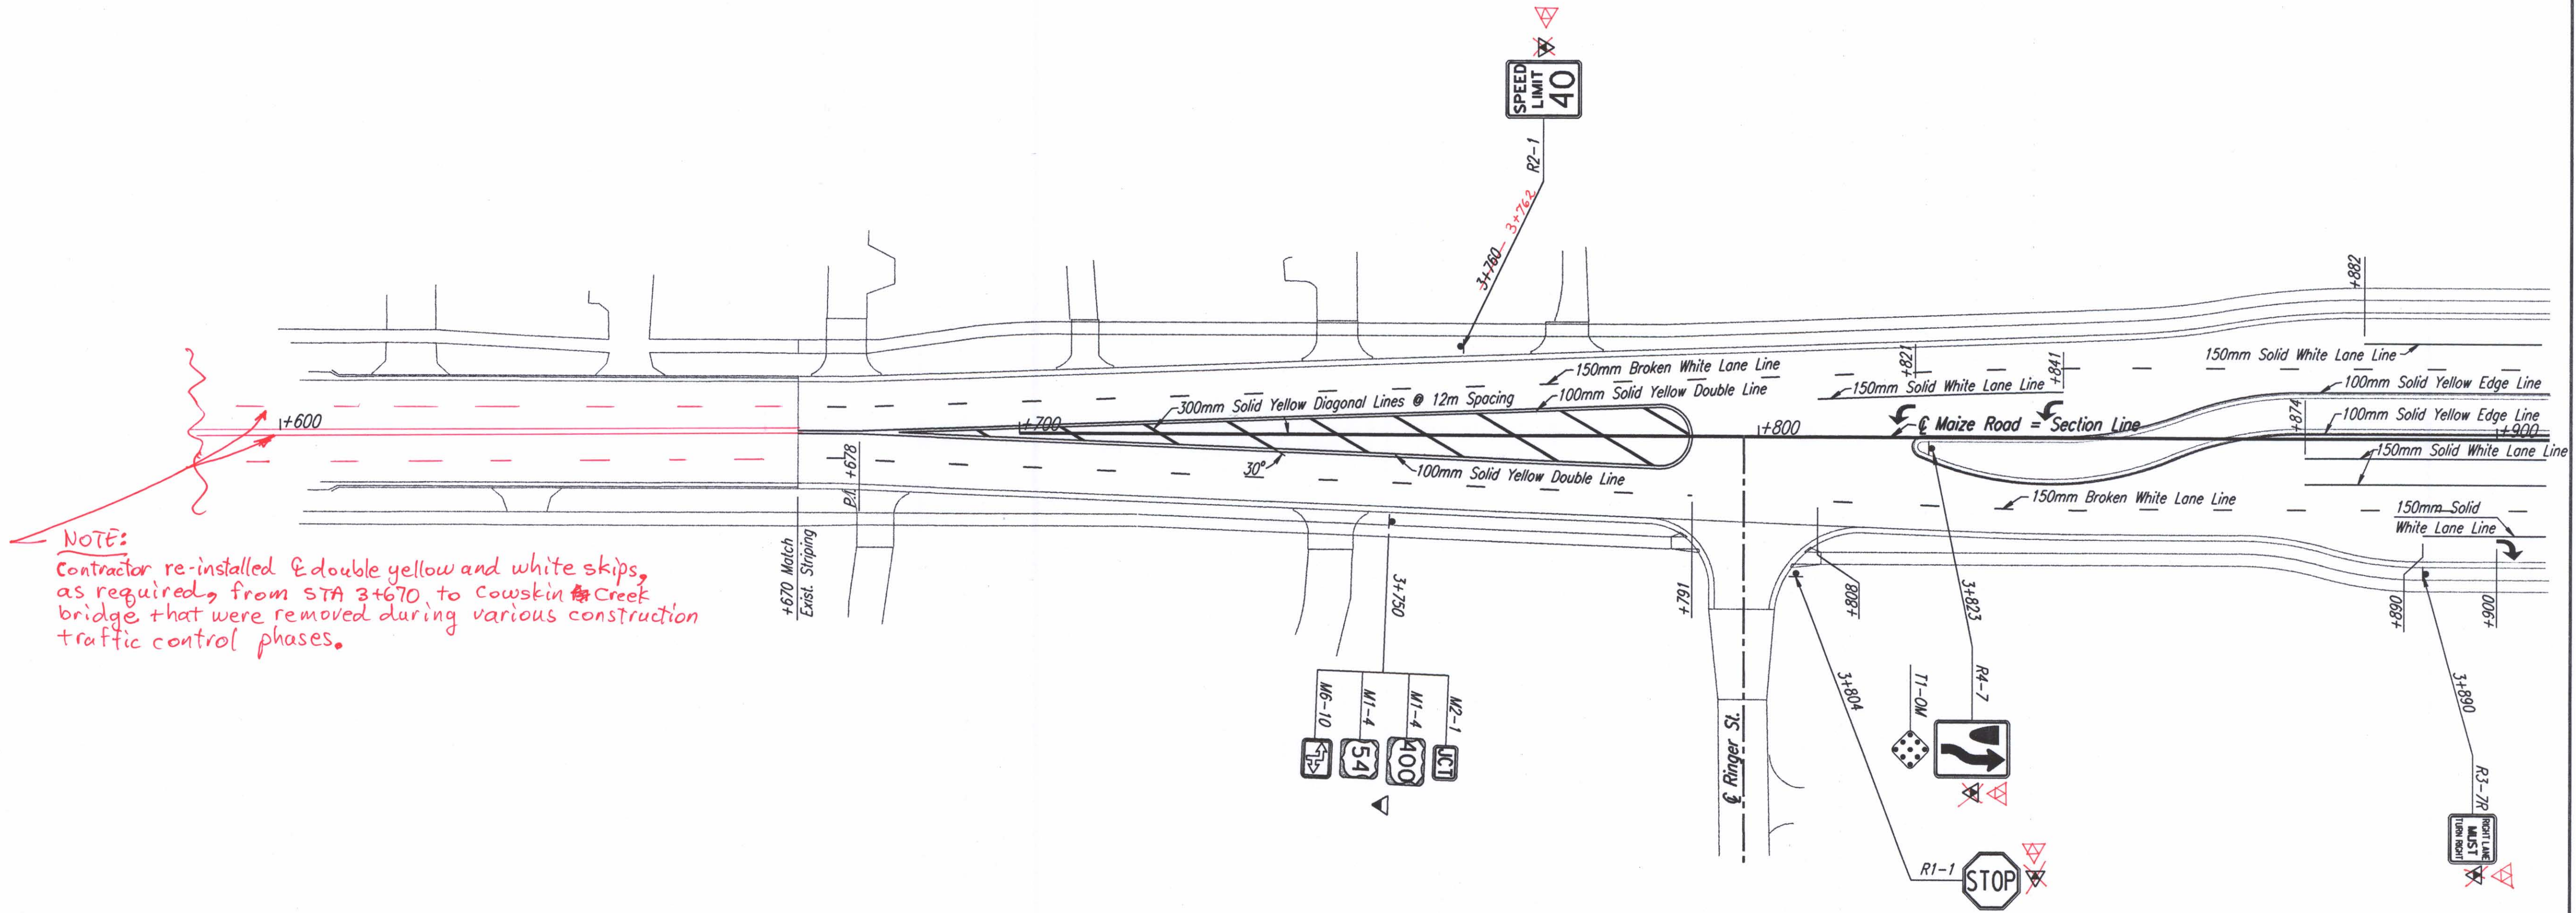

1			
No.	Revisions	By	Date
CITY OF WICHITA SIGNING & MARKING PLAN MAIZE ROAD STA. 3+670 TO STA. 3+900 SEDGWICK COUNTY			
 Professional Engineering Consultants, P.A. 303 S. TOPEKA • WICHITA, KANSAS 67202 316-262-2691 • FAX 316-262-3003			
Designed by	RPG	Checked by	WDH
Drawn by	SVB	Date	April, 2002
		Job No.	97362