


FHWA REGION NO.	STATE	PROJECT NO.	YEAR	SHEET NO.	TOTAL SHEETS
7	KANSAS	54-87 K-6657-01	2002	700	1122

REFERENCES NOTED	BY	DATE
REFERENCES CHECKED		

DSNR: WDH OPER: JGP SCALE: 1:500
I:/1997/97362/MARKING/MAIZE RD/PL4300.DGN 11-24-1999 13:51:20 LAST REV: 1-25-2002 BY: svb

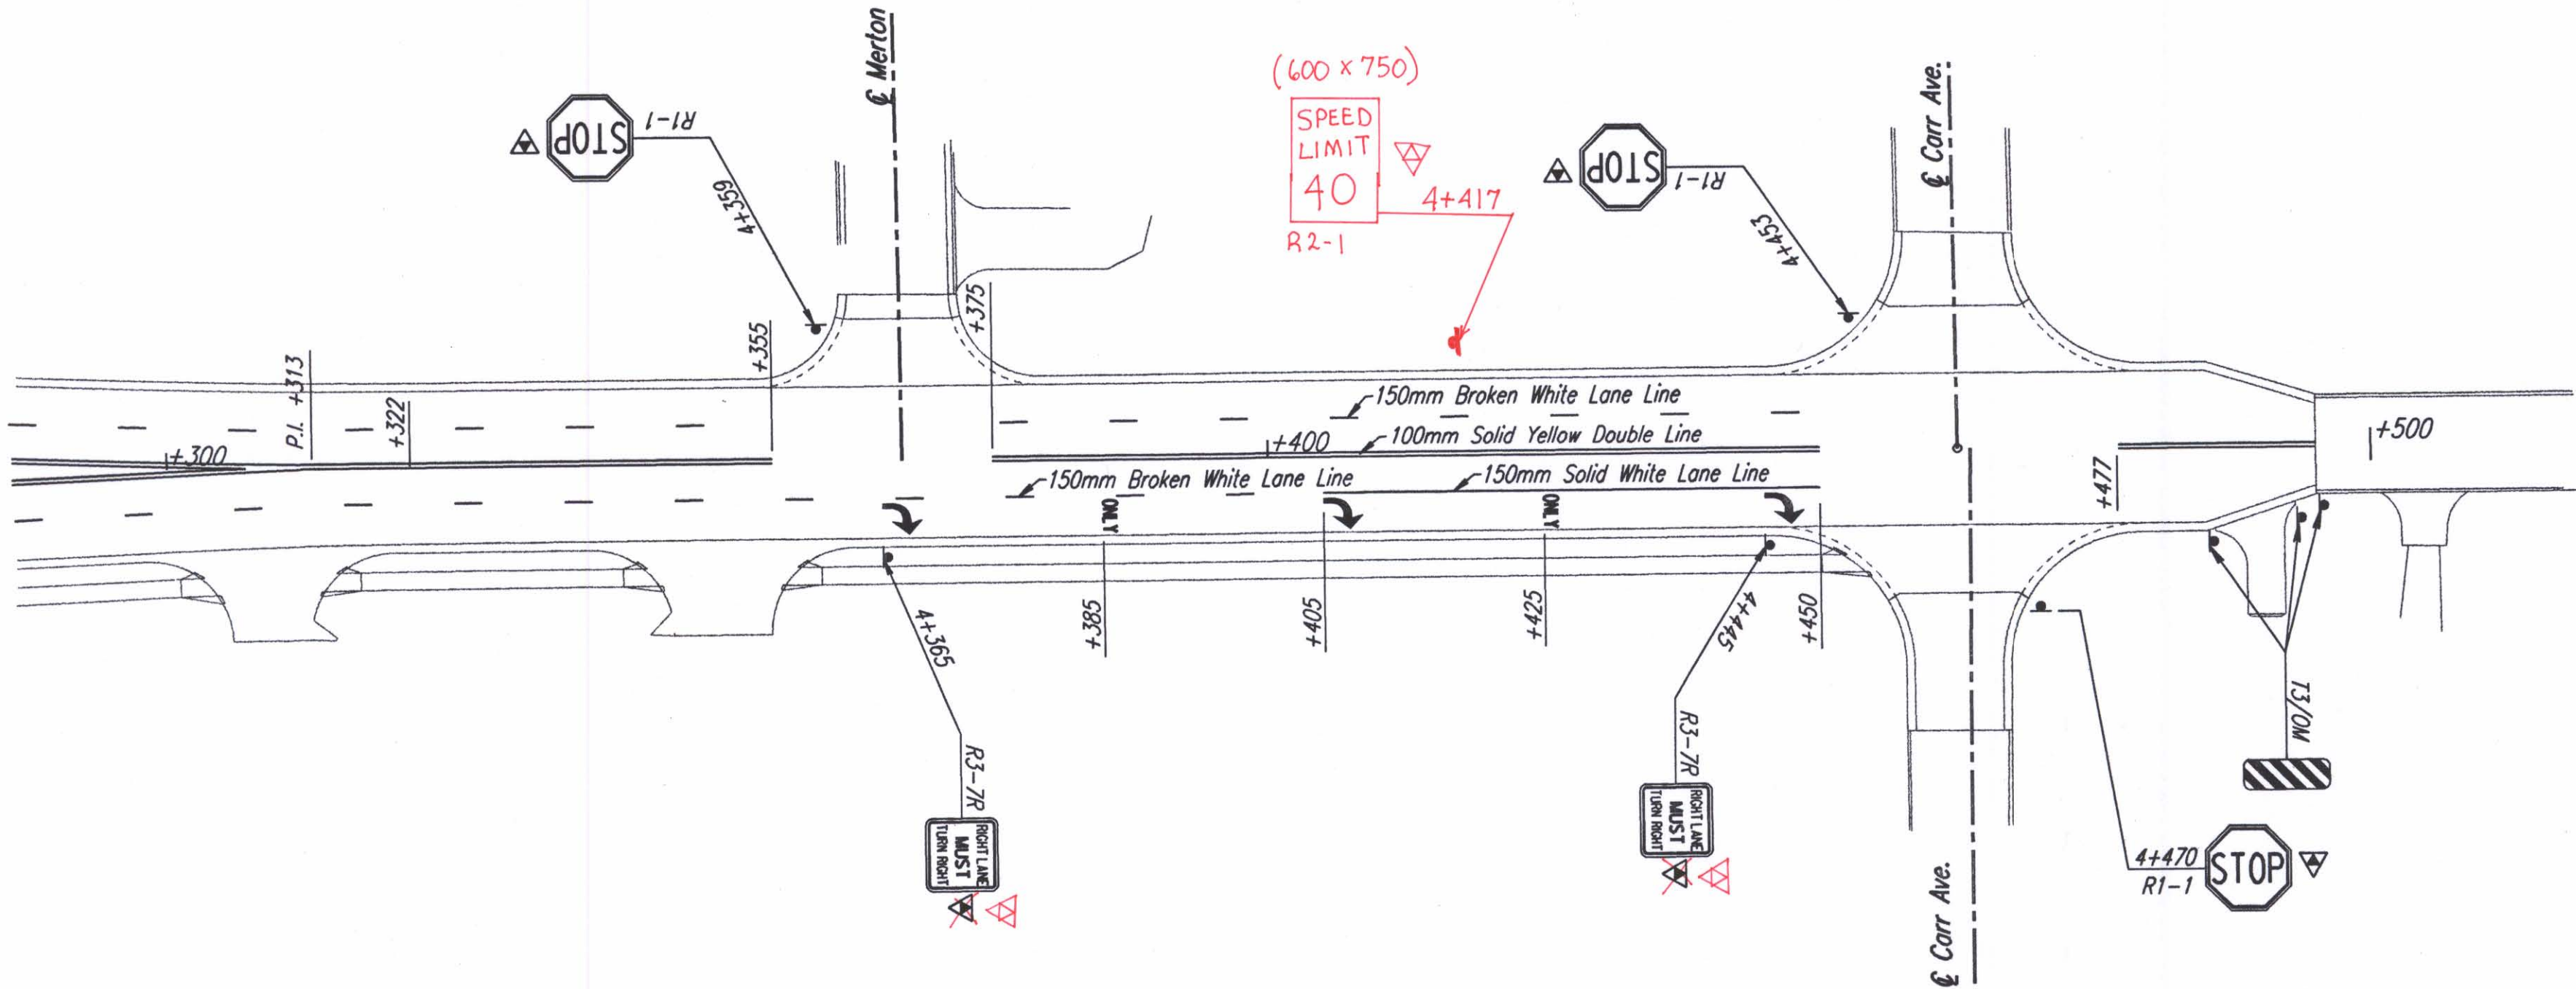

I			
No.	Revisions	By	Date
CITY OF WICHITA			
SIGNING & MARKING PLAN			
MAIZE ROAD			
STA. 4+300 TO STA. 4+495			
SEDGWICK COUNTY			
 Professional Engineering Consultants, P.A. 303 S. TOPEKA • WICHITA, KANSAS 67202 316-262-2691 • FAX 316-262-3003			
Designed by	RPG	Checked by	WDH
Drawn by	SVB	Date April, 2002	Job No. 97362