


DATE	BY
REFERENCES NOTED	REFERENCES CHECKED

DSNR: RCH OPER: JGP SCALE: 1:500
 1/1997/97362/MARKING/TYLER RD/PL4700.DGN 10-27-1999 13:33:08 LAST REV: 1-25-2002 BY: svb

FHWA REGION NO.	STATE	PROJECT NO.	YEAR	SHEET NO.	TOTAL SHEETS
7	KANSAS	54-87 K-6657-01	2002	701	1122

Scale: 1:500

REVISED
SHEET # 701 R1

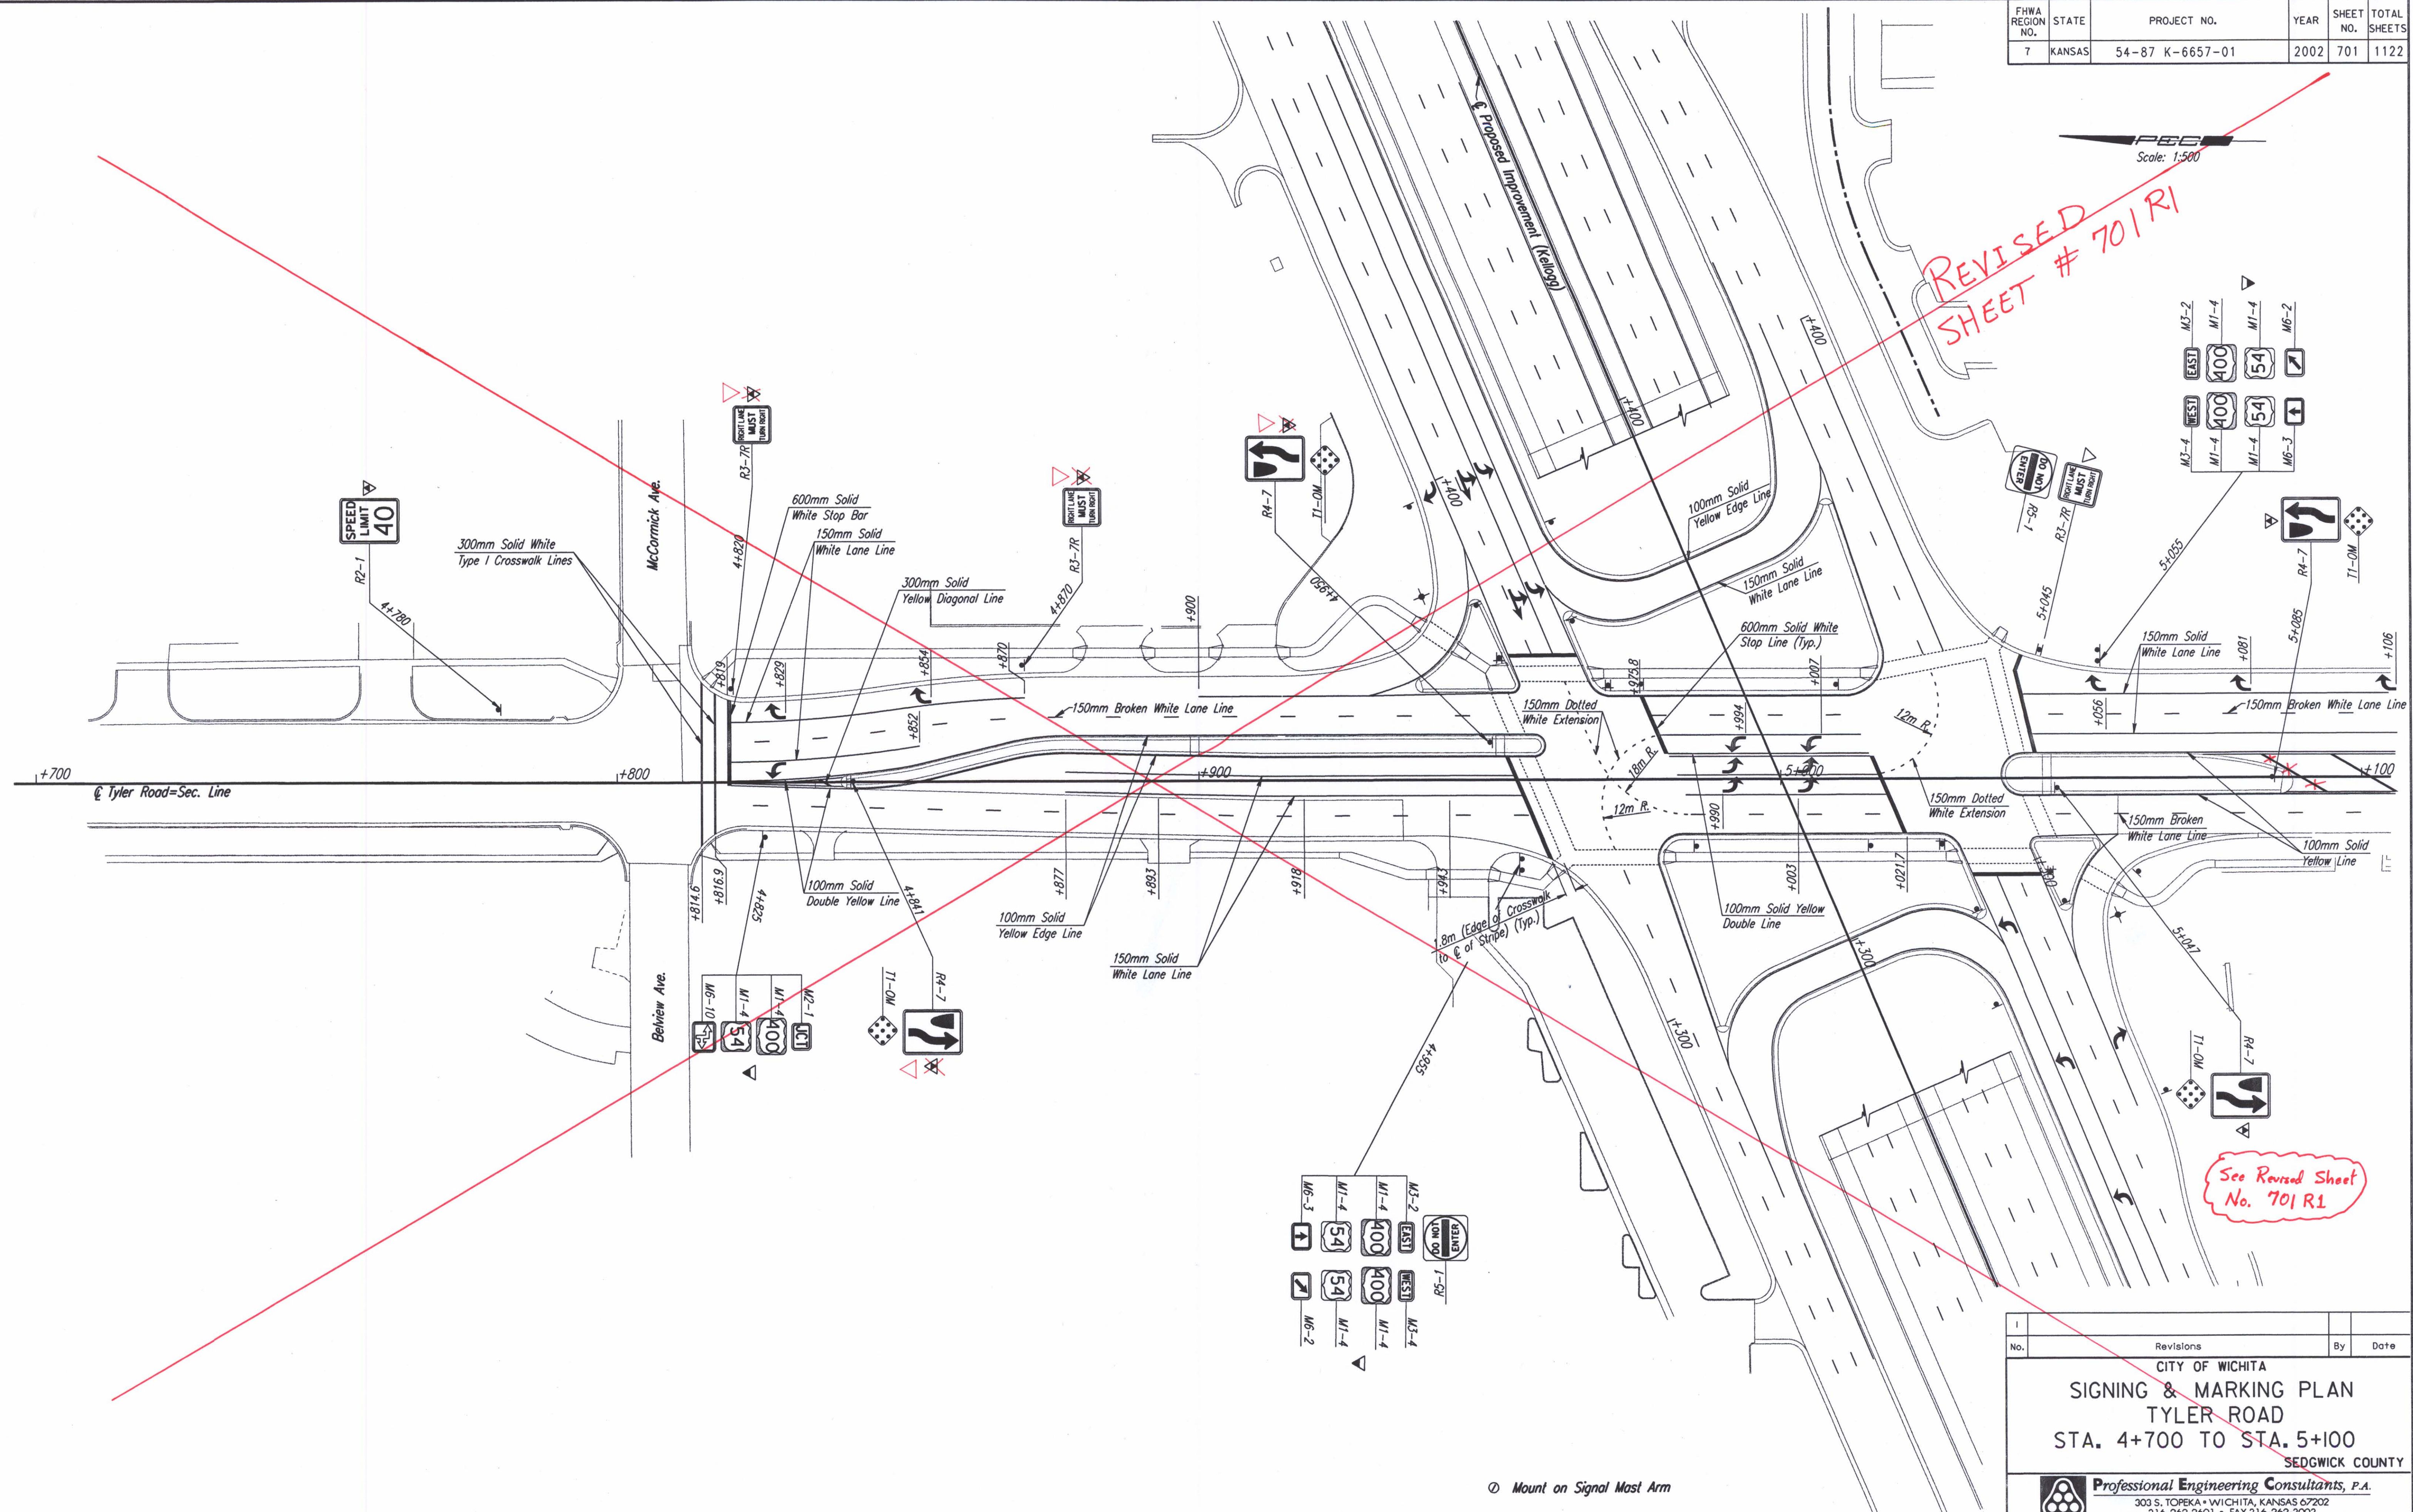

See Revised Sheet No. 701 R1

① Mount on Signal Mast Arm

No.	Revisions	By	Date
CITY OF WICHITA			
SIGNING & MARKING PLAN			
TYLER ROAD			
STA. 4+700 TO STA. 5+100			
SEDGWICK COUNTY			
Professional Engineering Consultants, P.A.			
303 S. TOPEKA • WICHITA, KANSAS 67202			
316-262-2691 • FAX 316-262-3003			
Designed by	RPG	checked by	WDH
Drawn by	SVB	Date	April, 2002
		Job No.	97362