


REFERENCES NOTED	BY	DATE
REFERENCES CHECKED		

DSNR: RCH OPER: JGP SCALE: 1:500
 I:/1997/97362/MARKING/TYLER RD/McCormickSEReturnRevised.DGN 5-5-2004 14:16:08 LAST REV: 5-5-2004 BY: CKC

FHWA REGION NO.	STATE	PROJECT NO.	YEAR	SHEET NO.	TOTAL SHEETS
7	KANSAS	54-87 K-6657-01	2002	701R1	1122

Scale: 1:500

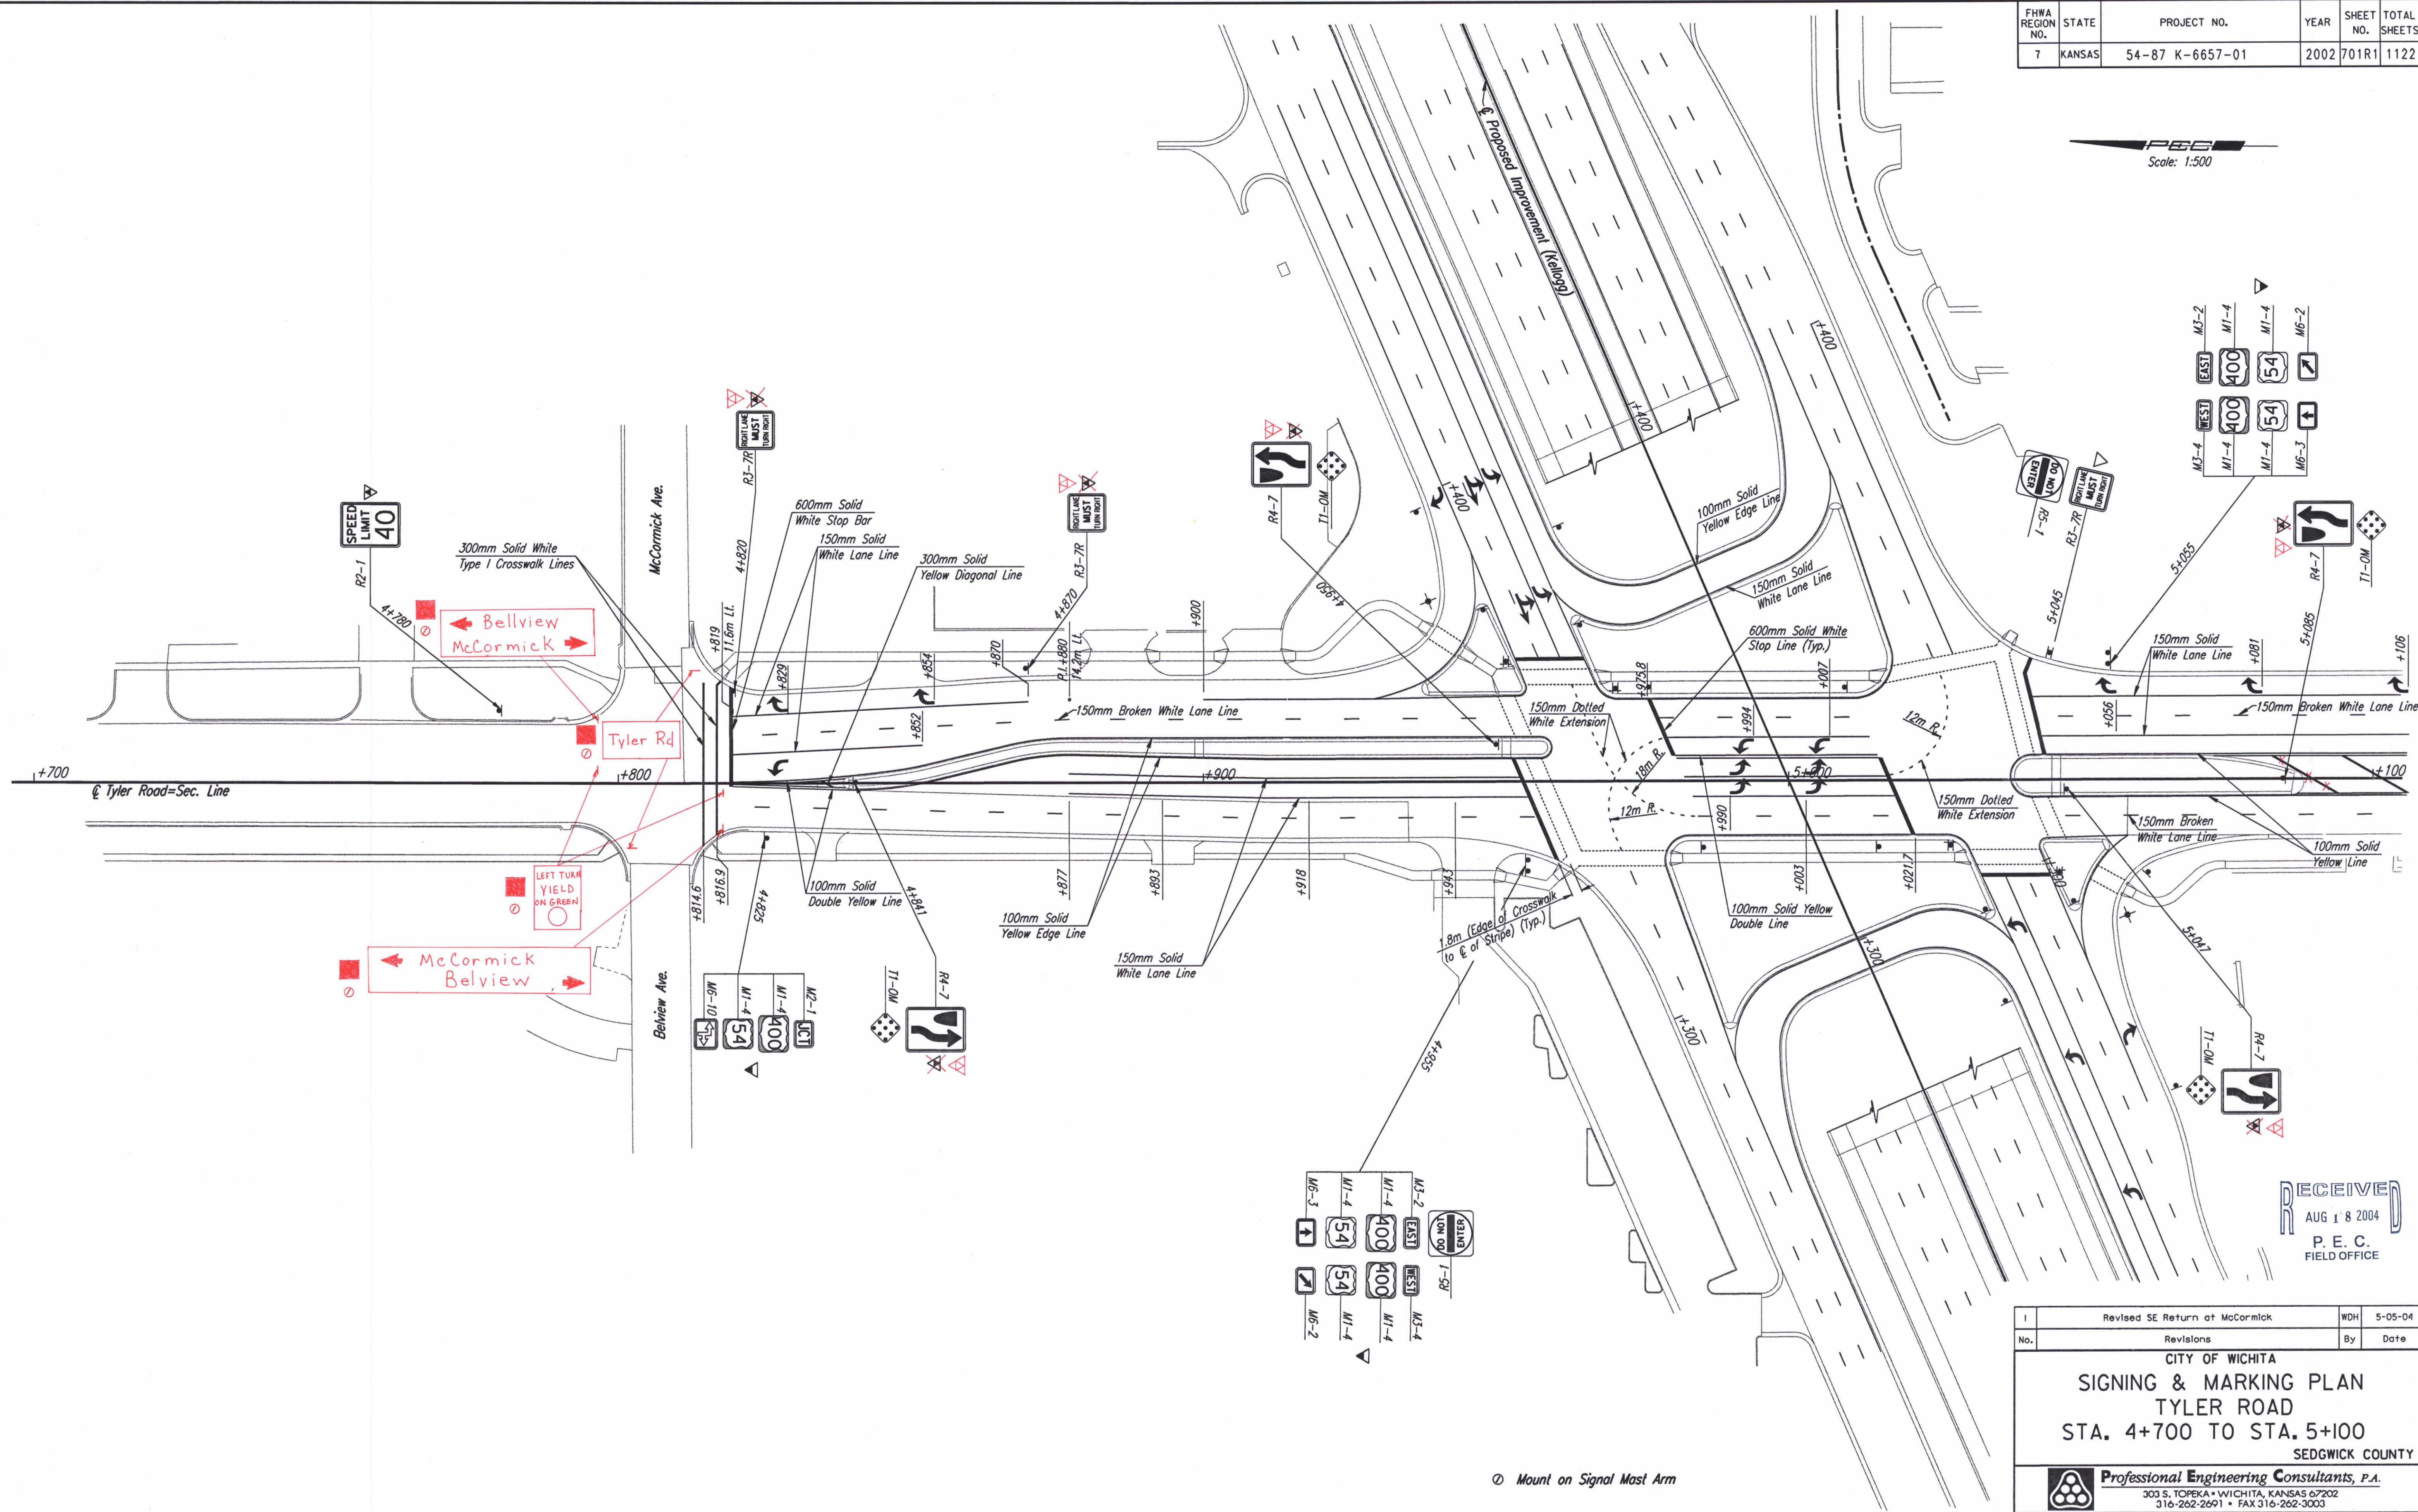

⊙ Mount on Signal Mast Arm

RECEIVED
 AUG 18 2004
 P. E. C.
 FIELD OFFICE

1	Revised SE Return at McCormick	WDH	5-05-04
No.	Revisions	By	Date
CITY OF WICHITA			
SIGNING & MARKING PLAN			
TYLER ROAD			
STA. 4+700 TO STA. 5+100			
SEDGWICK COUNTY			
Professional Engineering Consultants, P.A.			
303 S. TOPEKA • WICHITA, KANSAS 67202			
316-262-2691 • FAX 316-262-3003			
Designed by	RPG	Checked by	WDH
Drawn by	SVB	Date	April, 2002
		Job No.	97362