


REFERENCES NOTED	BY	DATE
REFERENCES CHECKED		

DSNR: RCH OPER: JGP SCALE: 1:500
 1-/1997/97362/MARKING/TYLER RD/PL5100.DGN 8-31-2000 13:35:03 LAST REV: 1-25-2002 BY: svb

FHWA REGION NO.	STATE	PROJECT NO.	YEAR	SHEET NO.	TOTAL SHEETS
7	KANSAS	54-87 K-6657-01	2002	702	1122

Scale: 1:500

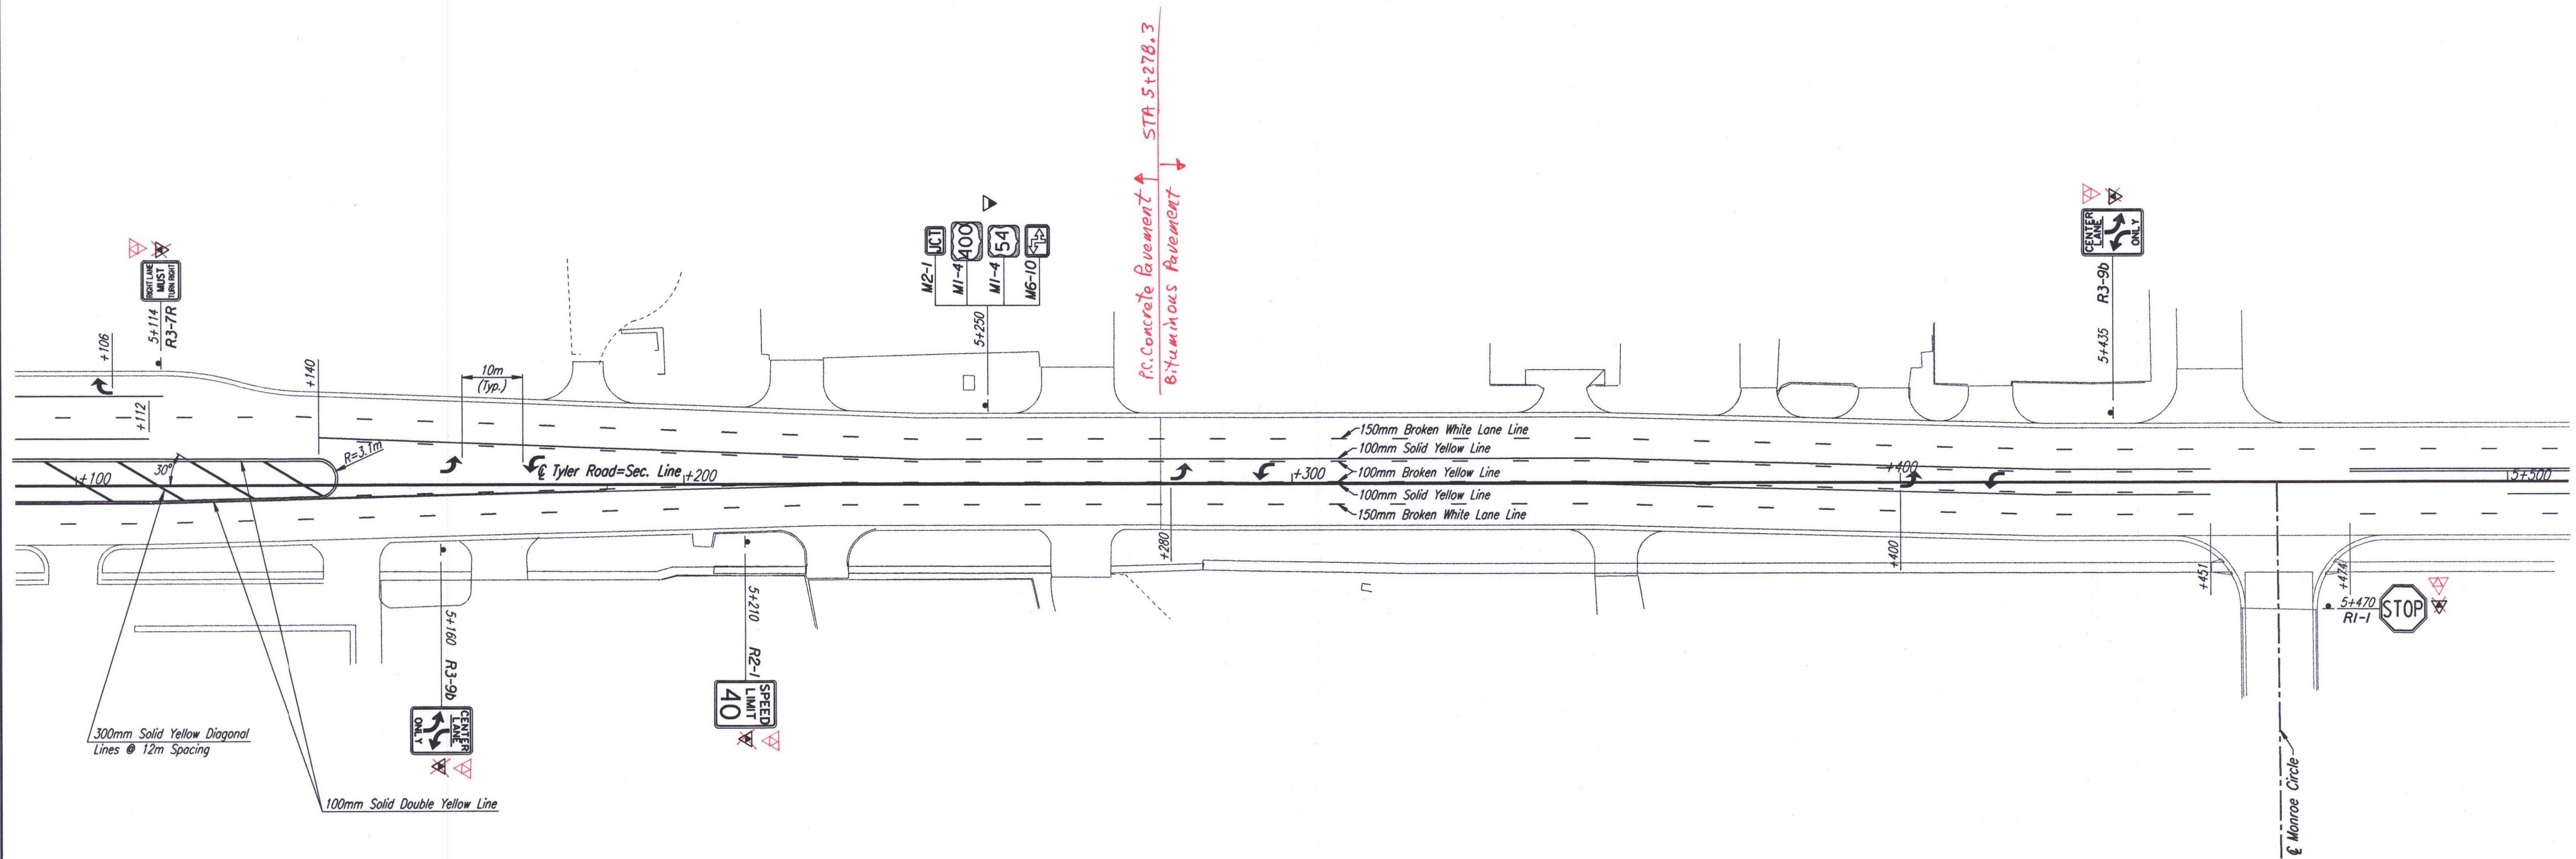

No.	Revisions	By	Date

CITY OF WICHITA

SIGNING & MARKING PLAN

TYLER ROAD

STA. 5+100 TO STA. 5+500

SEDGWICK COUNTY

Professional Engineering Consultants, P.A.

303 S. TOPEKA • WICHITA, KANSAS 67202
 316-262-2691 • FAX 316-262-3003

Designed by: RPG Checked by: WDH
 Drawn by: SVB Date: April, 2002 Job No. 97362