


FHWA REGION NO.	STATE	PROJECT NO.	YEAR	SHEET NO.	TOTAL SHEETS
7	KANSAS	54-87 K-6657-01	2002	703	1122

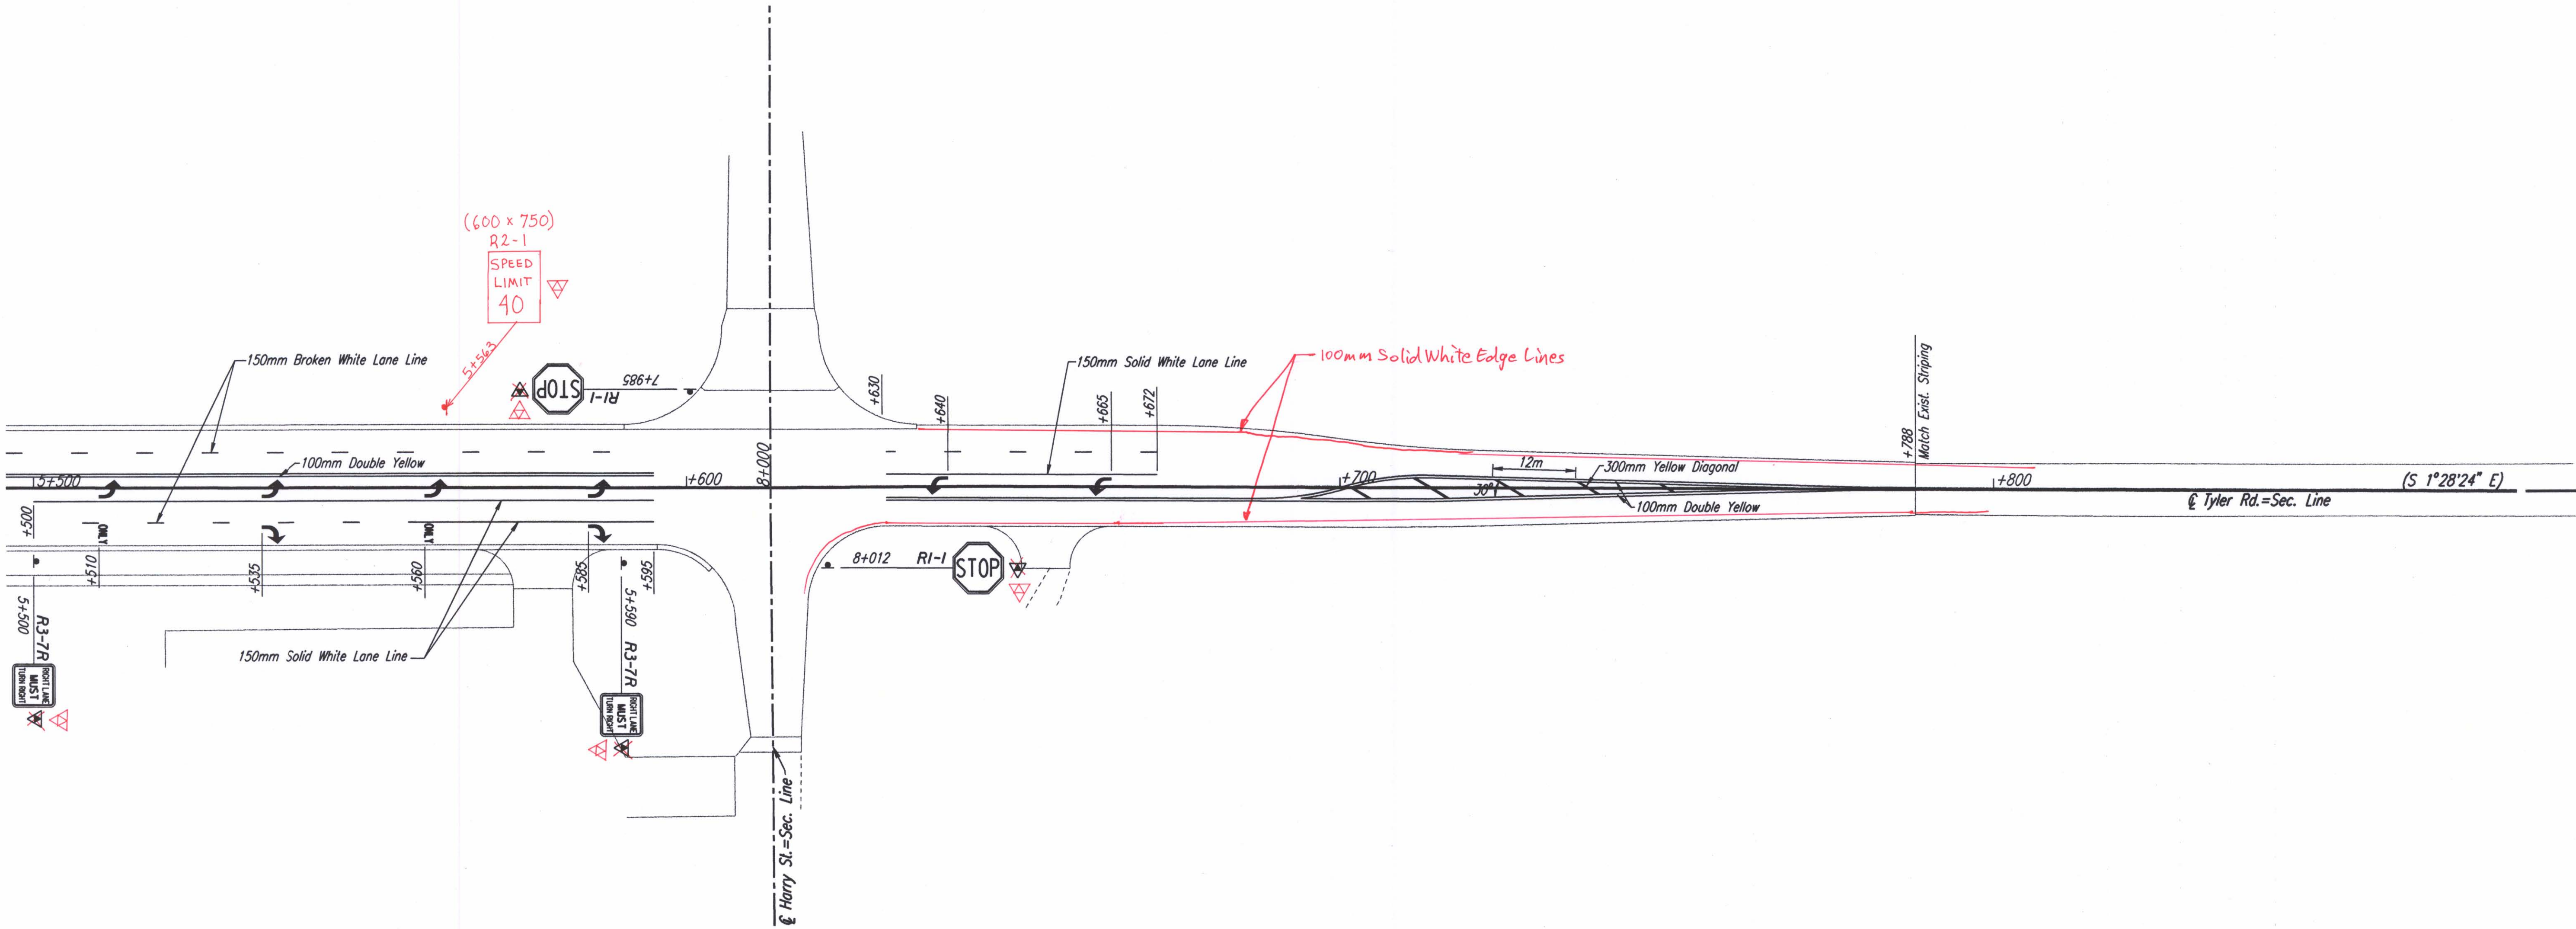

DATE	BY	REFERENCES NOTED	REFERENCES CHECKED



DSNR: RCH OPER: JGP SCALE: 1:500
I:/1997/97362/MARKING/TYLER RD/PL5500.DGN 10-27-1999 13:36:33 LAST REV: 1-25-2002 BY: svb

No.	Revisions	By	Date

CITY OF WICHITA

SIGNING & MARKING PLAN

TYLER ROAD

STA. 5+500 TO STA. 5+800

SEDGWICK COUNTY

Professional Engineering Consultants, P.A.

303 S. TOPEKA • WICHITA, KANSAS 67202

316-262-2691 • FAX 316-262-3003

Designed by	RPG	Checked by	WDH
Drawn by	SVB	Date	April, 2002
		Job No.	97362