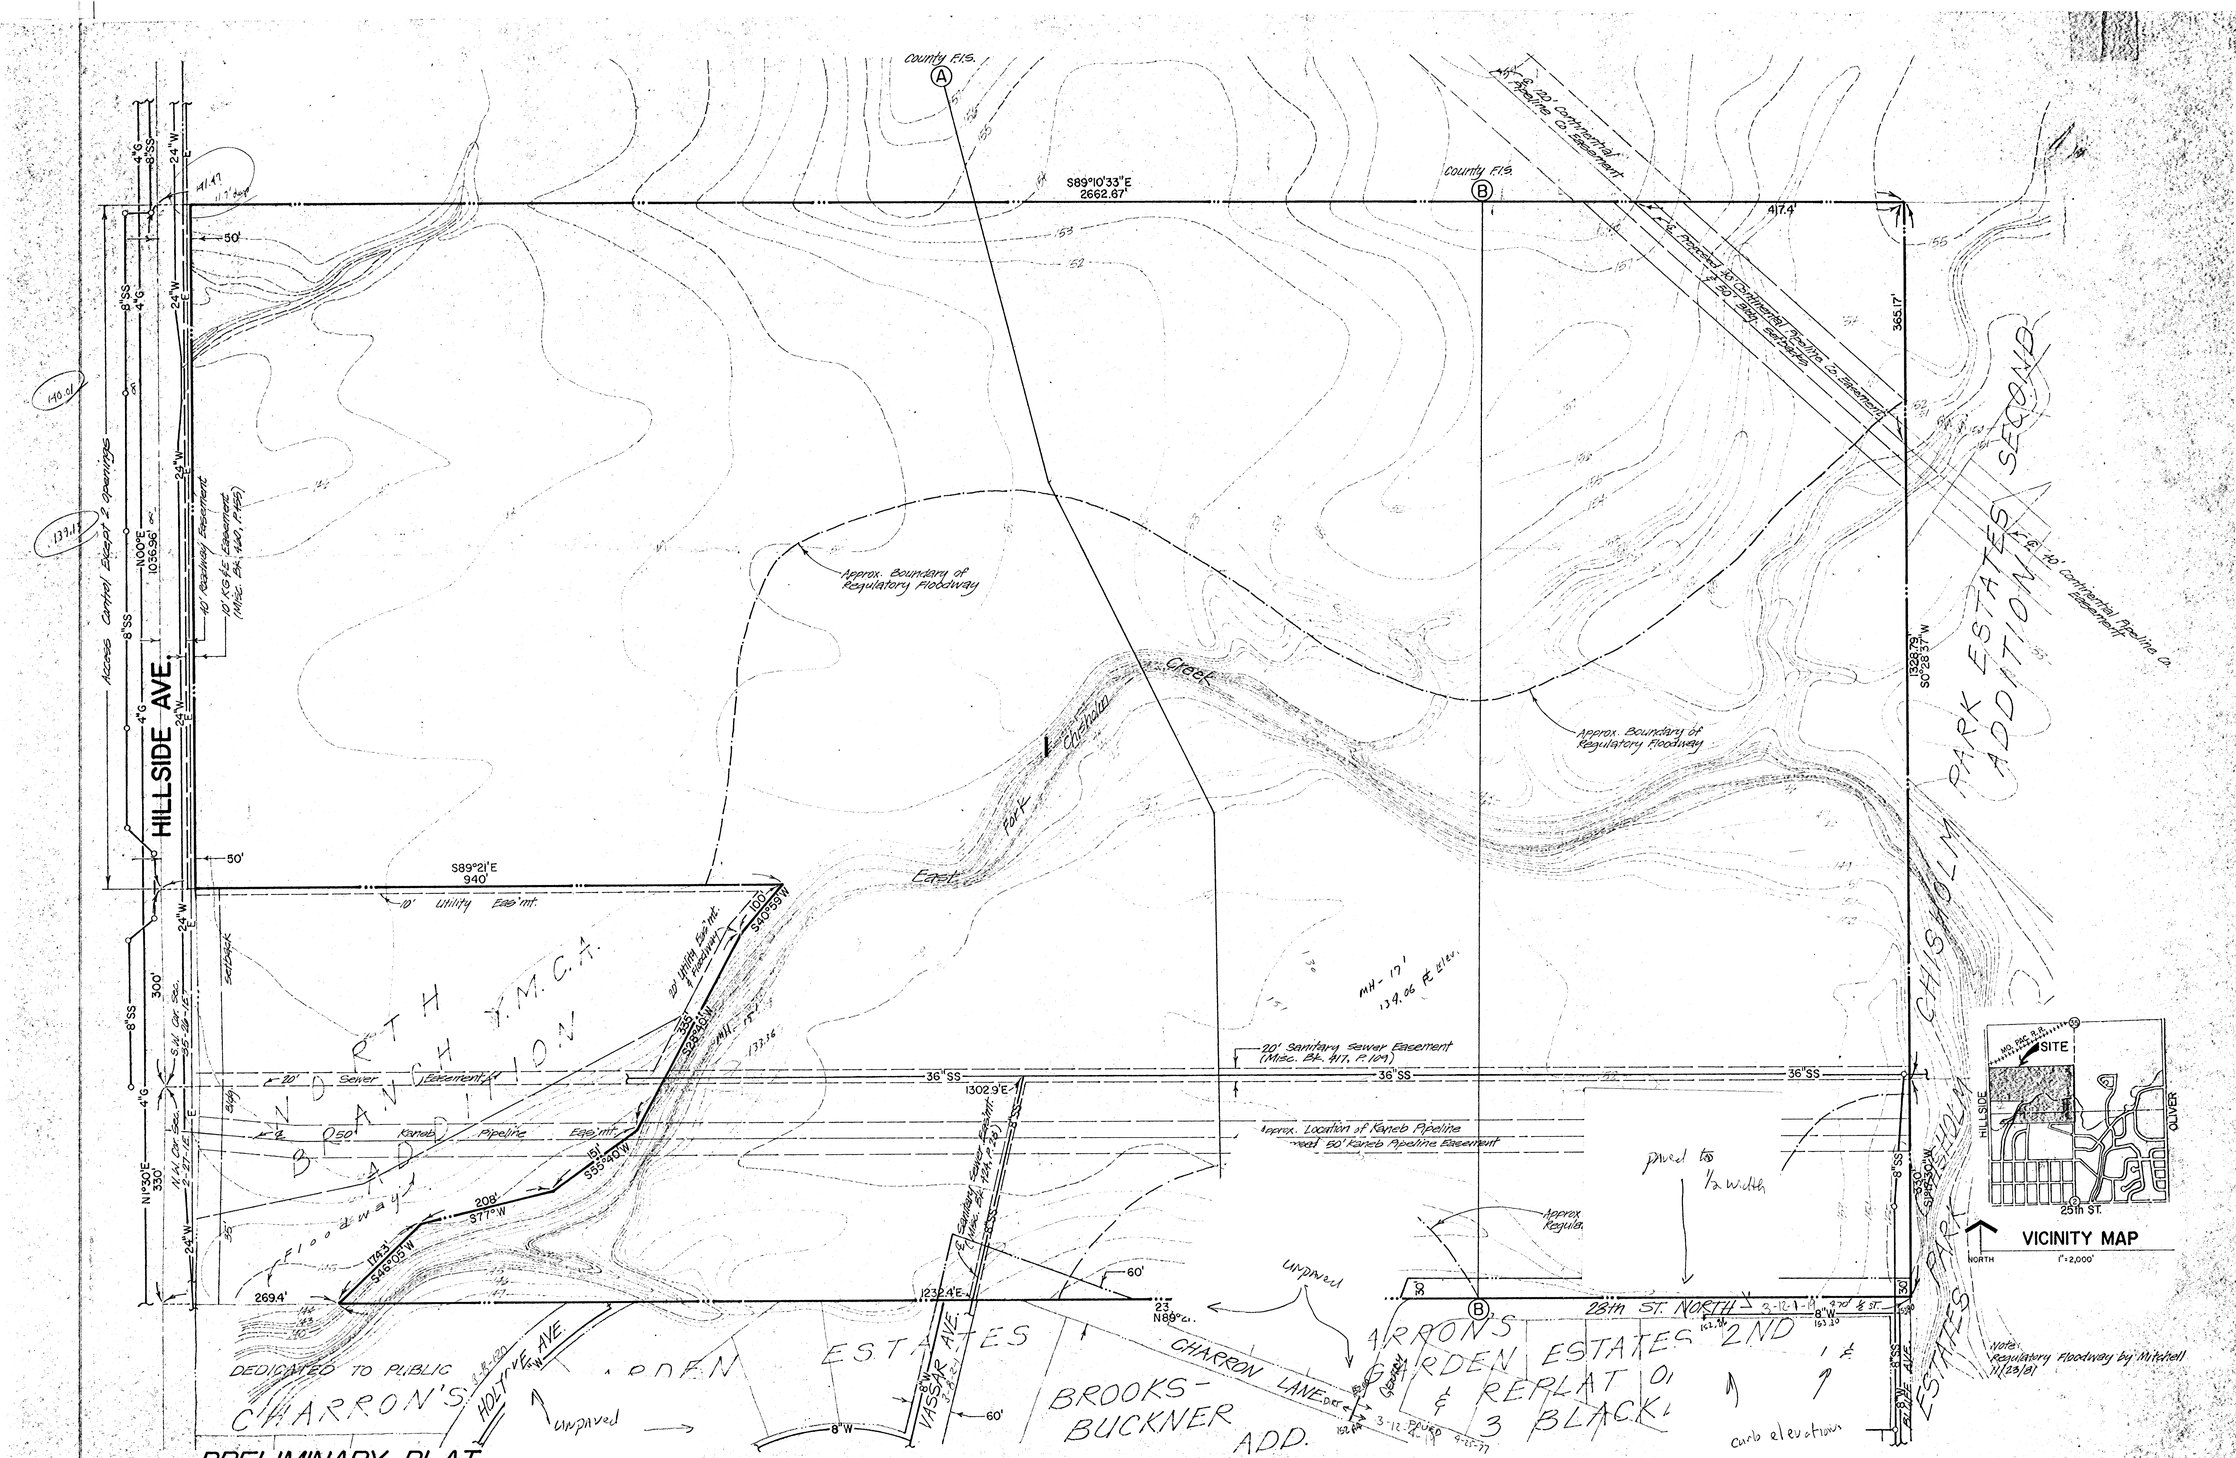

PRELIMINARY PLAT

CHISHOLI EEK CENTER ADDITION

PLANNING DEVELOPMENT SERVICES, INC.
625 First National Bank Bldg., Wichita, Kans. 67202 USA 316-262-0451 Telex 417-375 POS WIC

OWNER / SUBDIVIDER:
THE OLIVE W. GARVEY CENTER FOR THE IMPROVEMENT OF HUMAN FUNCTIONING, INC.

DRAWN B.W.H.
CHECKED J.D.G.
REVISED

SHEET 1 OF ONE