# ONE KELLOGG PLACE 2ND ADDITION

## CITY OF WICHITA, KANSAS

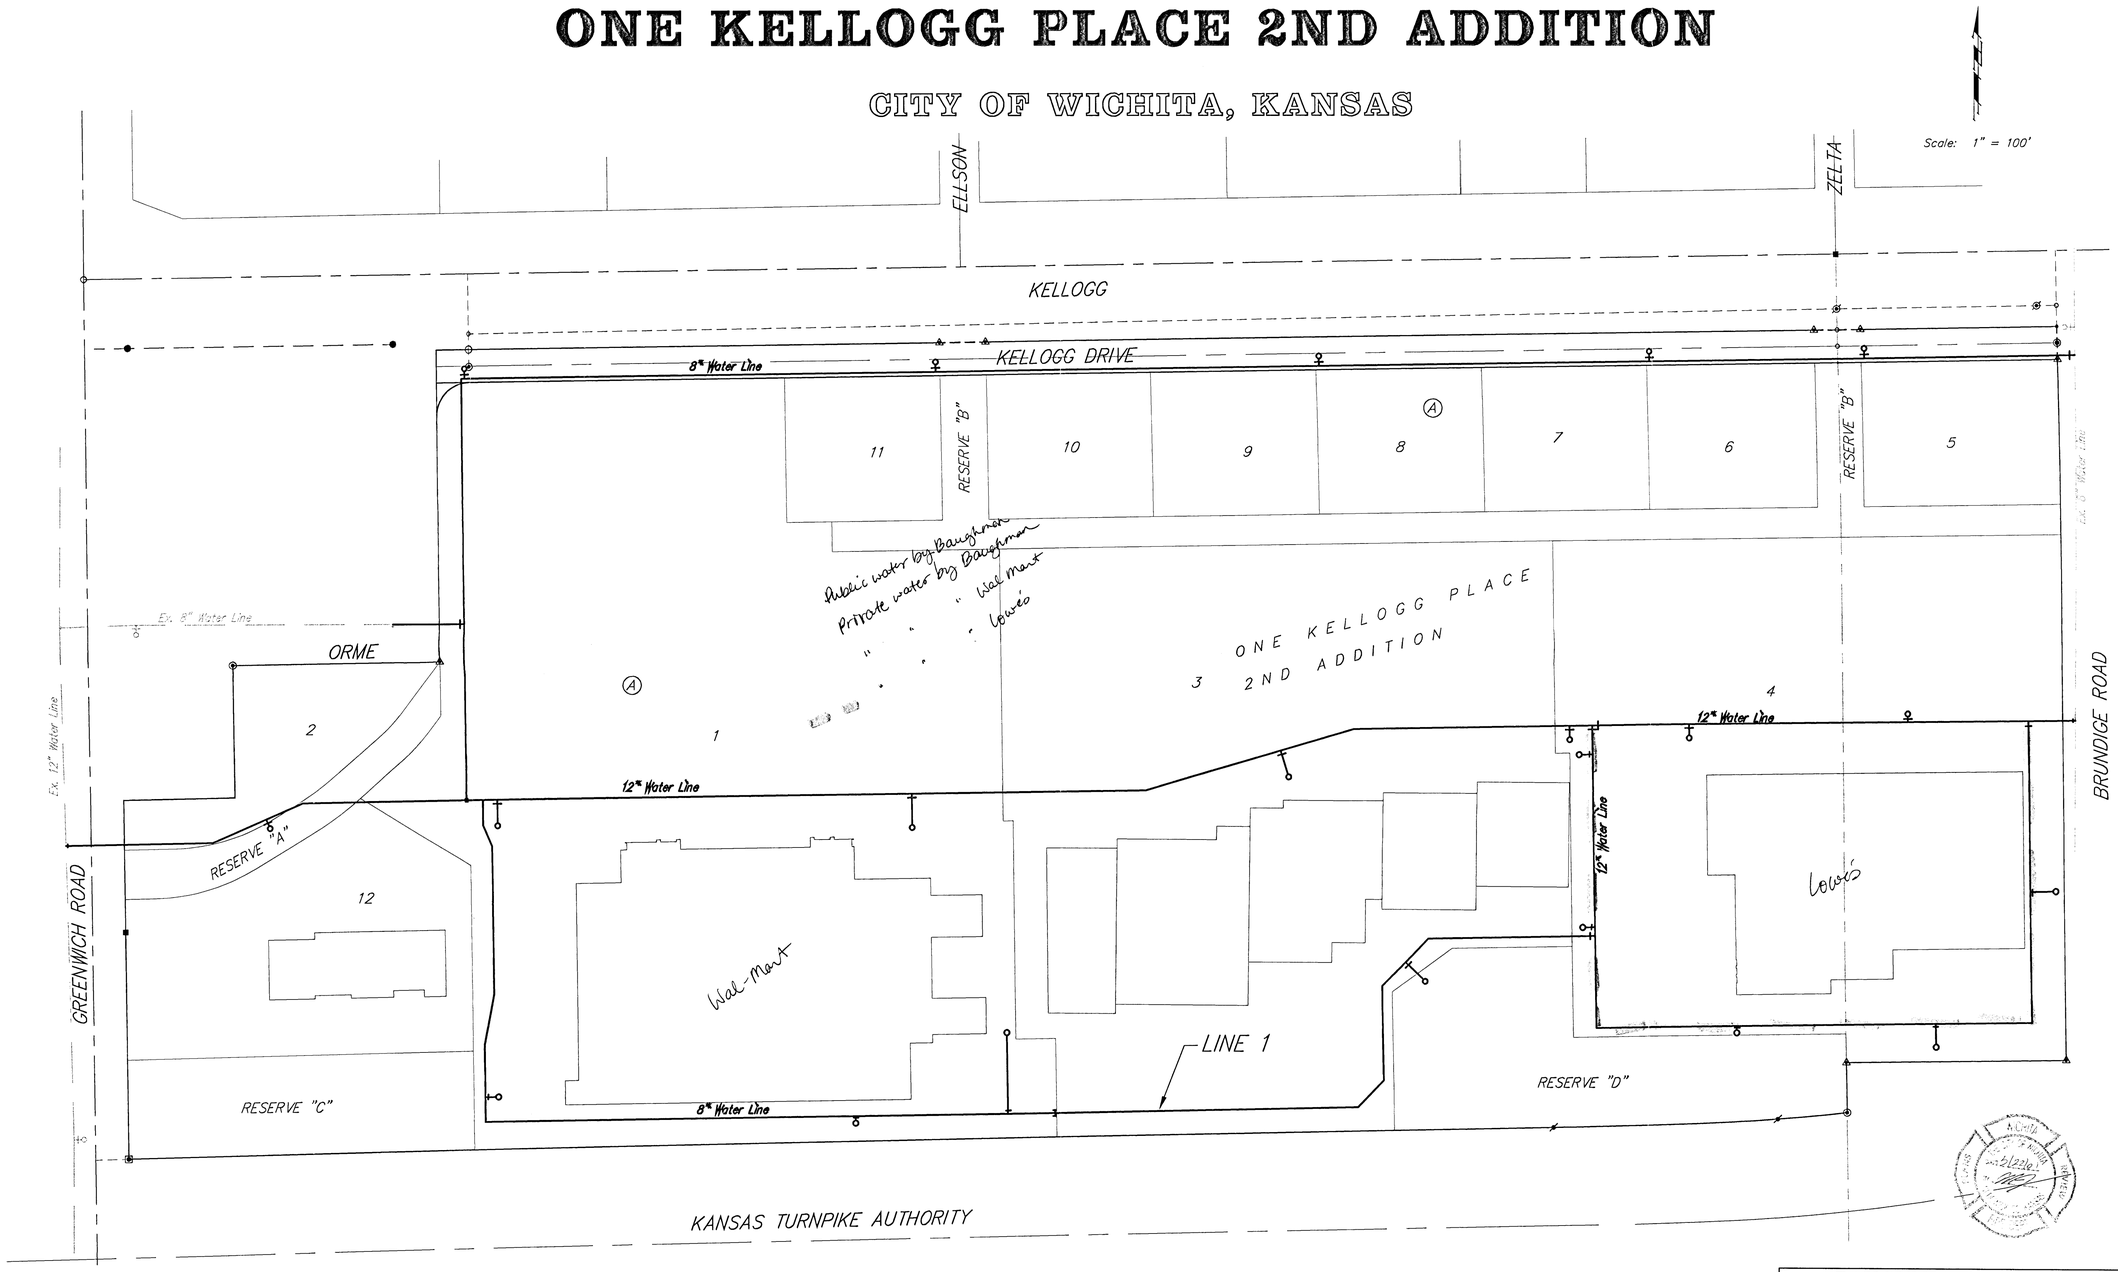


BAUGHMAN COMPANY P.A.
ENGINEERING, SURVEYING, & PLANNING
316-262-7271 • 315 ELLIS • WICHITA, KANSAS 67211