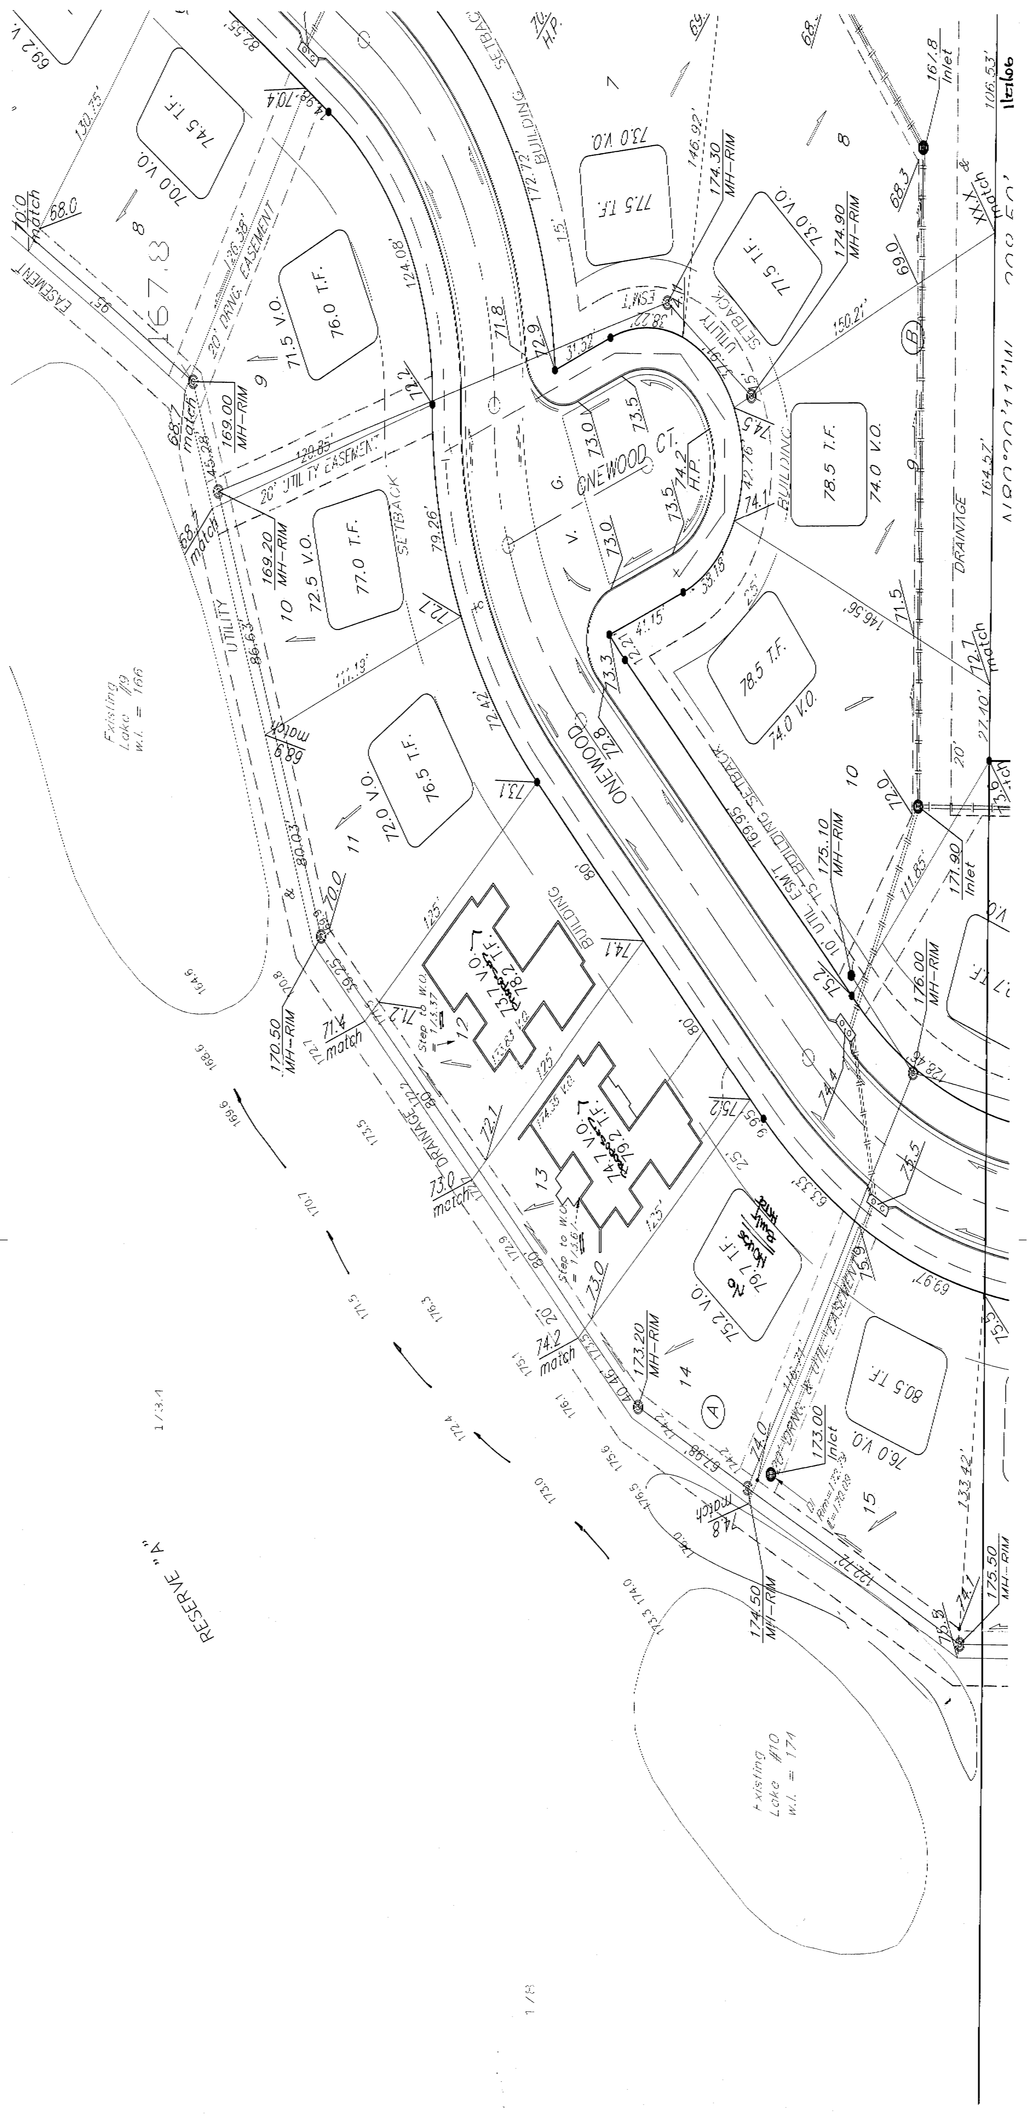

RESERVE "A"
Existing Lake #9 w.l. = 166
Existing Lake #10 w.l. = 174
ONEWOOD CT.
BUILDING SETBACK
UTILITY SETBACK
DRAINAGE
20' DRNG. EASEMENT
20' UTILITY EASEMENT
10' UTIL. ESM'T