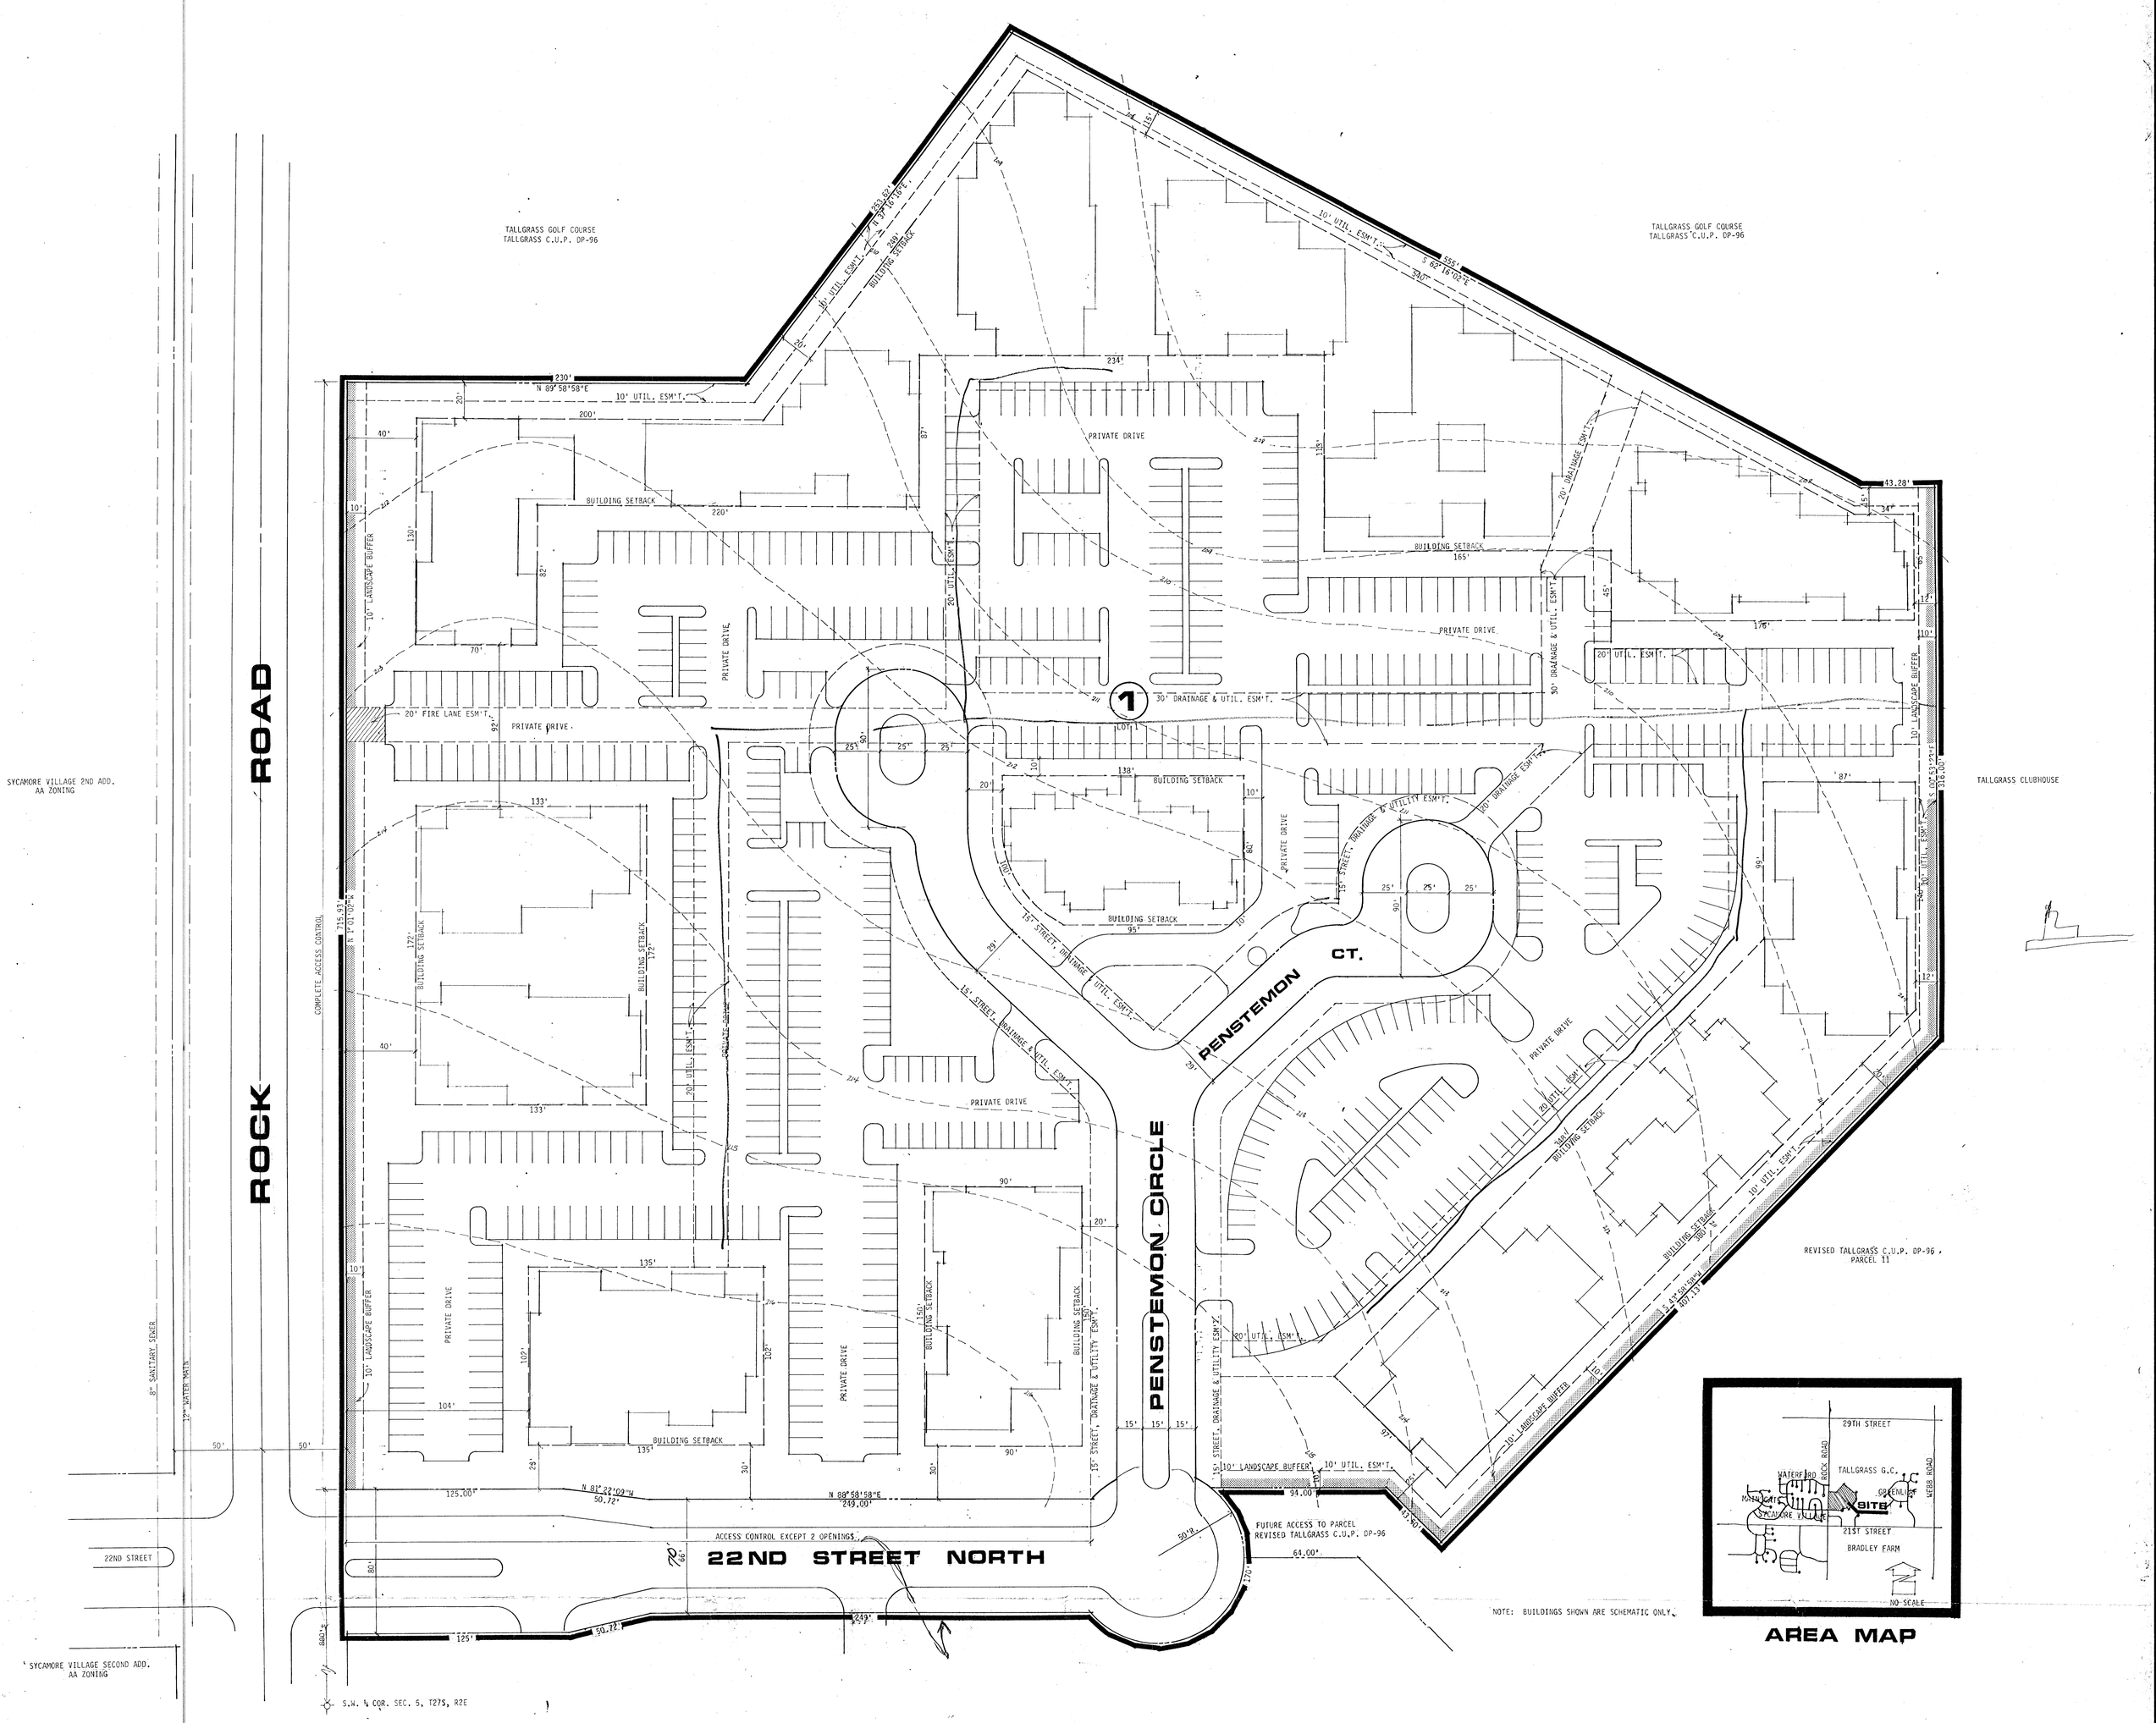

PRELIMINARY PLAT

EXECUTIVE PARK AT TALLGRASS

OWNER: TALLGRASS COMPANY, P.O. BOX 4048, WICHITA, KANSAS NORTH

DATE: Aug. 5, 1982

2' CONTOUR INTERVAL

BILL G. YUNG DESIGN
8225 E. 35TH. ST. NORTH, WICHITA, KS 67226 316-683-5567