



Wichita-Sedgwick County Metropolitan Area Planning Department

May 31, 2018

Elite USA Construction, LLC
240 N. Rock Road, #250
Wichita, KS 67206



K.E. Miller Engineering, P.A.
Attn: Kirk Miller
117 E. Lewis Street
Wichita, KS 67202

Re: BZA2018-00016: Administrative Adjustment to reduce the front yard setback by 20% and the rear yard setback by 50% on property zoned SF-5 Single-Family Residential (SF-5).

Legal Description: Lot 6, Block 7, Sawmill Creek Addition, Wichita, Sedgwick County, Kansas; generally located east of North Rock Road and north of 45th Street North (8221 Saw Mill Court)

Dear Applicant,

We have reviewed your request for a Zoning Adjustment to reduce the front and rear yard setbacks on the aforementioned property. From reviewing the application, we understand that you desire to reduce front setback from 25 feet to 20 feet and the rear setback by 50 percent to allow construction of a new single-family residence.


Section V-I.2.a of the Unified Zoning Code ("UZC") allows reducing minimum front setback by 20% and the rear yard setback (required by the property development standards of the zoning district) by up to 50 percent if not in excess of 300 square feet. These adjustments are permissible when the provisions of those sections and the Zoning Adjustment Criteria of Section V-I.6 are met. We find that the reduction of the setbacks as proposed meets the provisions of Section V-I.2.a and the four criteria required by Section V-I.6 as set out below:


- 1) Impact on safety and convenience of vehicular and pedestrian circulation: The location of the proposed front and rear setbacks will have no impact on the safety and convenience of vehicular and pedestrian circulation in the right-of-way.
- 2) Impact on existing uses in surrounding areas: There will be no impact on the existing uses in surrounding areas; street visibility will be unchanged for neighboring properties.
- 3) Compatibility with existing or permitted uses on abutting sites: Abutting sites are zoned to allow residential development and the reduction of the front and rear yard setbacks will not have a negative impact on existing or permitted uses.
- 4) Effect on public health, safety or welfare: There will be no encroachment into public utility easements or right-of-way. There will be no negative impact on the public health, safety or welfare, nor will properties or improvements in the vicinity be materially injured.

Our signatures below indicate that a Zoning Adjustment to reduce front yard setback by 20 % and the rear yard side setback by 50% is hereby GRANTED, subject to the following conditions:

- 1) The site shall be developed in general conformance with the approved site plan and the attached legal description of the setback areas.
- 2) The applicant shall obtain a building permit and complete construction within one year of the Administrative Adjustment approval. The site shall conform to all codes including but not limited to building, health and fire.
- 3) The setback reduction shall apply only to the front and rear yard setbacks as illustrated on the approved site plan. All other structures or additions on the subject property shall conform to the setbacks permitted by the Unified Zoning Code unless a separate Zoning Adjustment or Variance is granted.
- 4) If the Zoning Administrator finds that there is a violation of any of the conditions of the Zoning Adjustment, the Zoning Administrator, in addition to enforcing the other remedies set forth in the Unified Zoning Code, may, with the concurrence of the Planning Director, declare that the Zoning Adjustment is null and void.

The "Development Application" sign should now be removed from the property.

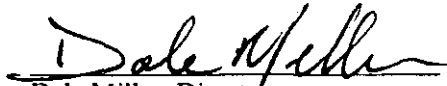

Dale Miller, Director
Metropolitan Area Planning Department

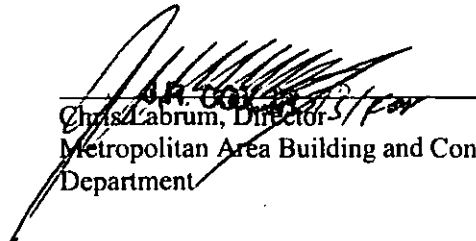
Chris Labrum, Director
Metropolitan Area Building and Construction
Department


cc: MABCD
Pete Meitzner, CM District II
Laura Rainwater, CSR District II

Adm. Adjustment to reduce Rear Setback 8221 Sawmill Court Sawmill Creek Addition Wichita, Sedgwick County, Kansas


Reduce Rear and Front Setback to allow
Walk-Out (Enlarged for Clarity)
Per BZA 2018-00016

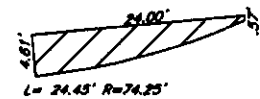

AREA(1) = 78.18 SF

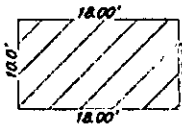


AREA(2) =
180.00 SF
TOTAL =
258.18 SF

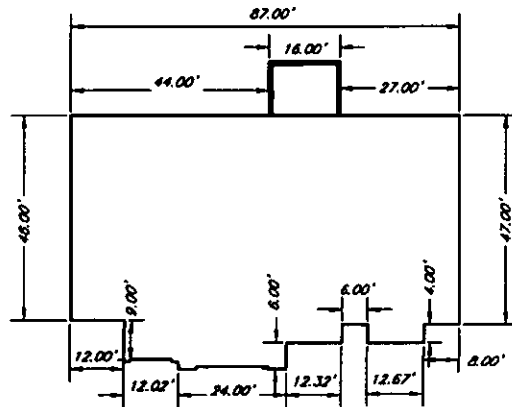

SITE PLAN
5-21-18

SCALE: 1"=40'

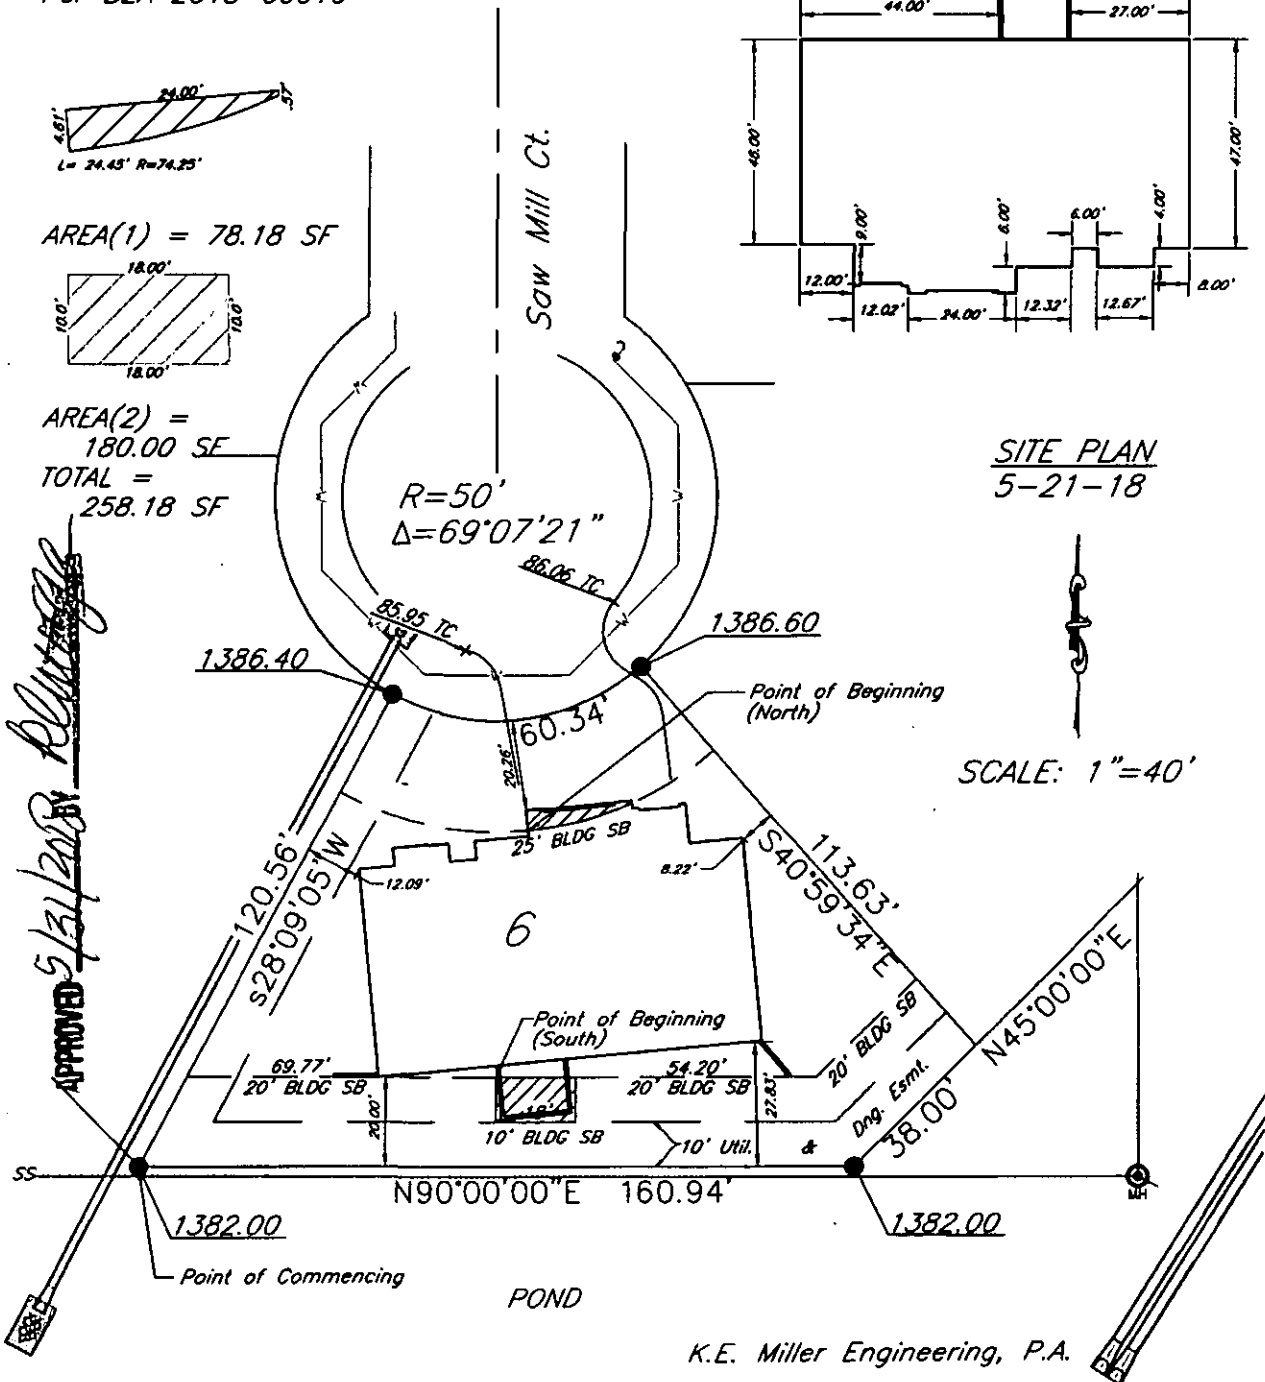

K.E. Miller Engineering, P.A.

SITE PLAN

APPROVED 5/31/2018 BY *[Signature]*

LEGAL DESCRIPTIONS

North Adjustment

Commencing at the Southwest corner of Lot 6, Block 7, Sawmill Creek Addition, to Wichita, Sedgwick County, Kansas; thence N 28°09'05" E, on the West line of Lot 6, a distance of 95.56 feet, to the 25' (Front) Building Setback line; thence on said 25' (Front) Building Setback line, on a curve to the left, with a delta of 19°07'38", and a radius of 75.00 feet, a distance of 44.06 feet, to the Point of Beginning; thence N 05°20'27" W, a distance of 4.61 feet; thence S 84°39'33" W, a distance of 24.00 feet; thence S 05°20'27" E, a distance of 0.57 feet, to the 25' (Front) Building Setback line; thence on said 25' (Front) Building Setback line, on a curve to the right, with a delta of 19°07'38", and a radius of 75.00 feet, a distance of 24.44 feet, to the Point of Beginning.

South Adjustment

Commencing at the Southwest corner of Lot 6, Block 7, Sawmill Creek Addition, to Wichita, Sedgwick County, Kansas; thence N 28°09'05" E, on the West line of Lot 6, a distance of 22.82 feet, to the 20' (Rear) Building Setback line; thence S 90°00'00" E, a distance of 69.77 feet, on said 20' (Rear) Building Setback line, to the Point of Beginning; thence continuing on the said 20' (Rear) Building Setback line, S 90°00'00" E, a distance of 18.00 feet; thence S 00°00'00" E, a distance of 10.00 feet, to the Utility and Drainage Easement line; thence N 90°00'00" W, on the said Drainage Easement line, a distance of 18.00 feet; thence N 0°00'00" W, a distance of 10.00 feet, to the 20' (Rear) Building Setback line, and the Point of Beginning.

SITE PLAN

APPROVED 5/31/2018 BY 