


# GODDARD SCHOOL 2ND ADDITION

AN ADDITION TO WICHITA, SEDGWICK COUNTY, KANSAS

599.36' Complete Access Control  
 125.00' One Way

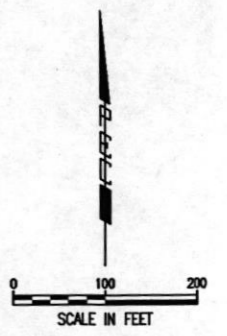

LEGEND	
	ACCESS CONTROL TO BE VACATED
	ACCESS CONTROL TO BE DEDICATED
	PLATTED EASEMENTS TO BE VACATED (Utility Easements & Waterline Easements)
	UTILITY EASEMENTS TO BE DEDICATED
	WATERLINE EASEMENTS TO BE DEDICATED

167TH STREET WEST = SECTION LINE

KELLOGG (US HIGHWAY 54)

Complete Access Control  
 1,011.37'

Saved 01-28-2009 11:00:12 AM by BEJ  
 Plot Scale 1:204.8512  
 C:\2007\07148\001\07148-001-Easement and Access Control Vacated\_Indicate 1 of 2


# GODDARD SCHOOL 2ND ADDITION

AN ADDITION TO WICHITA, SEDGWICK COUNTY, KANSAS

☐ MAPLE STREET = SECTION LINE

☐ 167TH STREET WEST = SECTION LINE

LEGEND	
- - - - -	ACCESS CONTROL TO BE VACATED
XXXX.XXX'	ACCESS CONTROL TO BE DEDICATED
//////	PLATTED EASEMENTS TO BE VACATED (Utility Easements & Waterline Easements)
▨▨▨▨	UTILITY EASEMENTS TO BE DEDICATED
▨▨▨▨	WATERLINE EASEMENTS TO BE DEDICATED

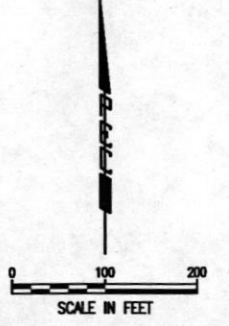

 Plot Sheet: 2 of 2

Complete Access Control  
 300.00'  
 One Operating  
 100.00'  
 80'

599.36'  
 Complete Access Control  
 400.00'  
 80'

RESERVE B

RESERVE A

①

25' Slope

25' Slope