


VAC 2009-08

WI 82

N.W. 1/4 SEC. 21, TWP. 27, R.1 E.

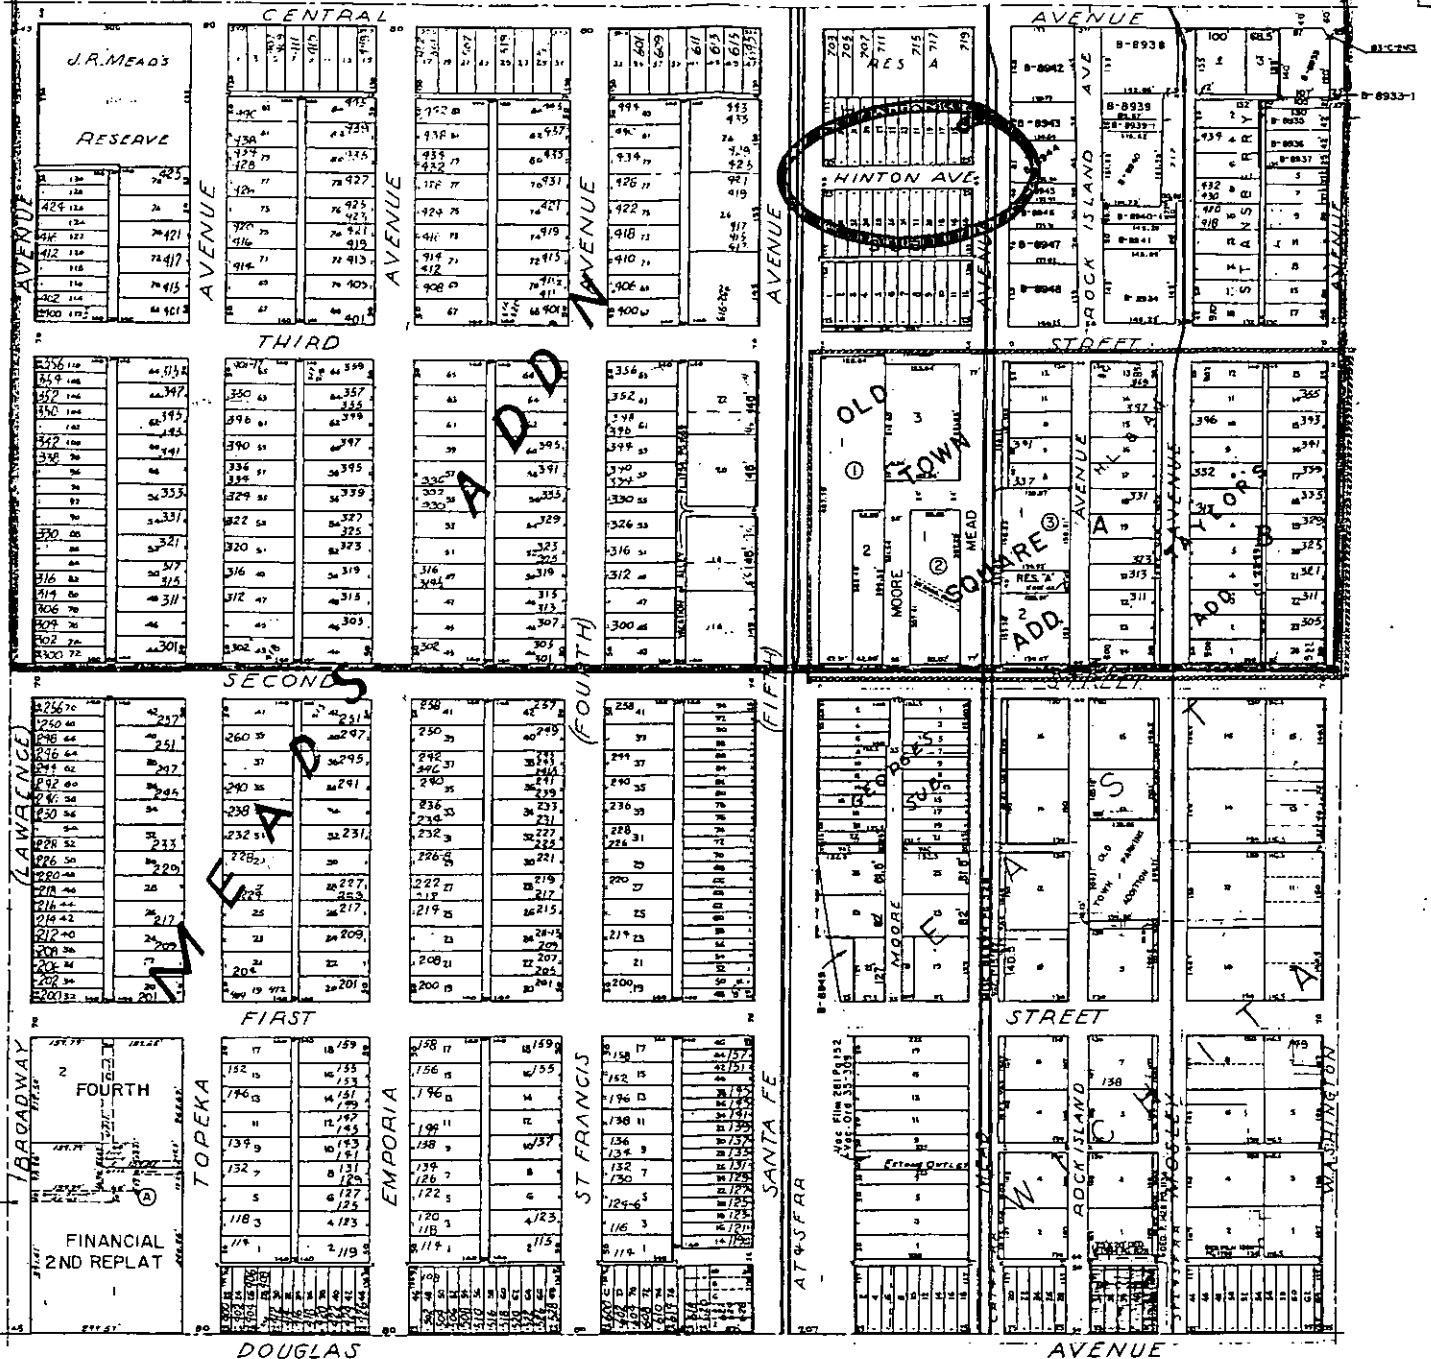

SEDGWICK COUNTY CLERK