
Savoy Company, P.A.
433 S. Hydraulic
Wichita, KS. 67211-1911

PH (316) 265-0005
FAX (316) 265-0275
www.savoyco.com

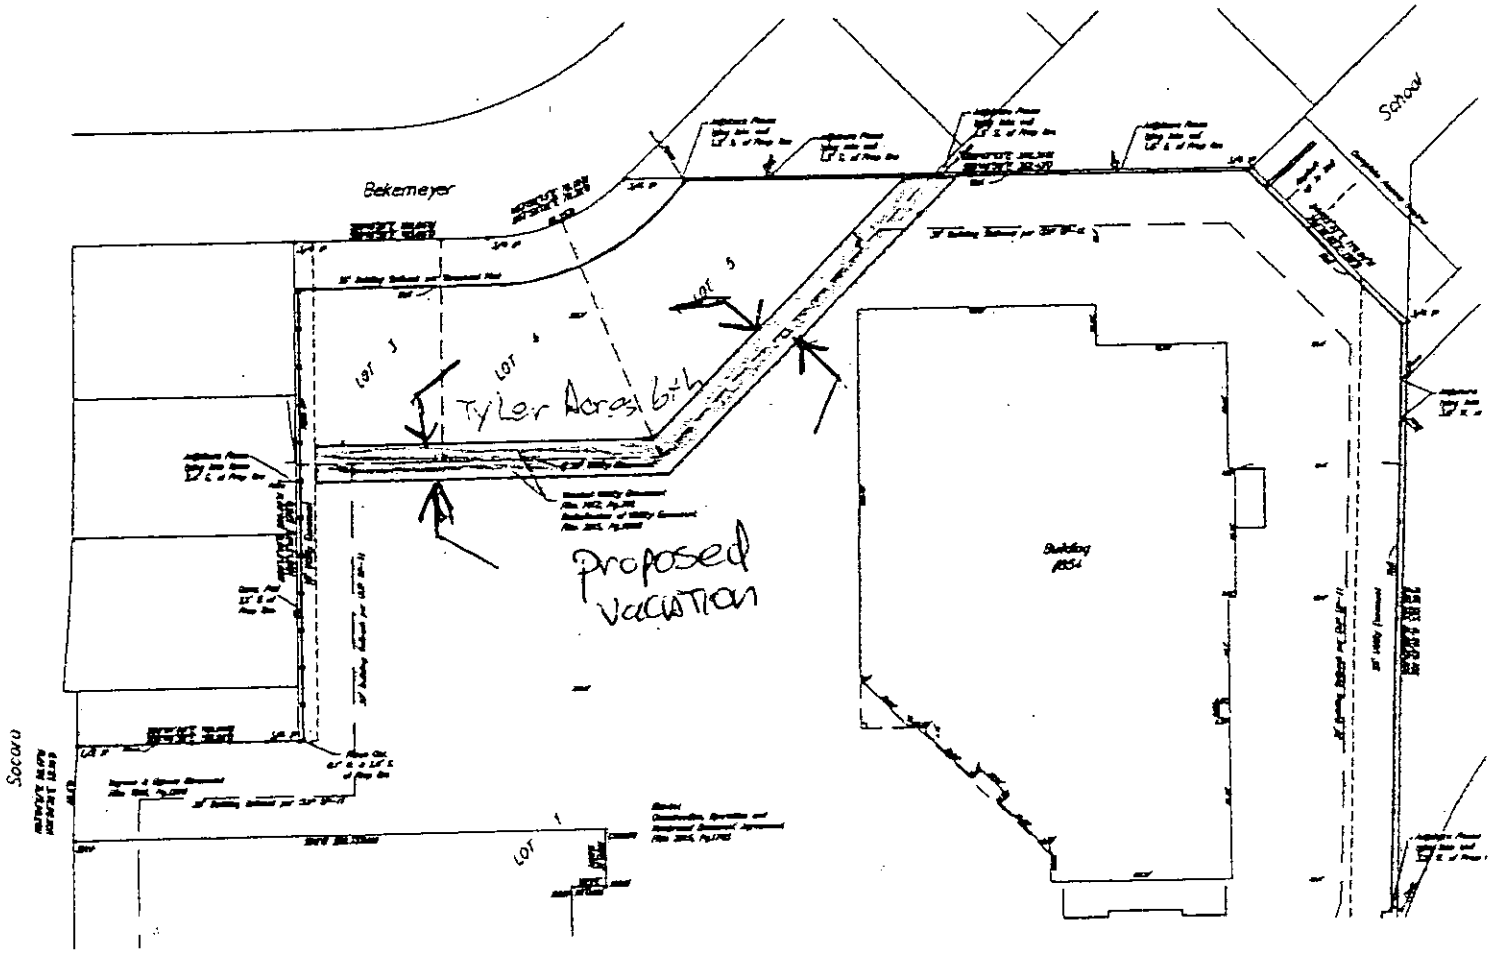

VAC2009-19