




Savoy Company, P.A.
433 S. Hydraulic
Wichita, KS. 67211-1911

PH (316) 265-0005
FAX (316) 265-0275
WWW.SAVOYCO.COM

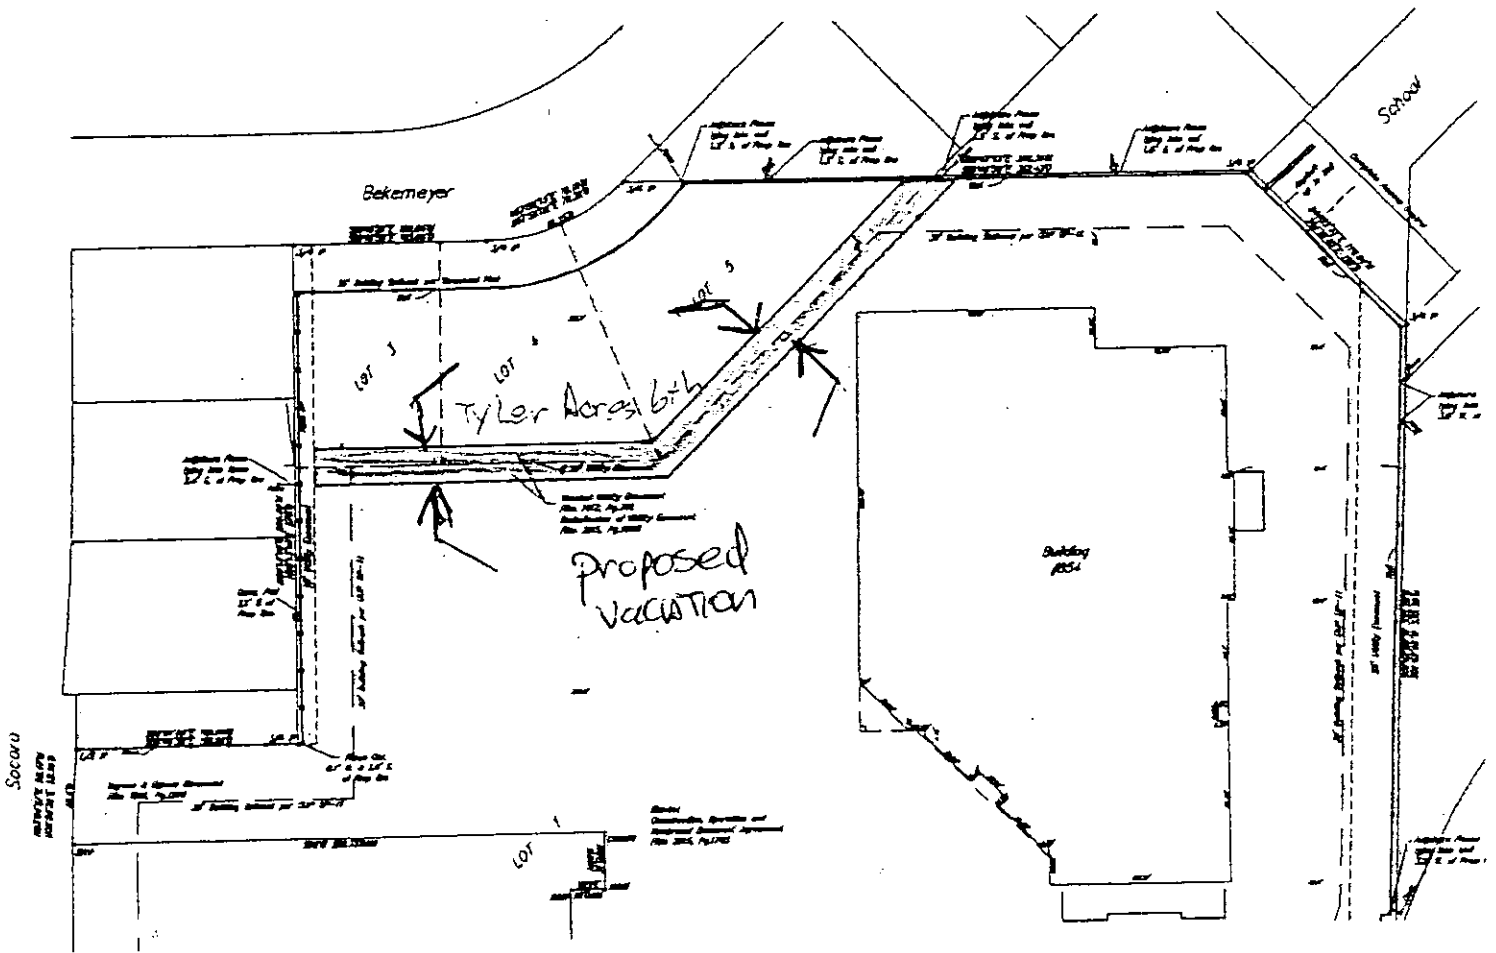

VAC 2009-19