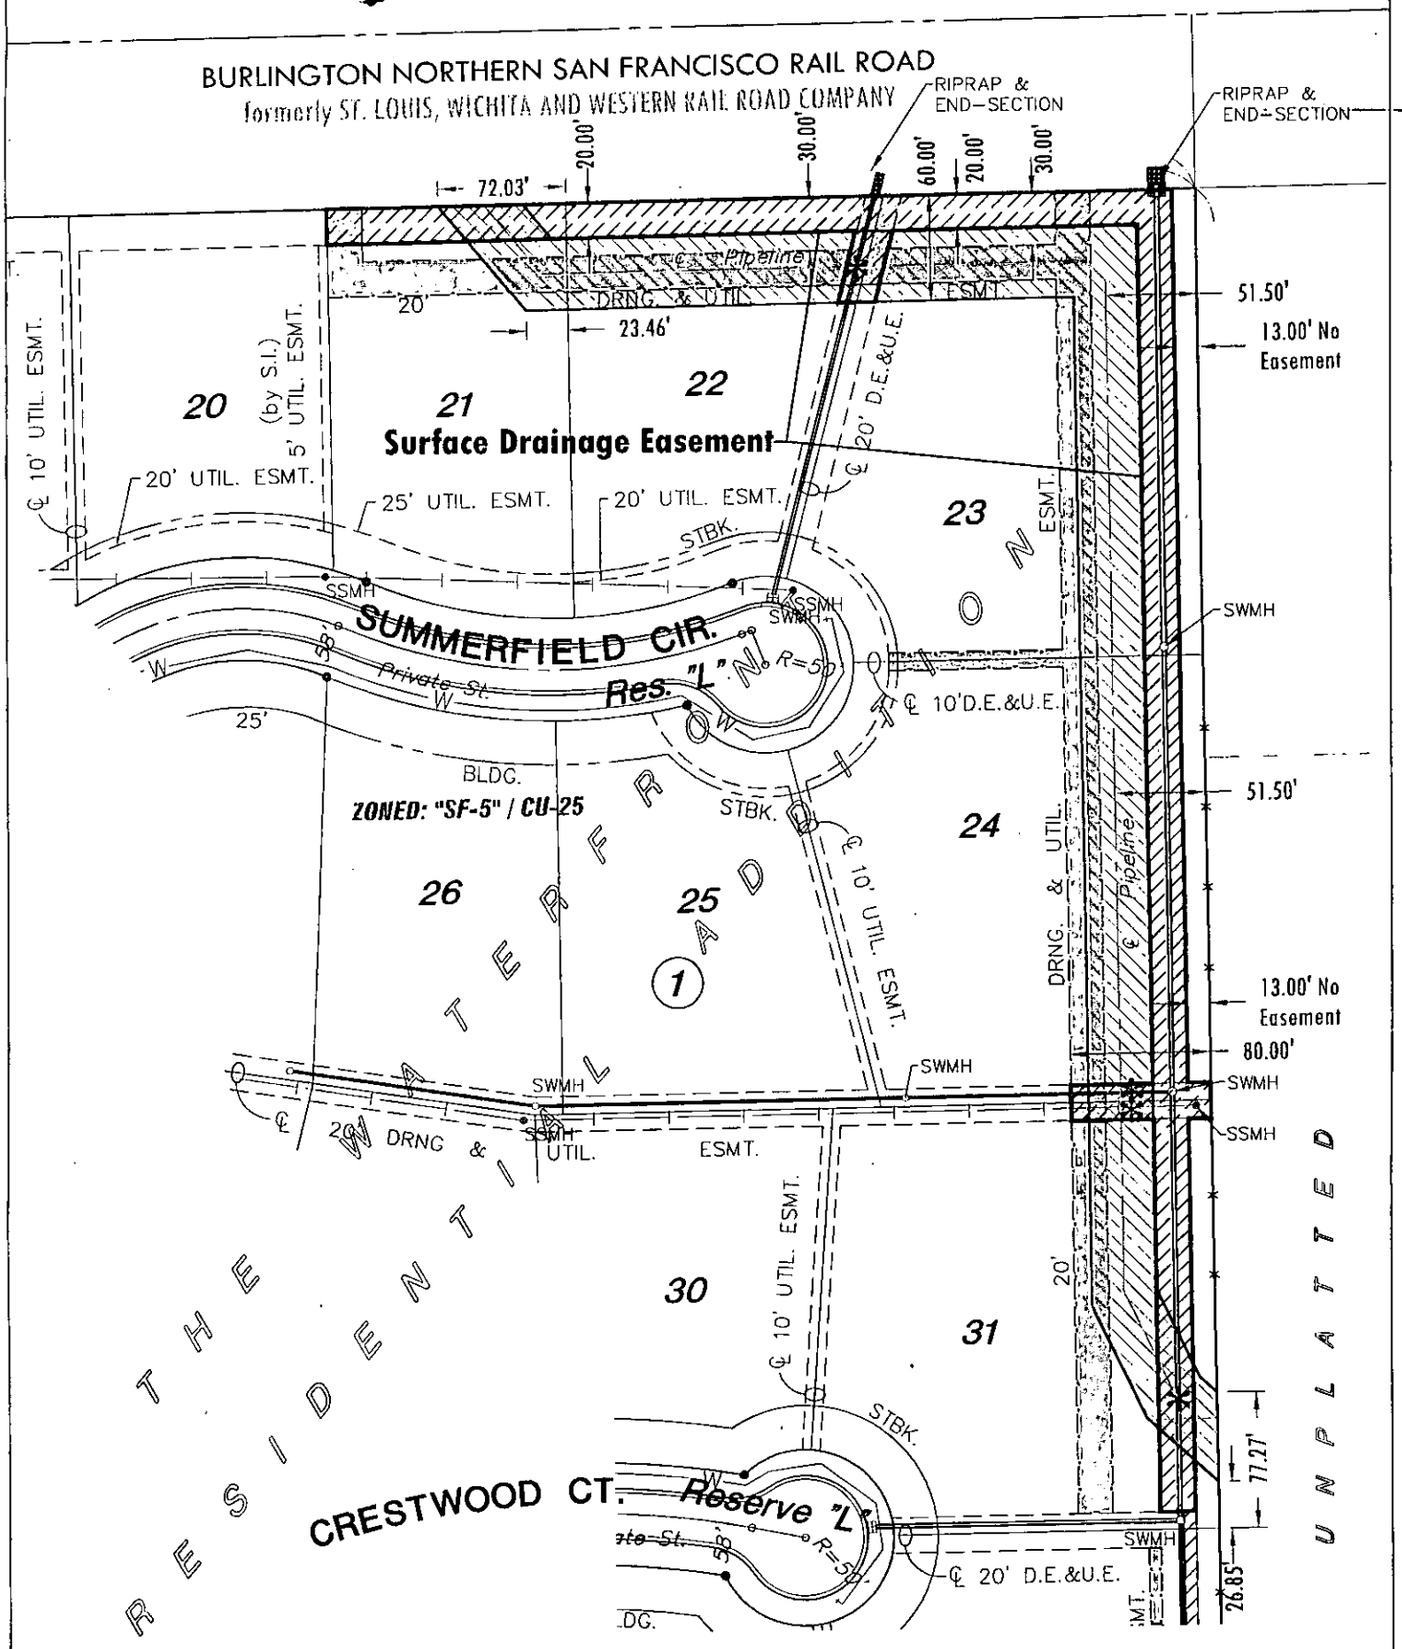

LEGEND

- = Fence
- = Storm sewer
- = Sanitary sewer
- = Water line
- SWMH = Storm sewer inlet/manhole
- SSMH = Sanitary sewer manhole
- = Permitted crossing
- = Vacated Easement Areas
- = New "replacement" Easement Areas
- = "Exclusive Easement Area"
- = Legal Description Area

100 0 50 100

REV: 03-25-2010

MKEC ENGINEERING CONSULTANTS, INC.
411 N. WEBB ROAD
WICHITA, KS. 67206
316-684-9600

PROJECT NAME: WATERFRONT RESIDENTIAL COMPANY, LLC

EXHIBIT A
New Easements - VAC2009-00026

SHEET TITLE

DESIGN BY:	DRAWN BY:	CHECKED BY:
BDL	BDL	BDL

DATE: Rev. Jan.26, 2010 Dec. 2009
JOB NO.: 06266
SHEET/OF: 1 / 1

J:\Civil\06266\dwg\Prop\Pipeline\Exhibit A2vac.dwg 3/25/2010 2:58:41 PM CDT