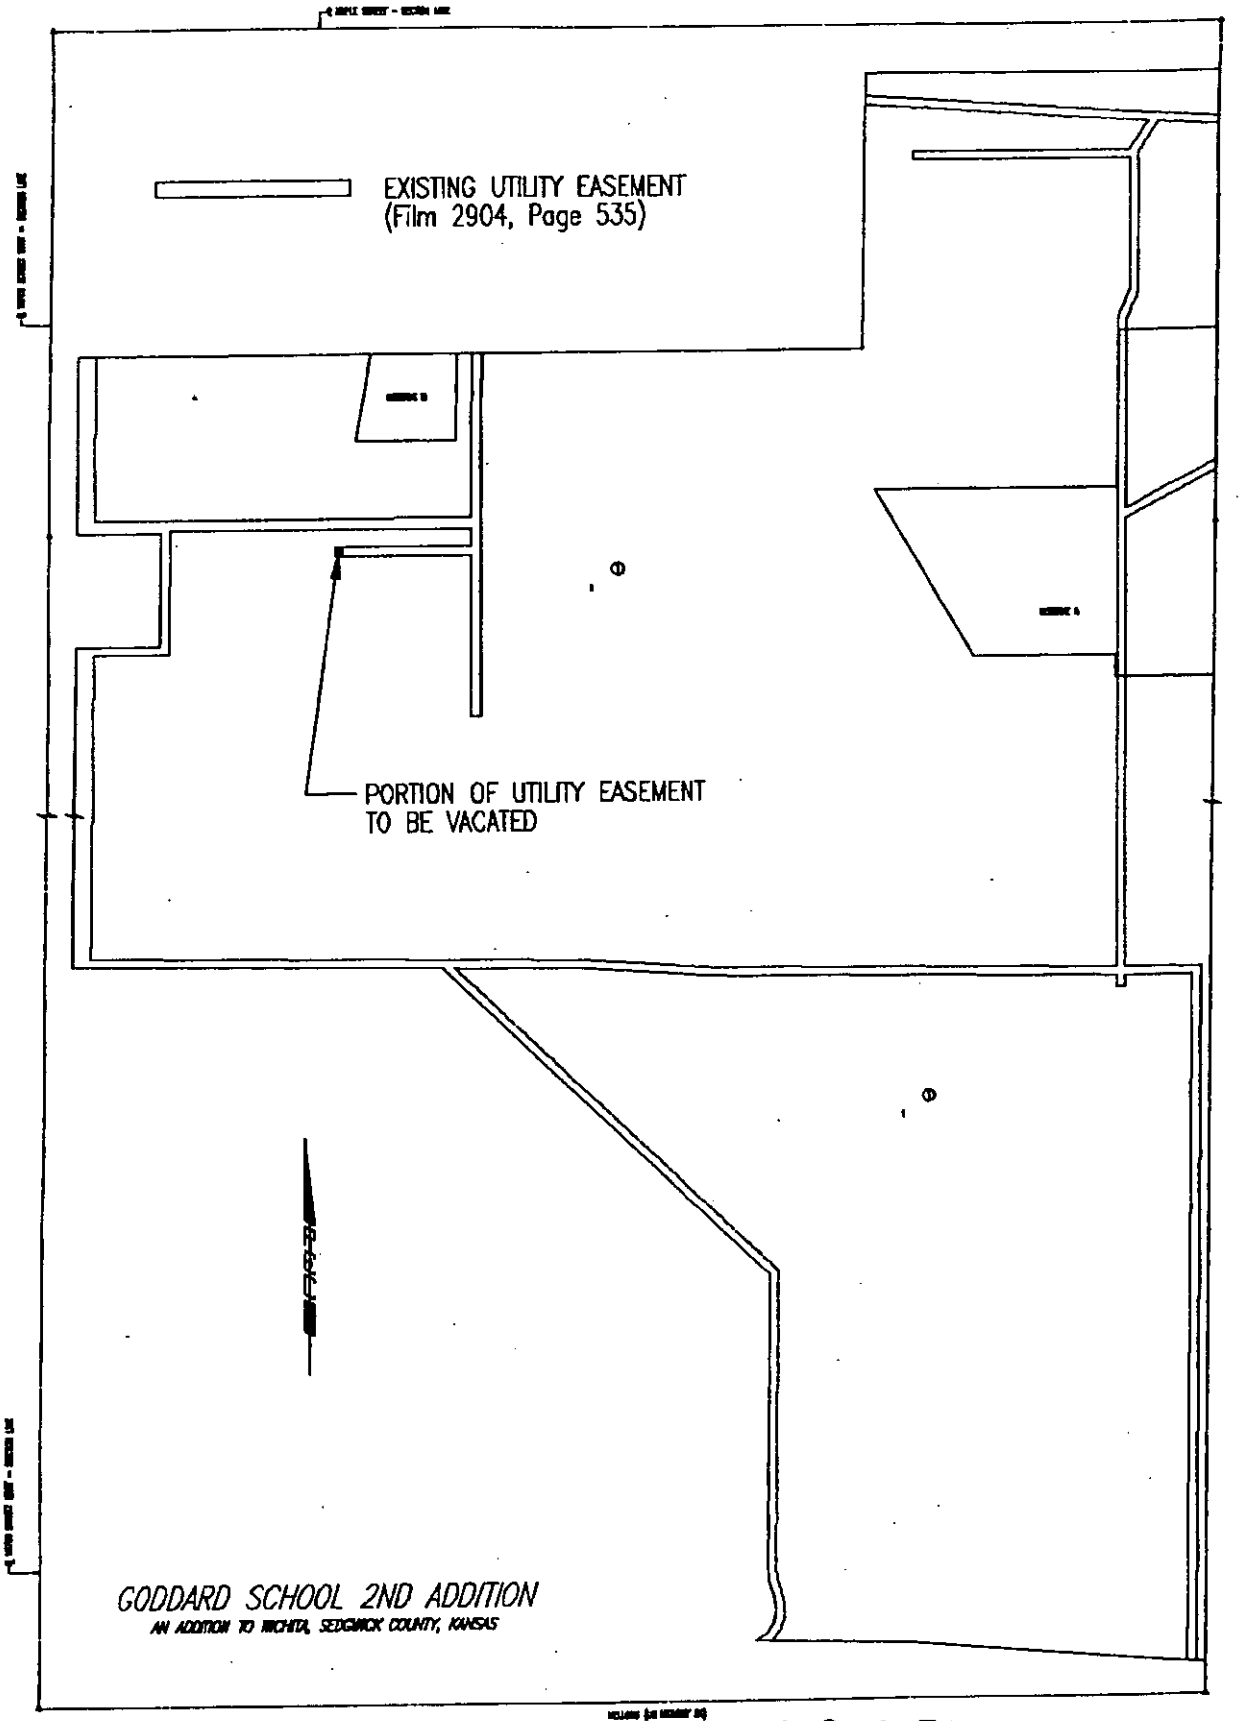
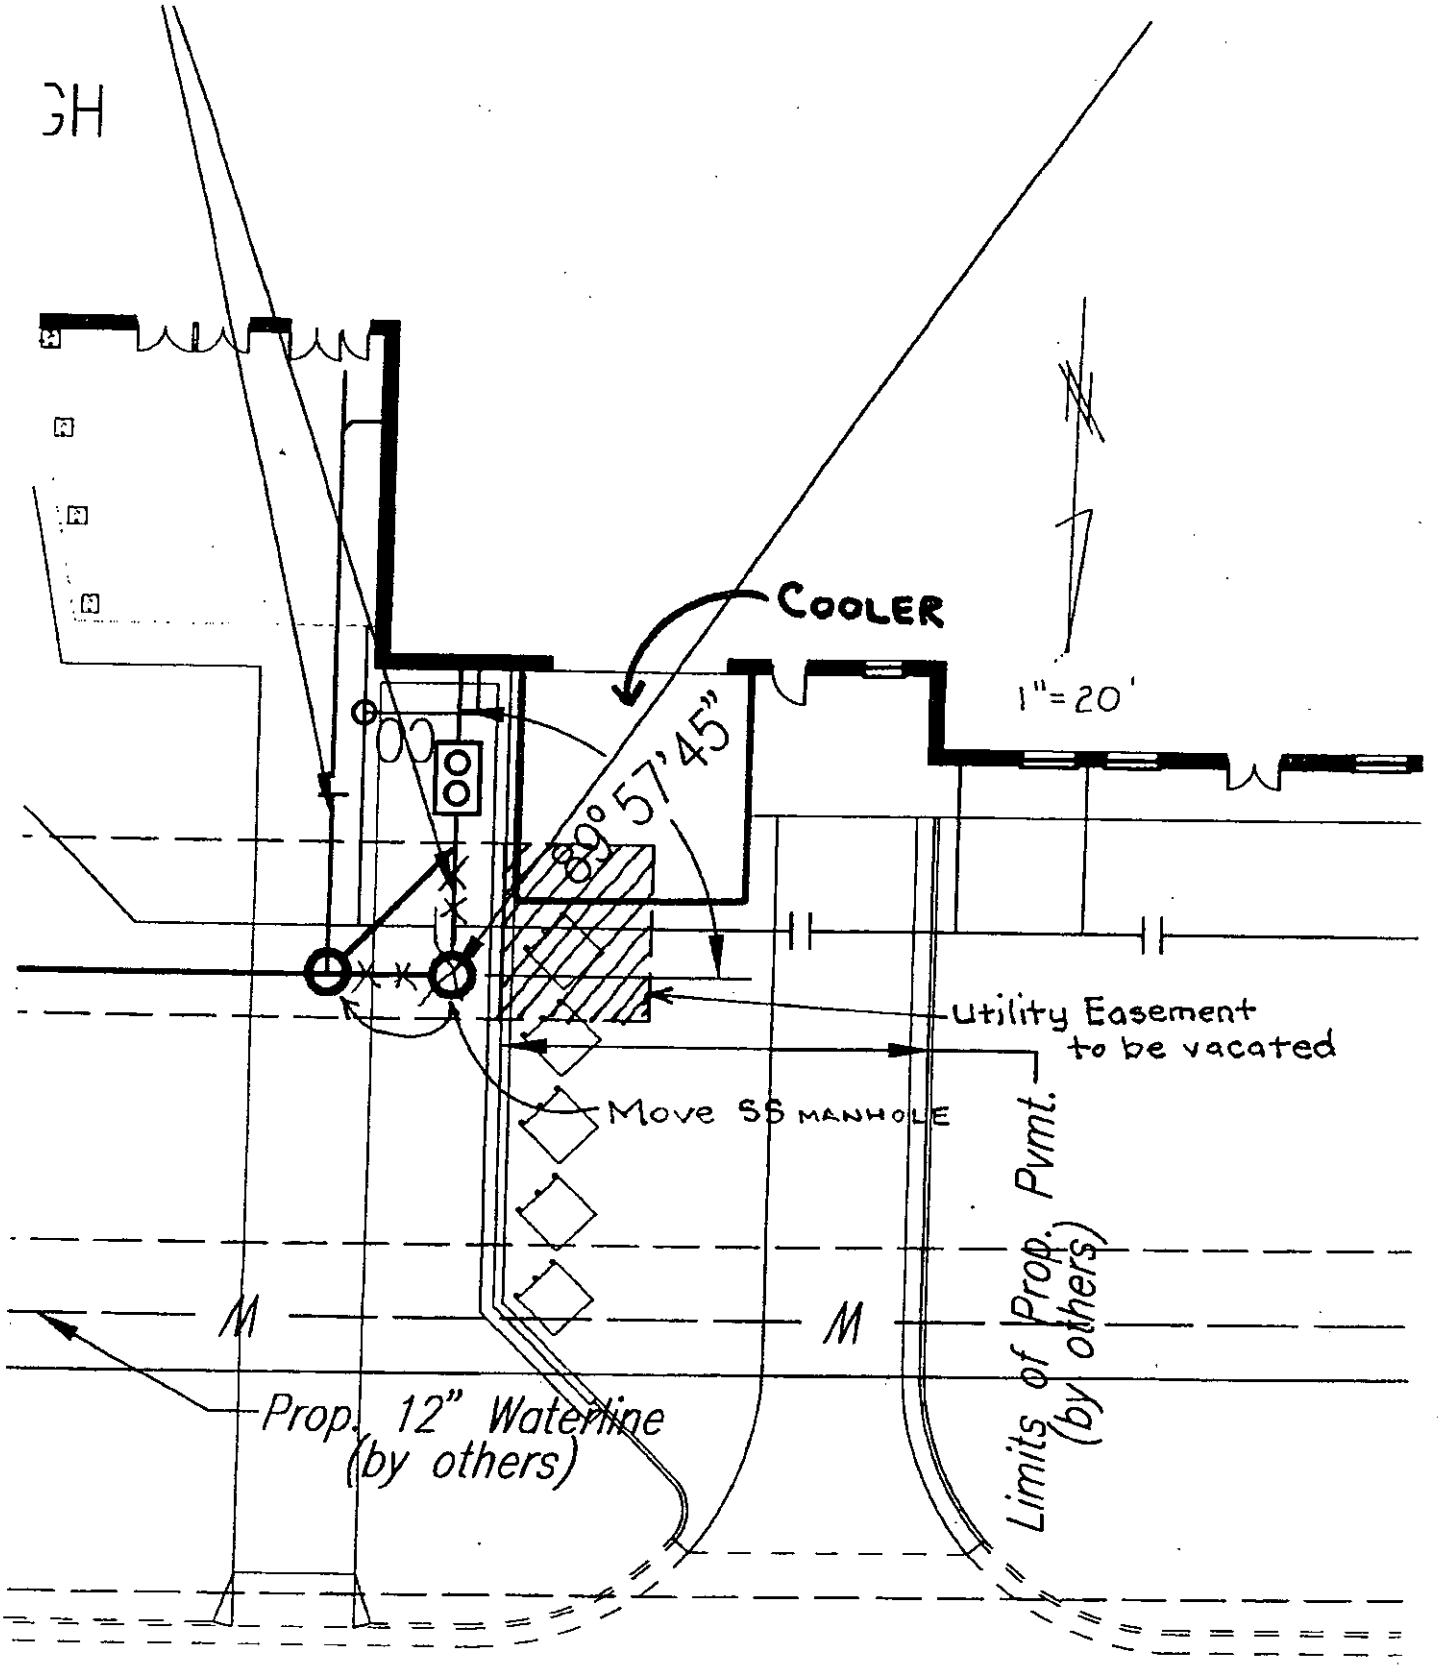

EXISTING UTILITY EASEMENT
(Film 2904, Page 535)
PORTION OF UTILITY EASEMENT
TO BE VACATED
GODDARD SCHOOL 2ND ADDITION
AN ADDITION TO WICHITA, SEDGWICK COUNTY, KANSAS

VAC2004-36


GH
COOLER
1"=20'
89°57'45"
Utility Easement
to be vacated
Move SS MANHOLE
Limits of Prop. Pvmt.
(by others)
Prop. 12" Waterline
(by others)

VAC2009-36