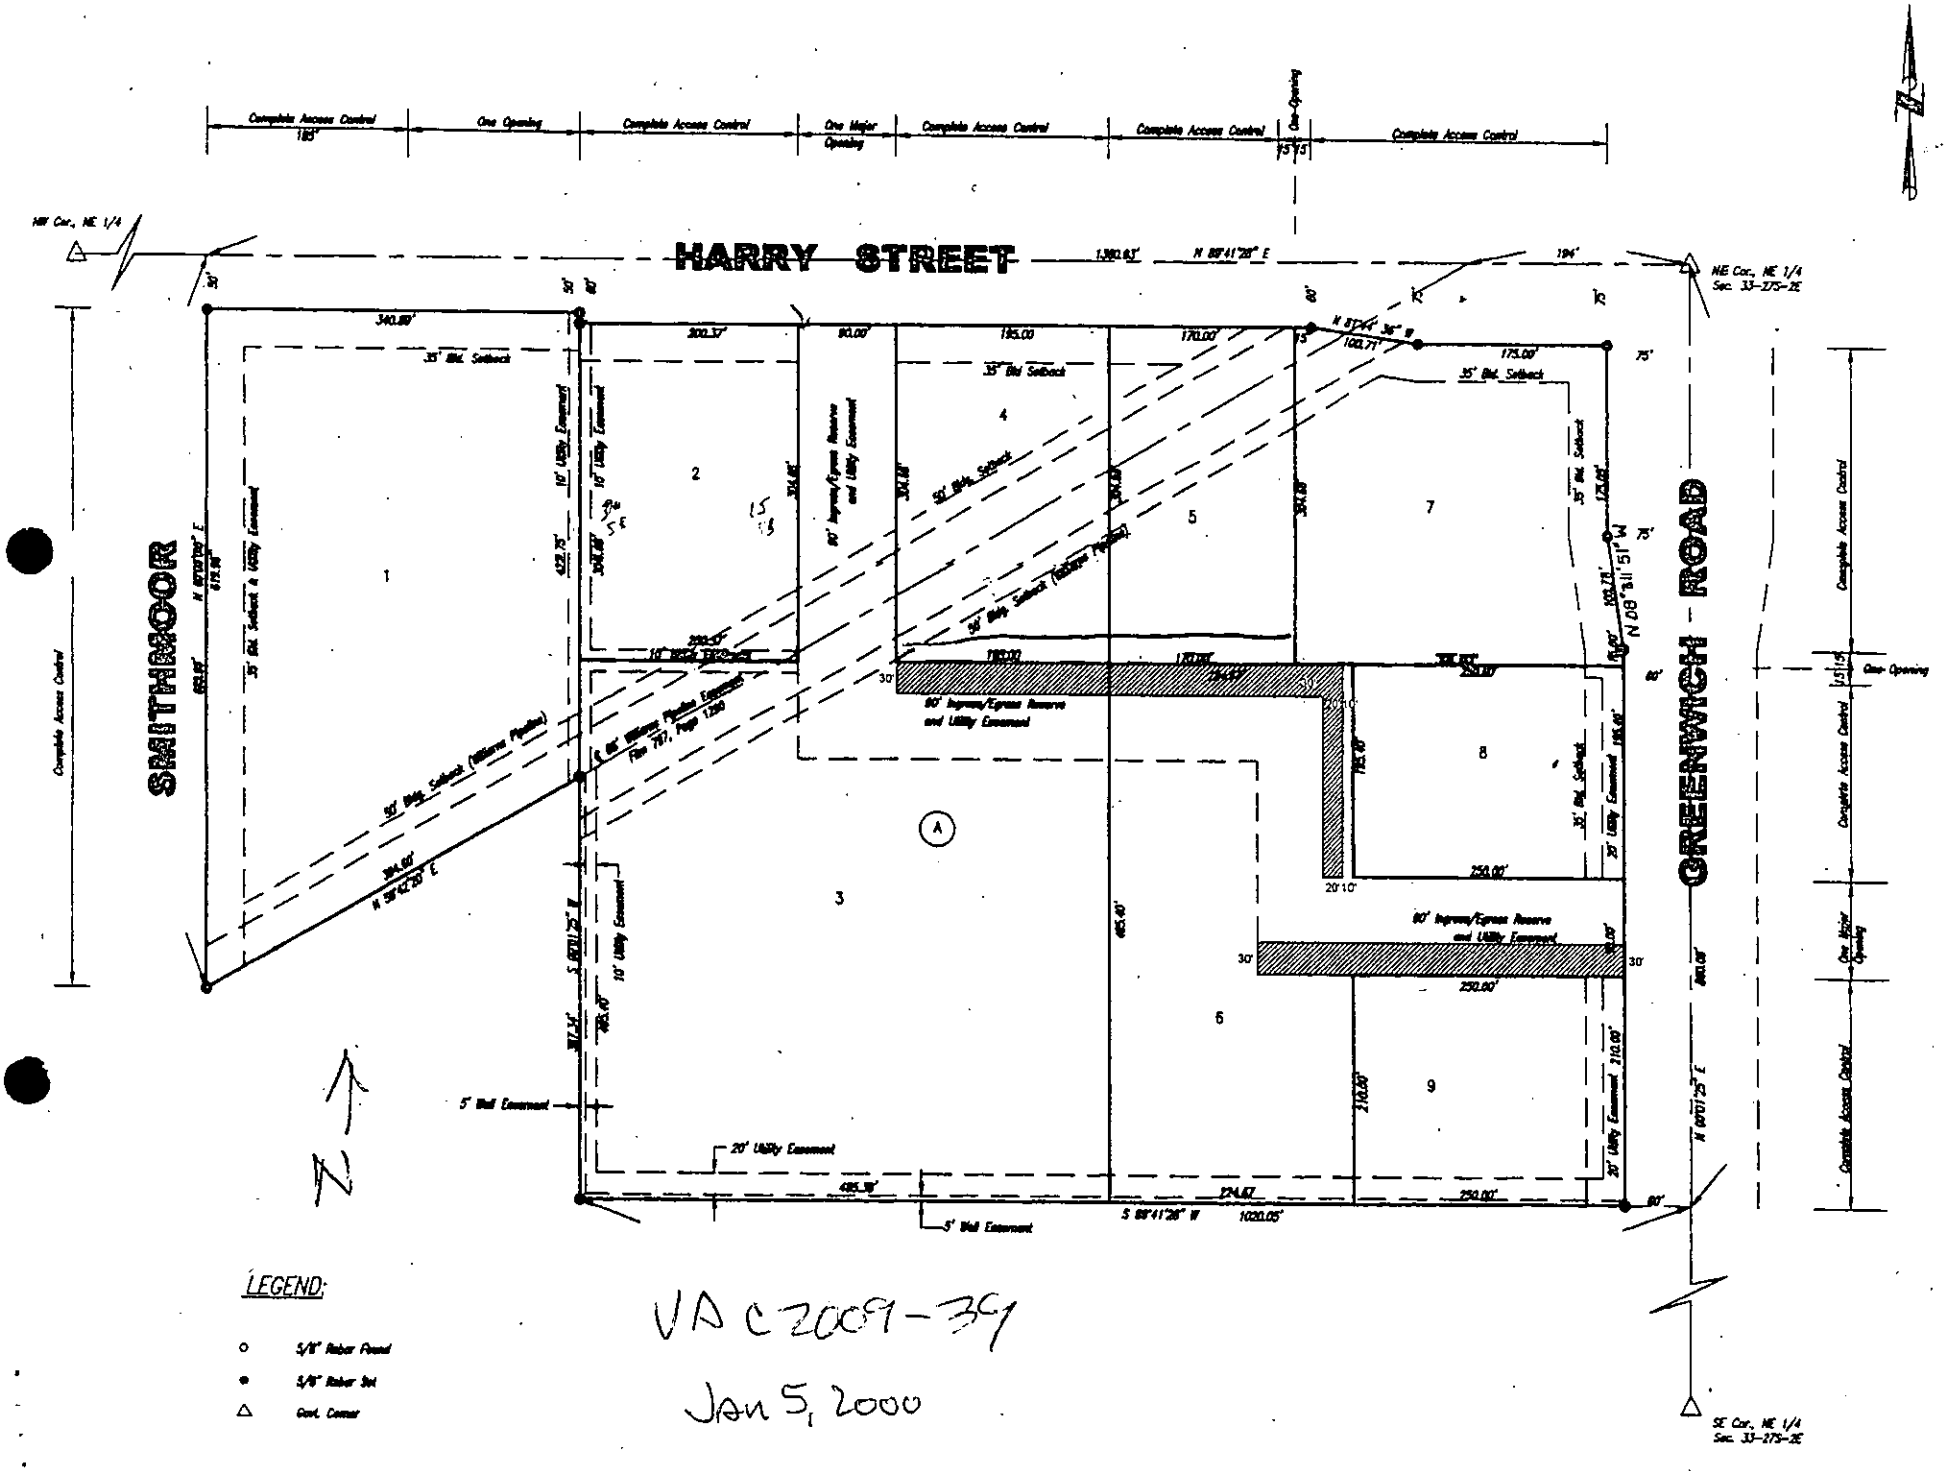



VAC2009-39

Jan 5, 2000