



ACCESS CONTROL EXHIBIT

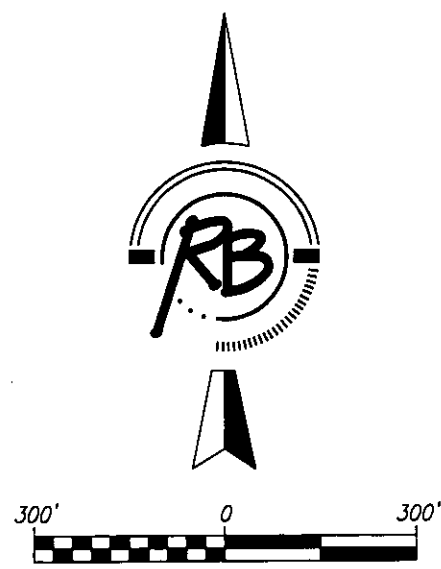

DWG FILE: SURVEY BASE
PROJECT NO. 3606V
APRIL 1, 2010

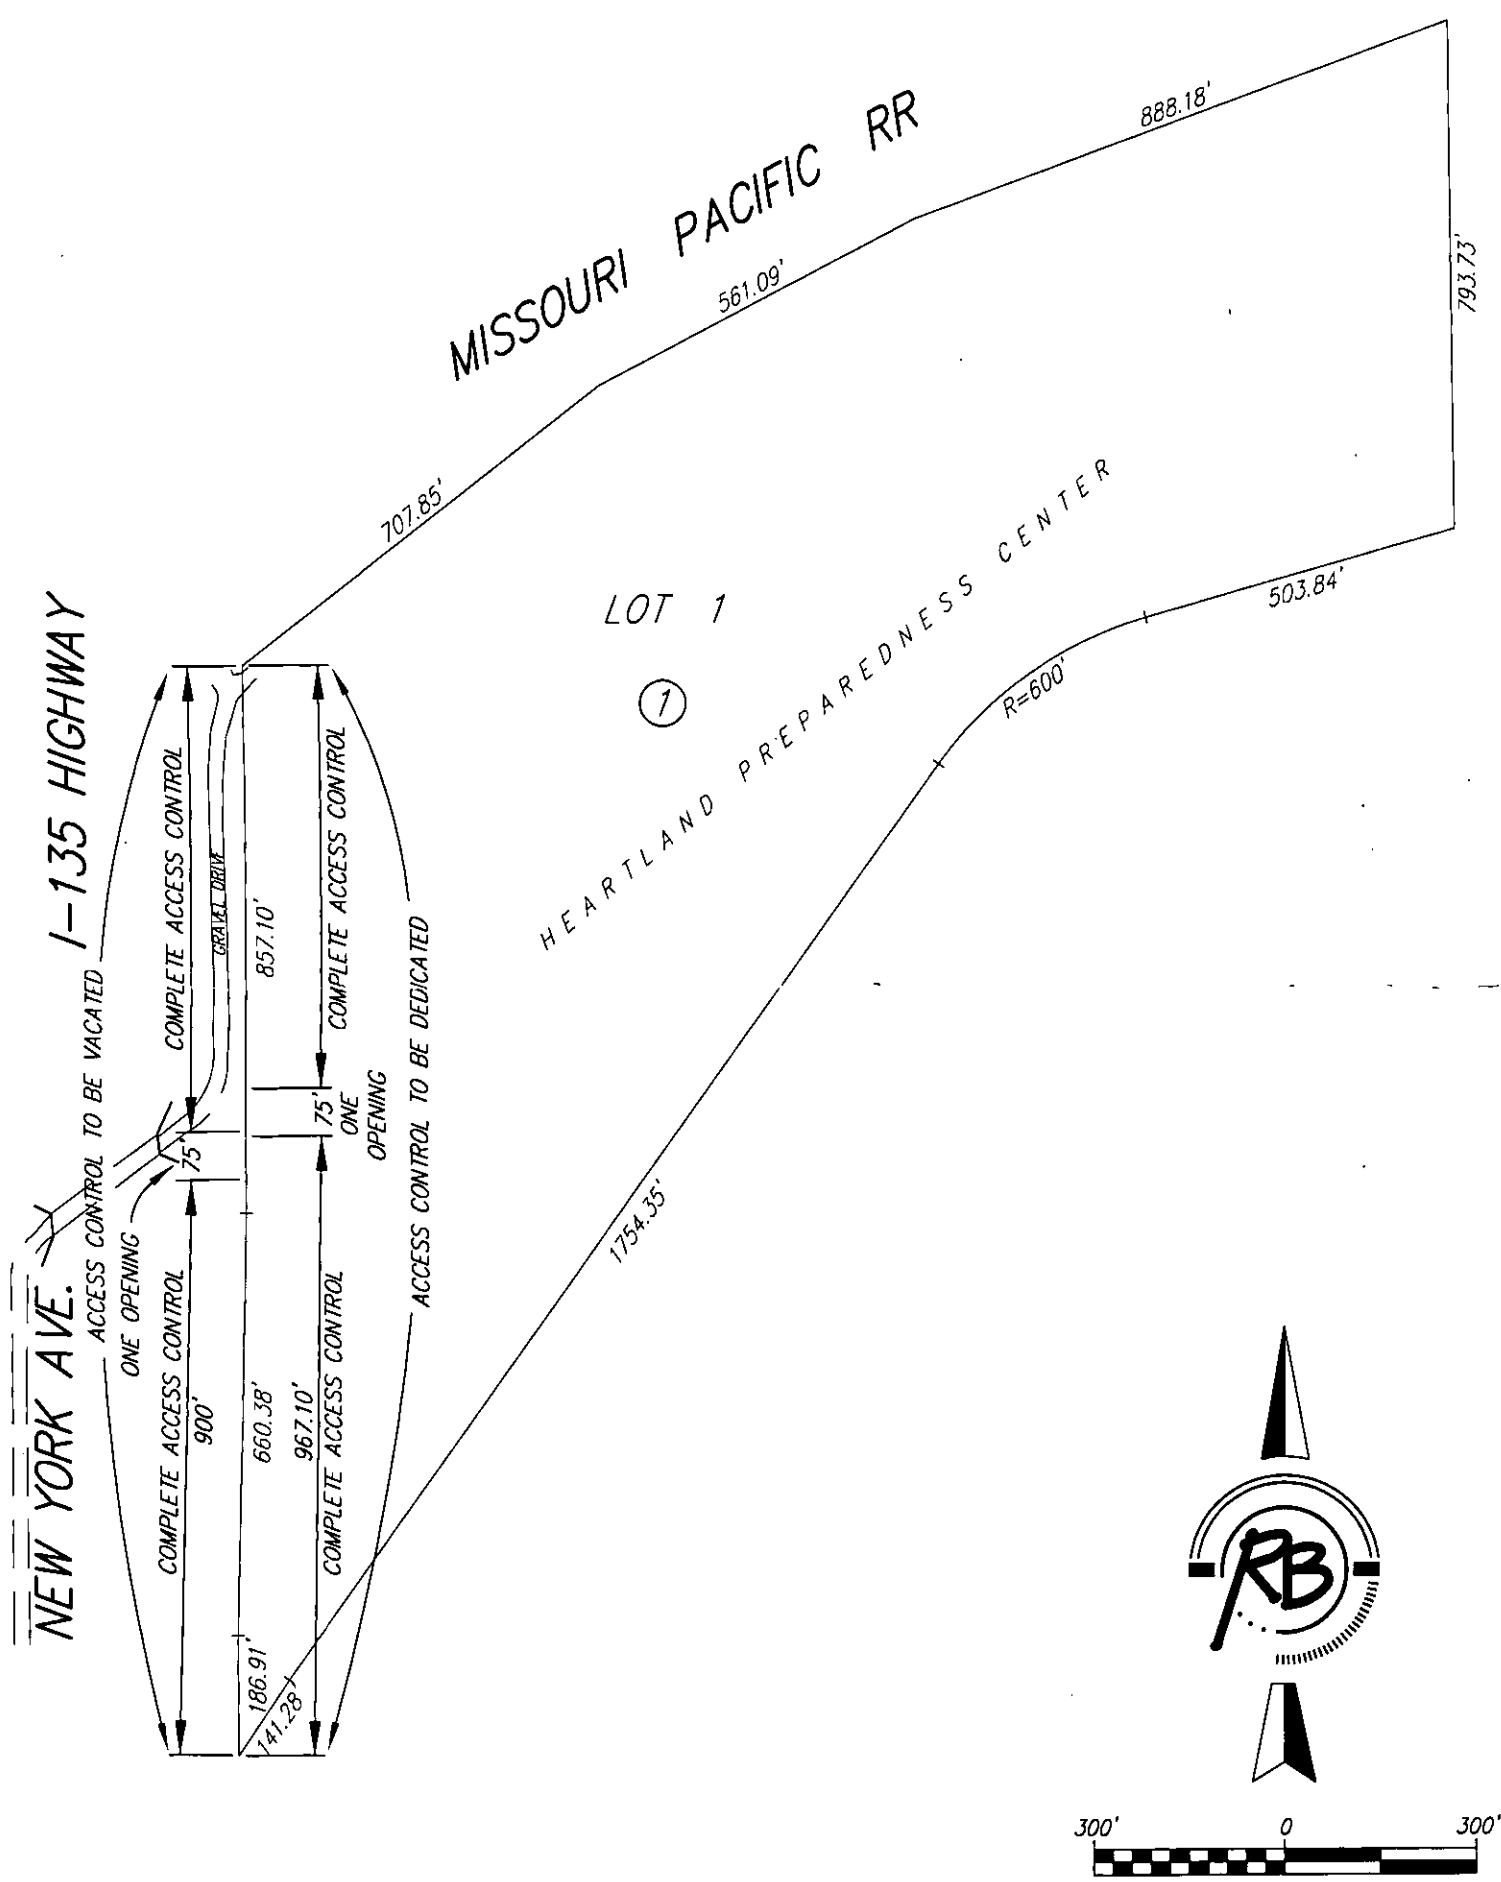

Ruggles & Bohm, P.A.
Engineering, Surveying, Land Planning
924 North Main (316) 264-8008
Wichita, Kansas 67203 (316) 264-4621 fax
www.rbkansas.com E-mail: info@rbkansas.com