Scale: 1" = 100'
November 24, '81
Bench Mark - R.R. Spike
in P.P., 45' SE of NE
Cor. Sec. 7, T29S, R1E.
Elev. 1257.34

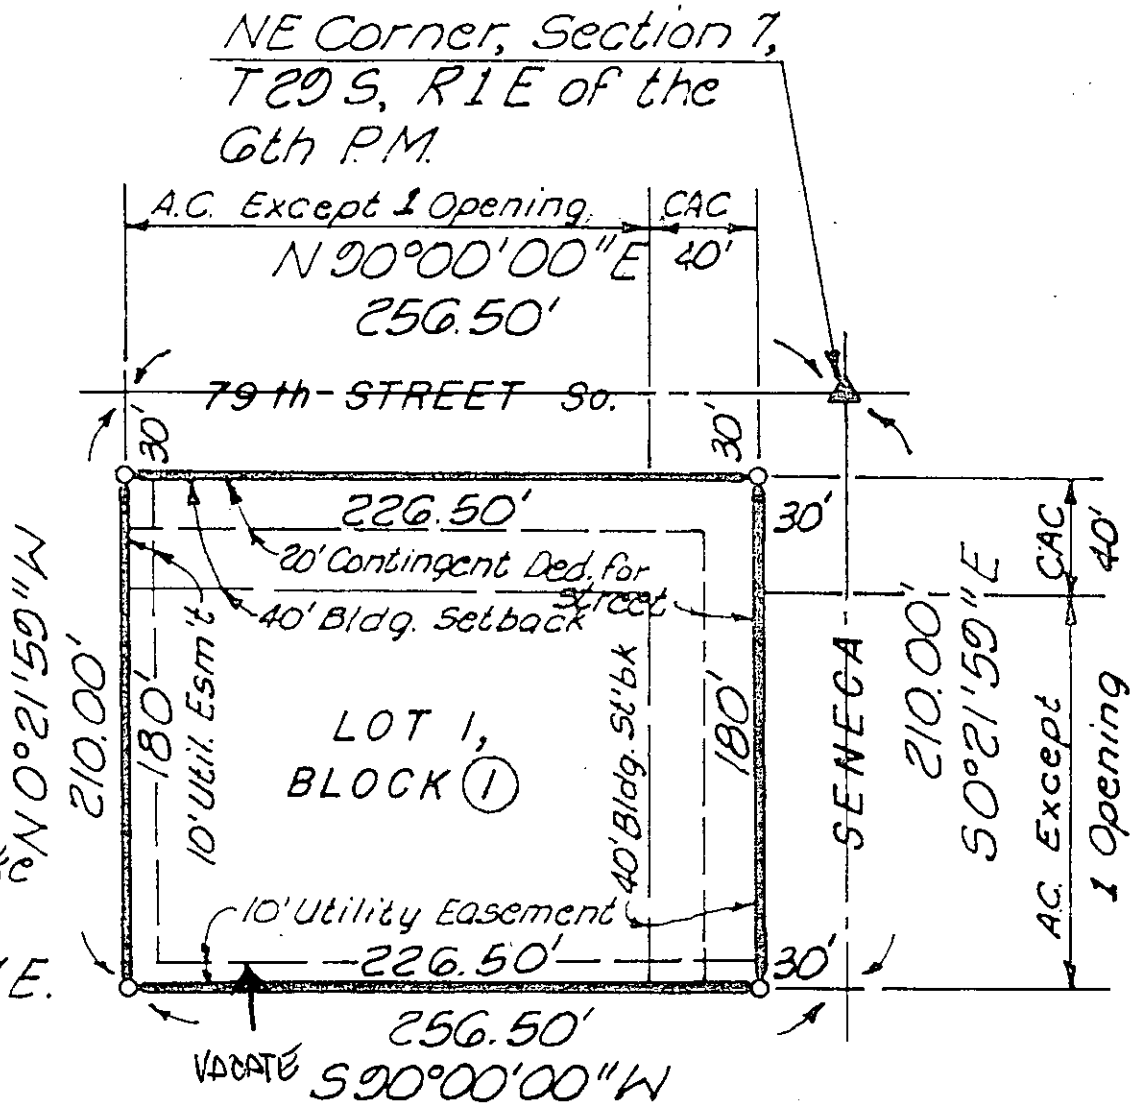

VAC 2010-10