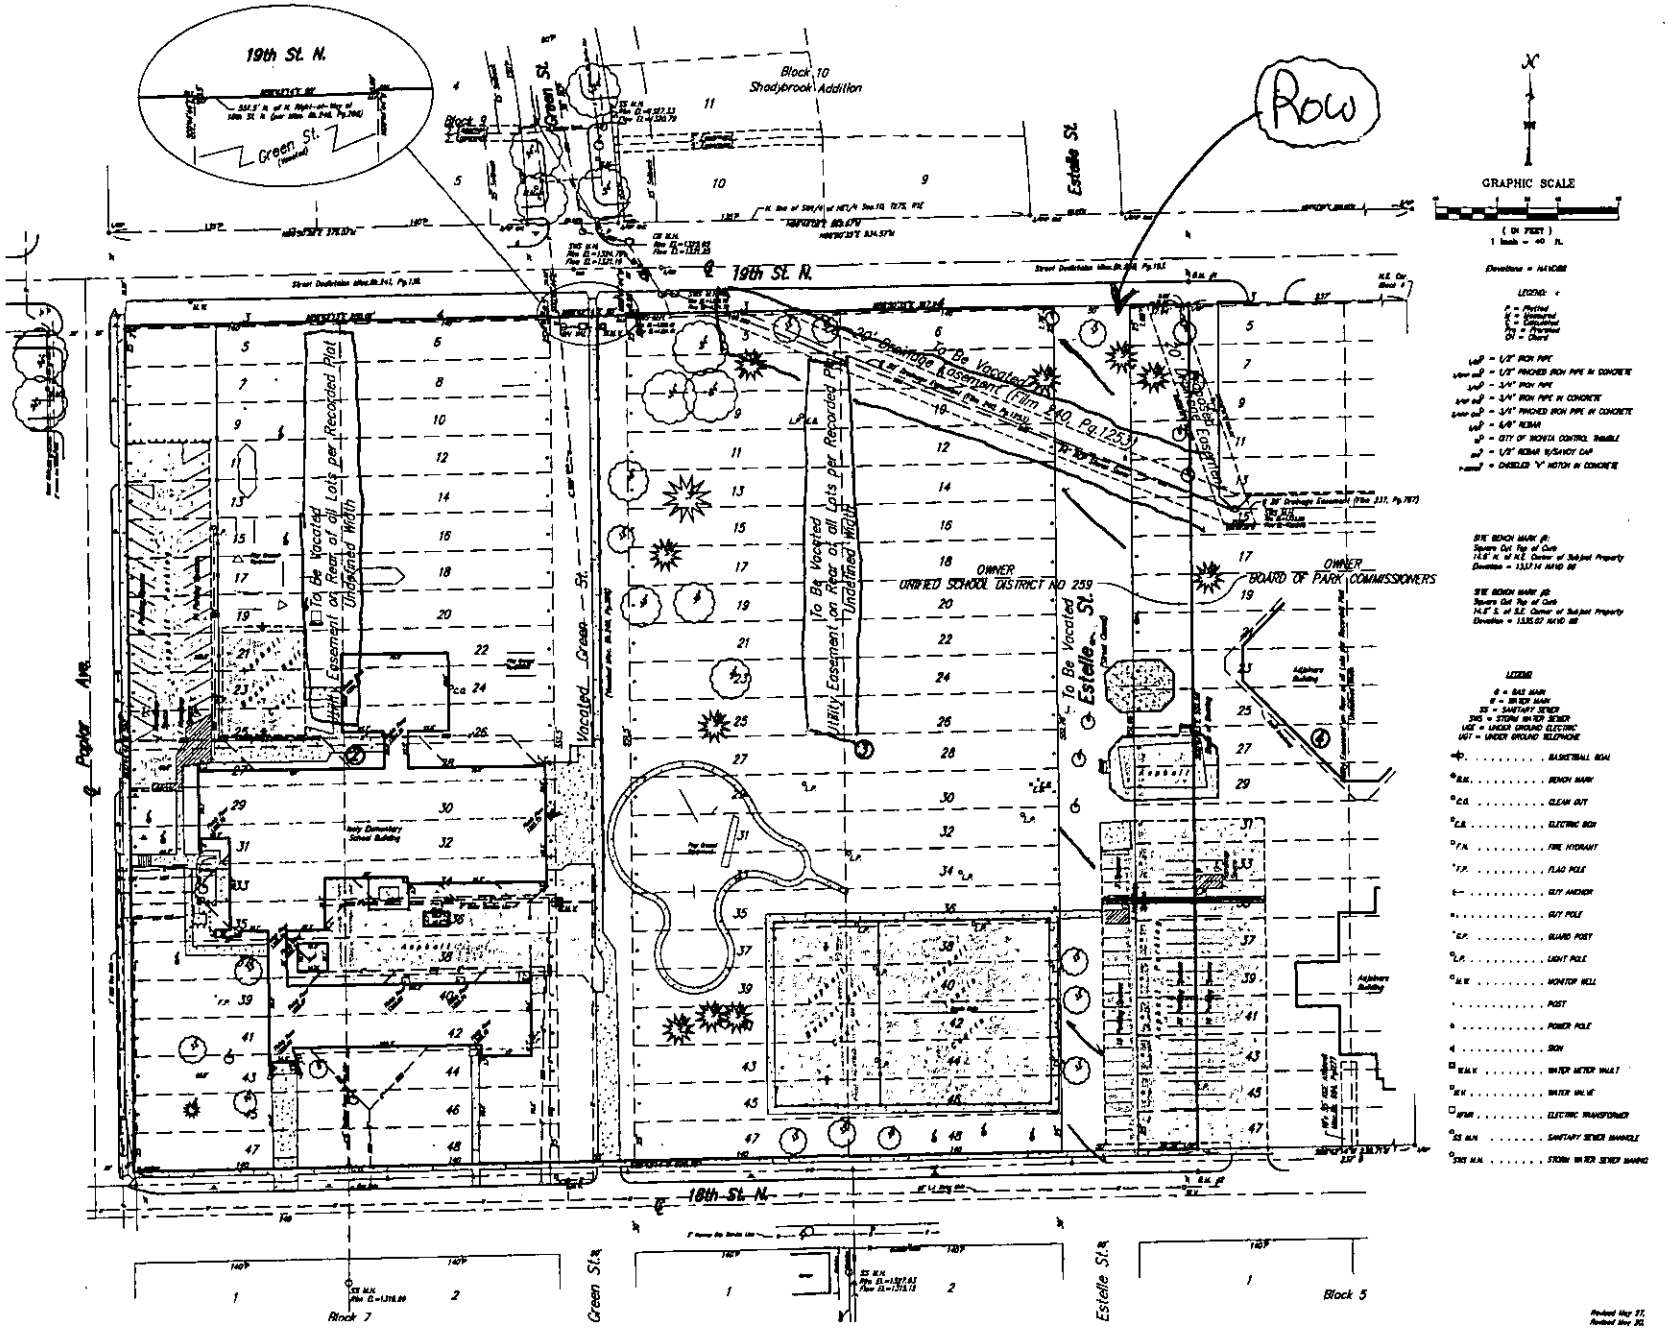

19th St. N.
Green St.
Block 10
Shadybrook Addition
ROW
Estelle St.
GRAPHIC SCALE
19th St. N.
To Be Vacated Drainage Easement (Film 240, Pg.1253)
To Be Vacated Utility Easement on Rear of all Lots per Recorded Plat Undefined Width
To Be Vacated Green St.
To Be Vacated Estelle St.
OWNER UNIFIED SCHOOL DISTRICT NO 259
OWNER BOARD OF PARK COMMISSIONERS
Poplar Ave.
18th St. N.
Block 7
Block 5

VAC2010-18