


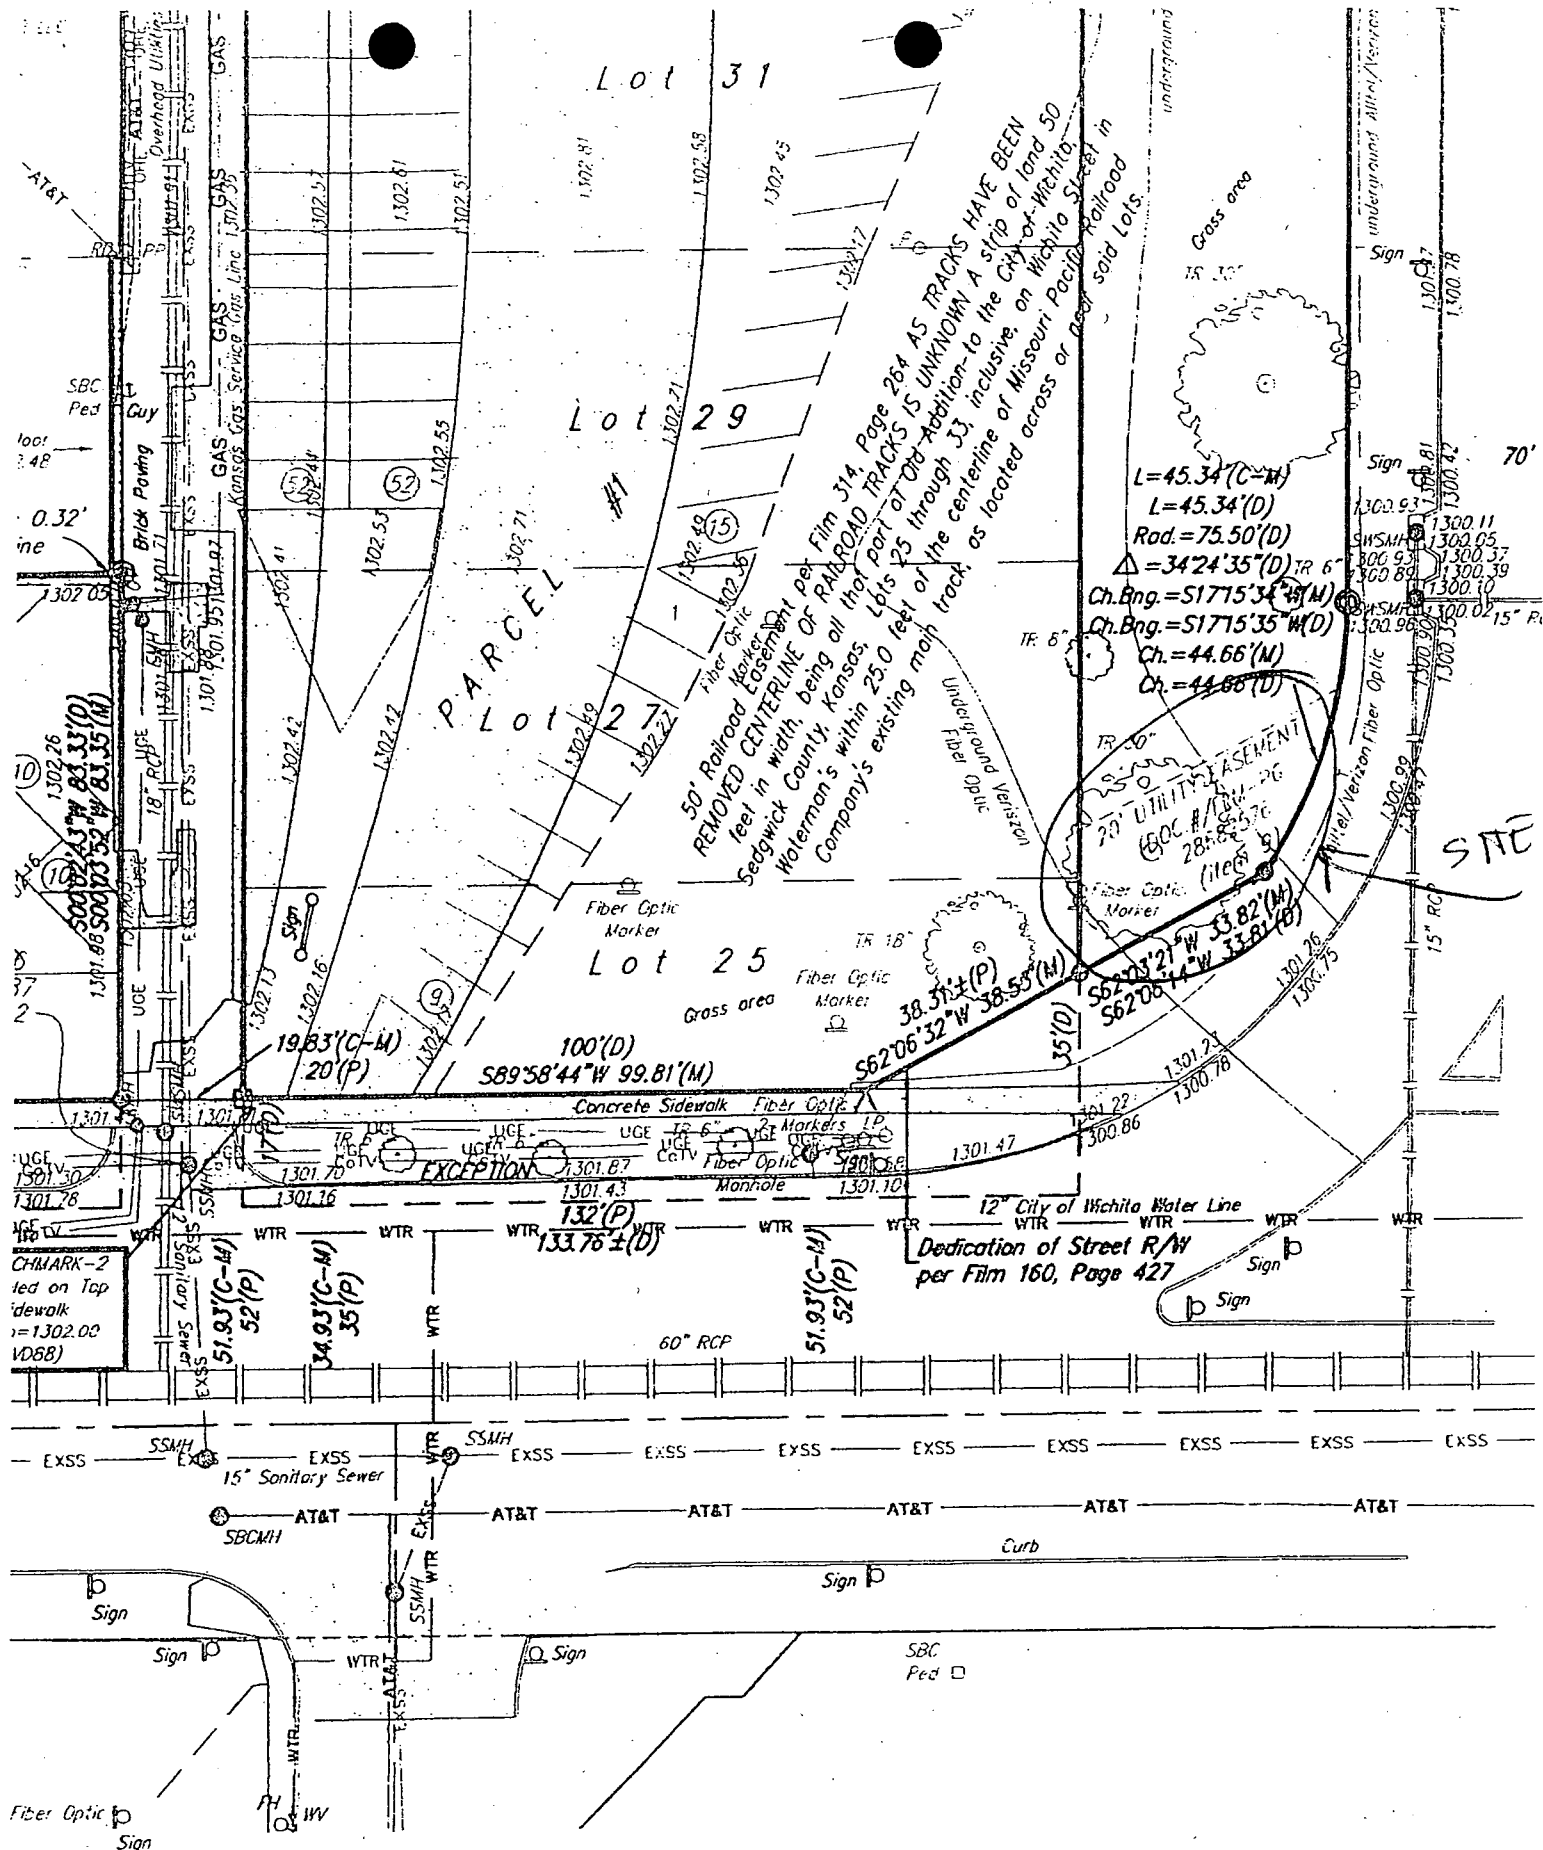

50' RAILROAD CENTERLINE OF RAILROAD TRACKS IS UNKNOWN A STRIP OF LAND 50 FEET IN WIDTH, BEING ALL THAT PORT OF OLD ADDITION TO THE CITY OF WICHITA, SEDGWICK COUNTY, KANSAS, LOTS 25 THROUGH 33, INCLUSIVE, ON WICHITA STREET, COMPANY'S EXISTING MAIN TRACK, AS LOCATED ACROSS OR NEAR SAID LOTS.

$L=45.34'(C-M)$
 $L=45.34'(D)$
 $Rad.=75.50'(D)$
 $\Delta=34.24'35''(D) TR 6'$
 $Ch. Eng.=S1715'34''W(M)$
 $Ch. Eng.=S1715'35''W(D)$
 $Ch.=44.66'(M)$
 $Ch.=44.66'(D)$

$S62.08'21''W 33.82'(M)$

Dedication of Street R/W per Film 160, Page 427

- CB = Catch Basin
- CO = Cleanout
- EB = Electric Box
- EMH = Electric Monohole
- FH = Fire Hydrant

