


REGENCY LAKES ADDITION

K-96 East Bound Off Ramp

Greenwich Rd.

ZONED: "CUP DP-234"

Reserve "A"

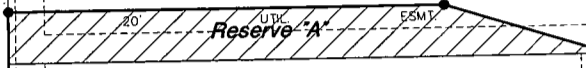

WATER LINE
DOC.#/FLM-PG: 29085929 8/20/2009

Lot 10

Lot 9

REGENCY LAKES COMMERCIAL 2ND ADDITION


New TRACT C
Part of Lot 11

Reserve "A"

New TRACT C
Part of Lot 11

ZONED: "CUP DP-234"

WALL
ESMT.
UTIL.
5
20

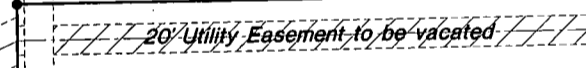

20' Utility Easement to be vacated

Revised
PARCEL B
Part of Lot 11

Lot Split: Doc.#/FLM-PG: 29165116
PARCEL A
Retail Use:
WORLD MARKET

ZONED: "CUP DP-234"

Retail Use:
SUPER TARGET

LEGEND



See Sheet 2/2 for Legal Descriptions
See attachment for municipal utilities generally shown per plans.



REGENCY LAKES COMMERCIAL 2ND ADD.

VAC 2011-01

VACATION CASE EXHIBIT

411 N. WEBB ROAD
WICHITA, KS. 67206
316-684-9600


BDL
DESIGN BY: BDL
DRAWN BY:

GJA
CHECKED BY:

JAN. 2011
DATE

10617
JOB NO.

1 / 2
SHEET/OF

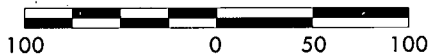

H:\CIVIL\96165\076631\Prop\076631s.dwg 4/3/2008 11:58:11 AM CDT