PC 85-78

NEWMARK

AN ADDITION TO WICHITA,

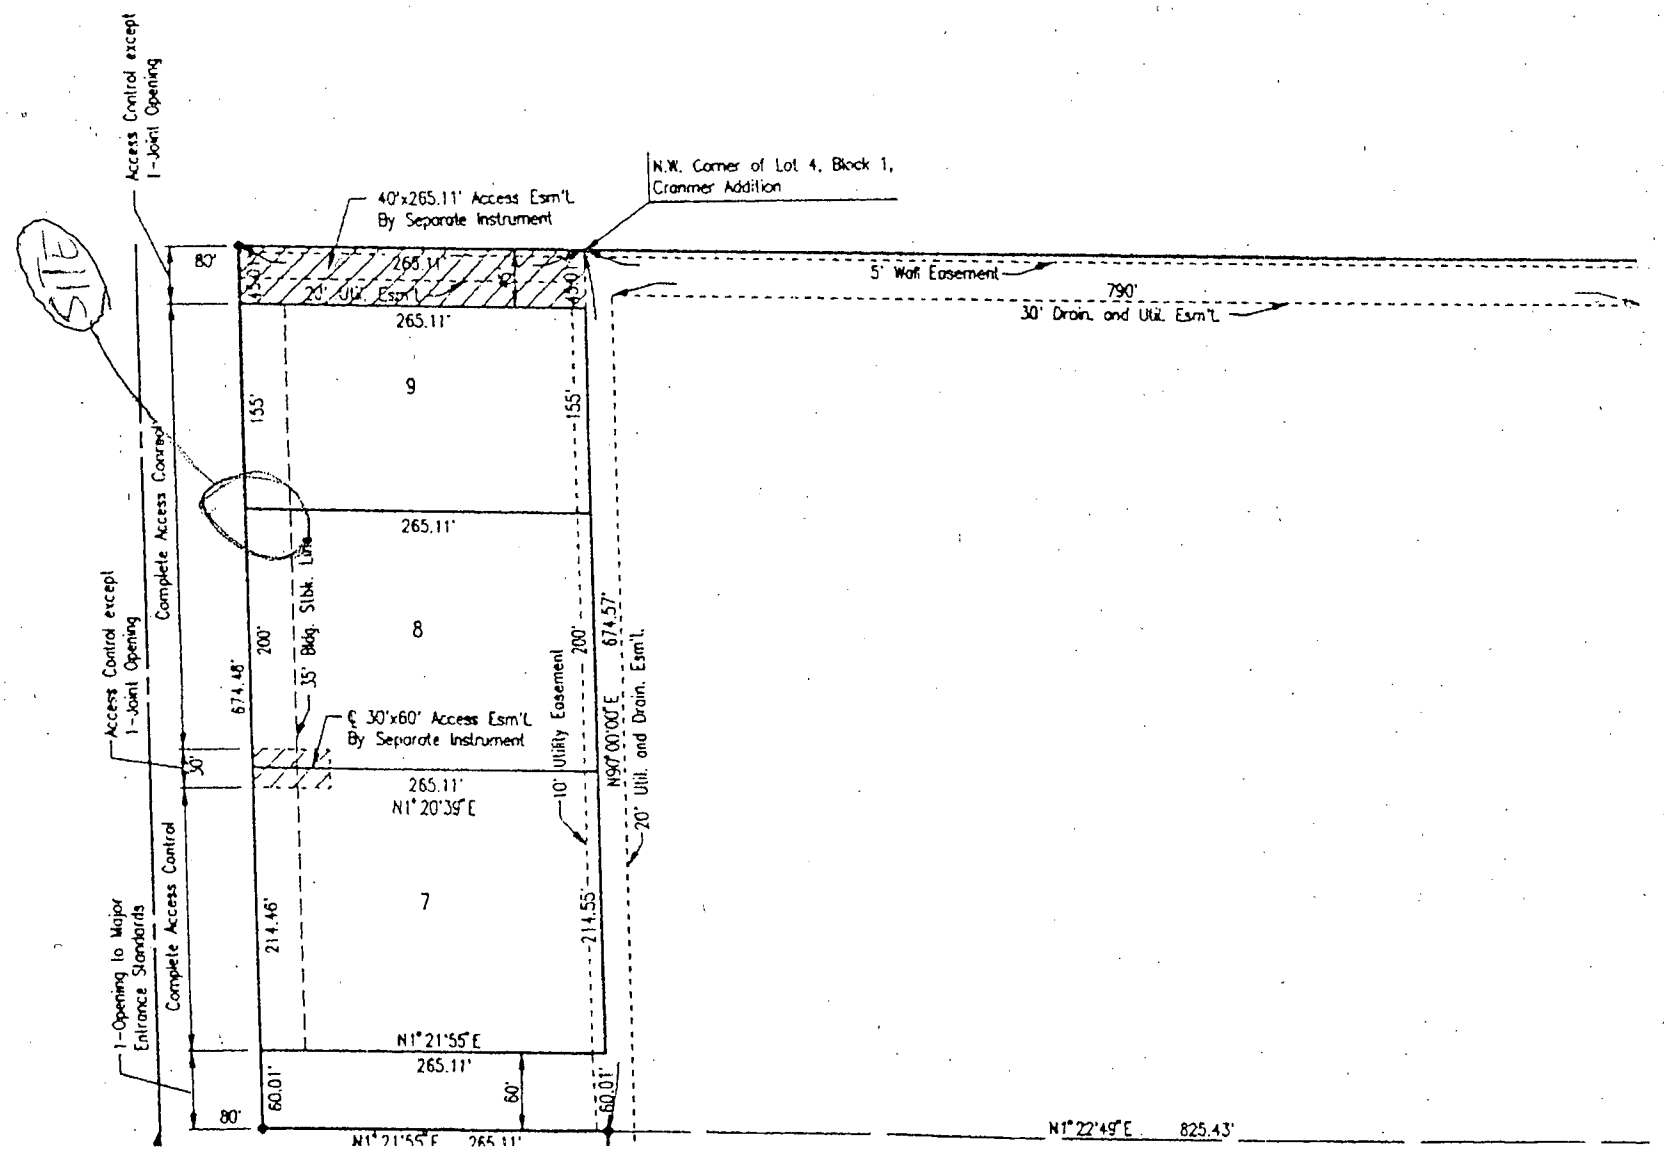

VAC2012-04