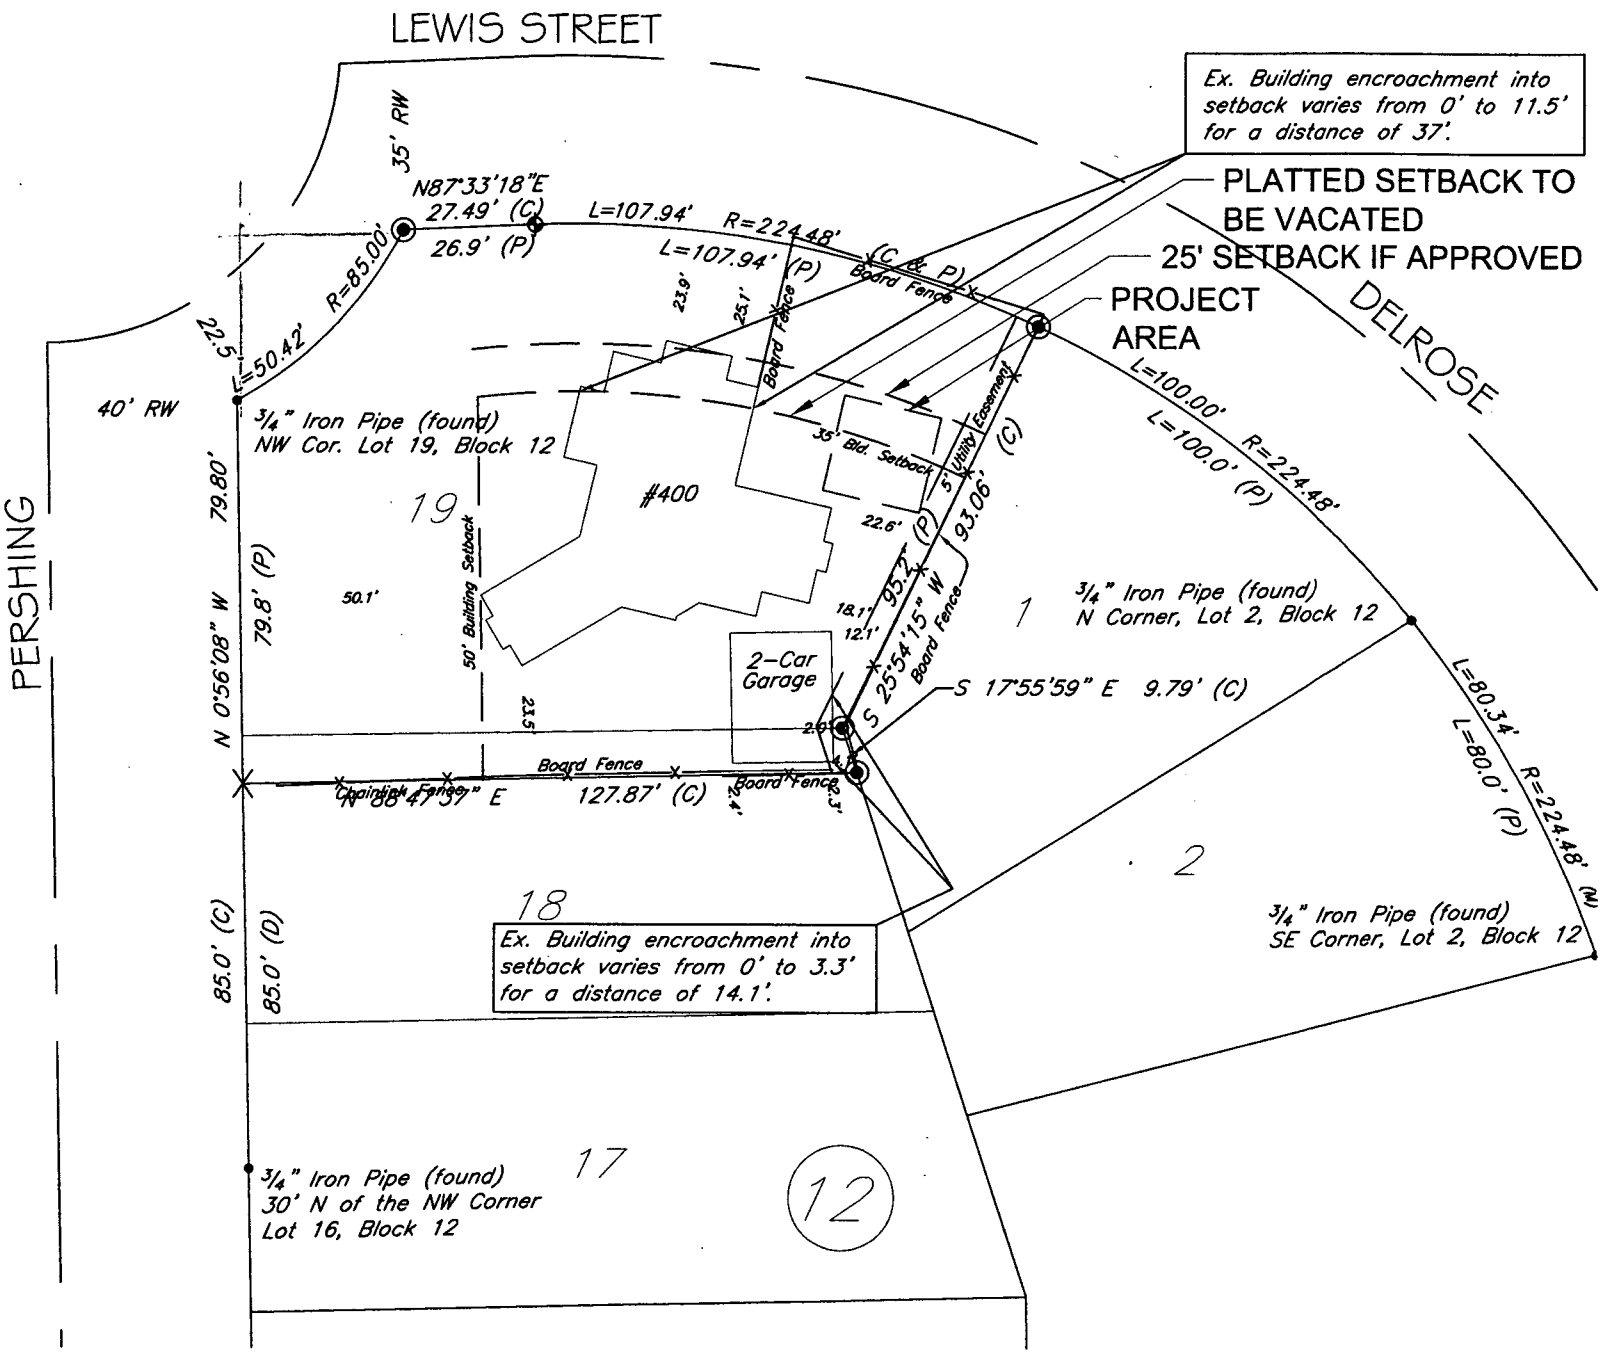

Skinner Design Studios
Landscape Architecture Urban Design Environmental Art
P: 316.260.9950 C: 316.304.2865 E: kskinner@skinnerdesignstudios.com

Site Plan - Vacation Exhibit

Scale: 1"=40'-0"

copyright 2012