


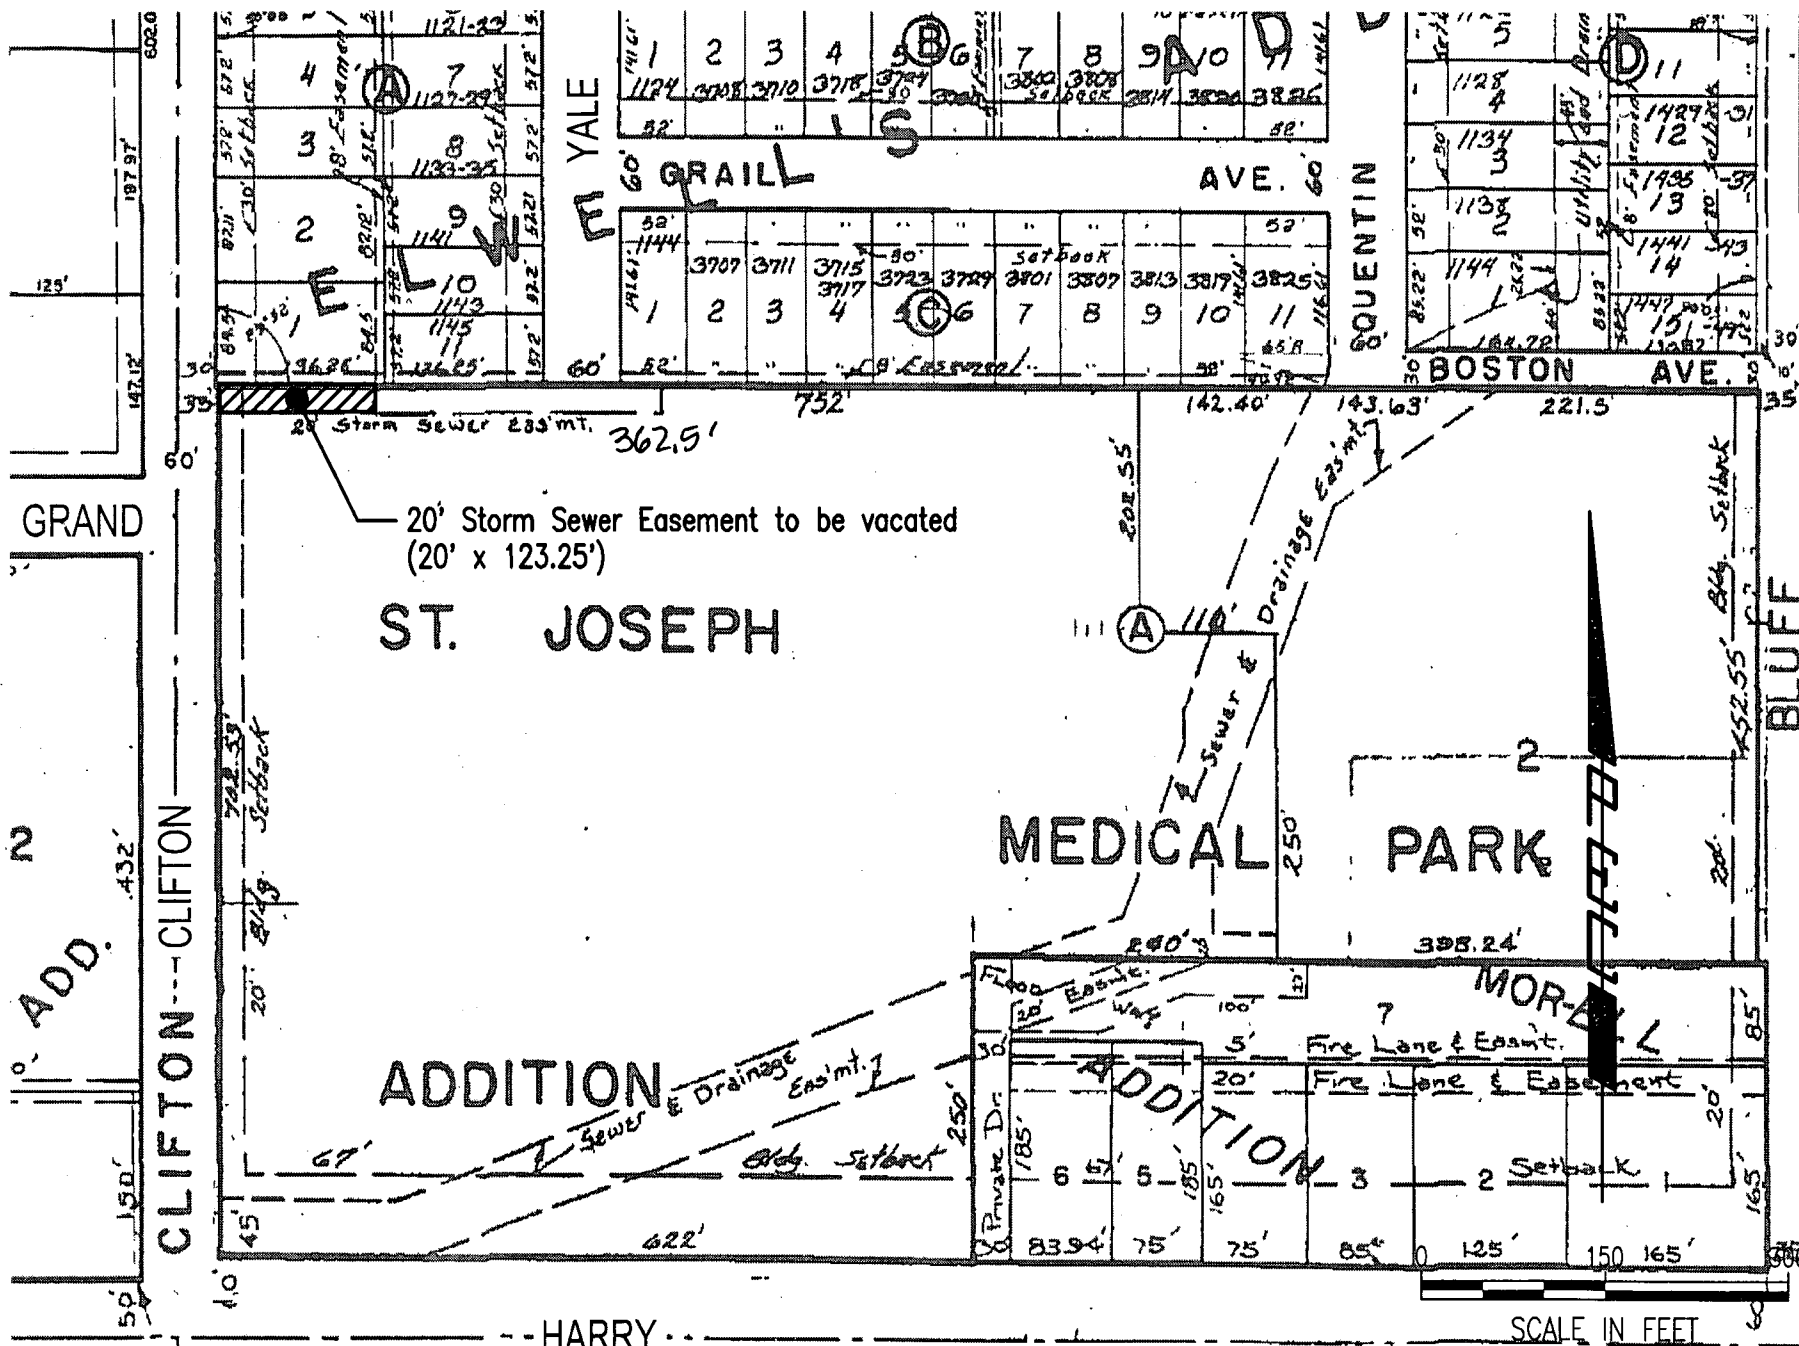

• HARRY •