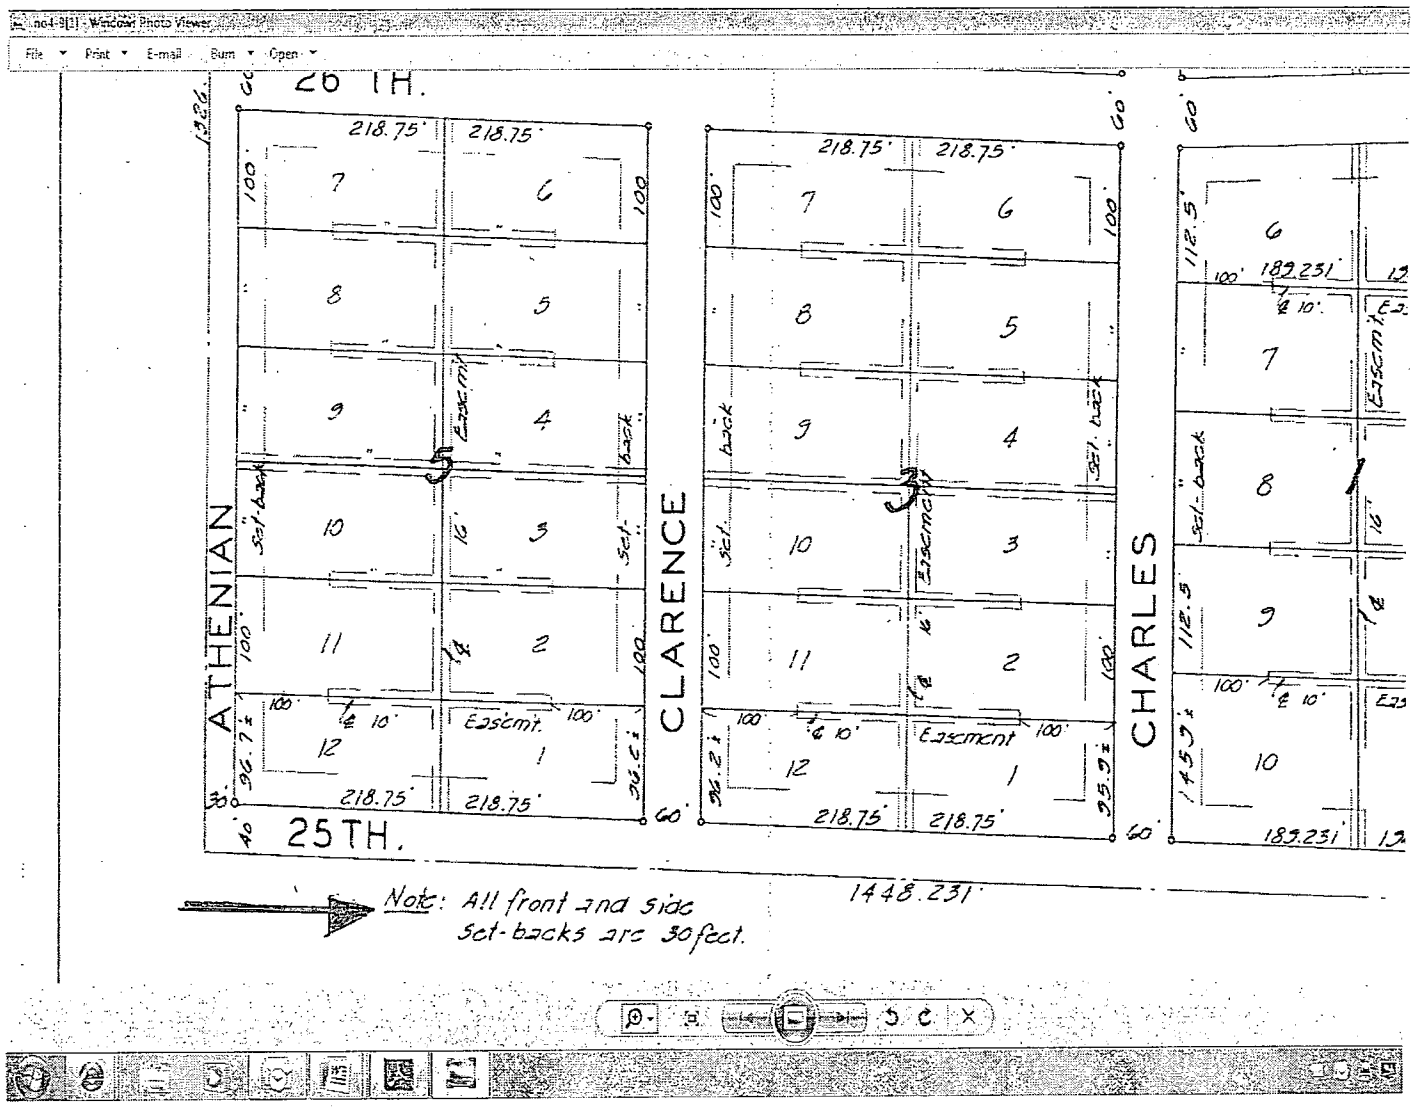
26 TH.
25TH.
ATHENIAN
CLARENCE
CHARLES
218.75'
100'
Easemt.
Set. back
1448.231'
Note: All front and side set-backs are 30 feet.

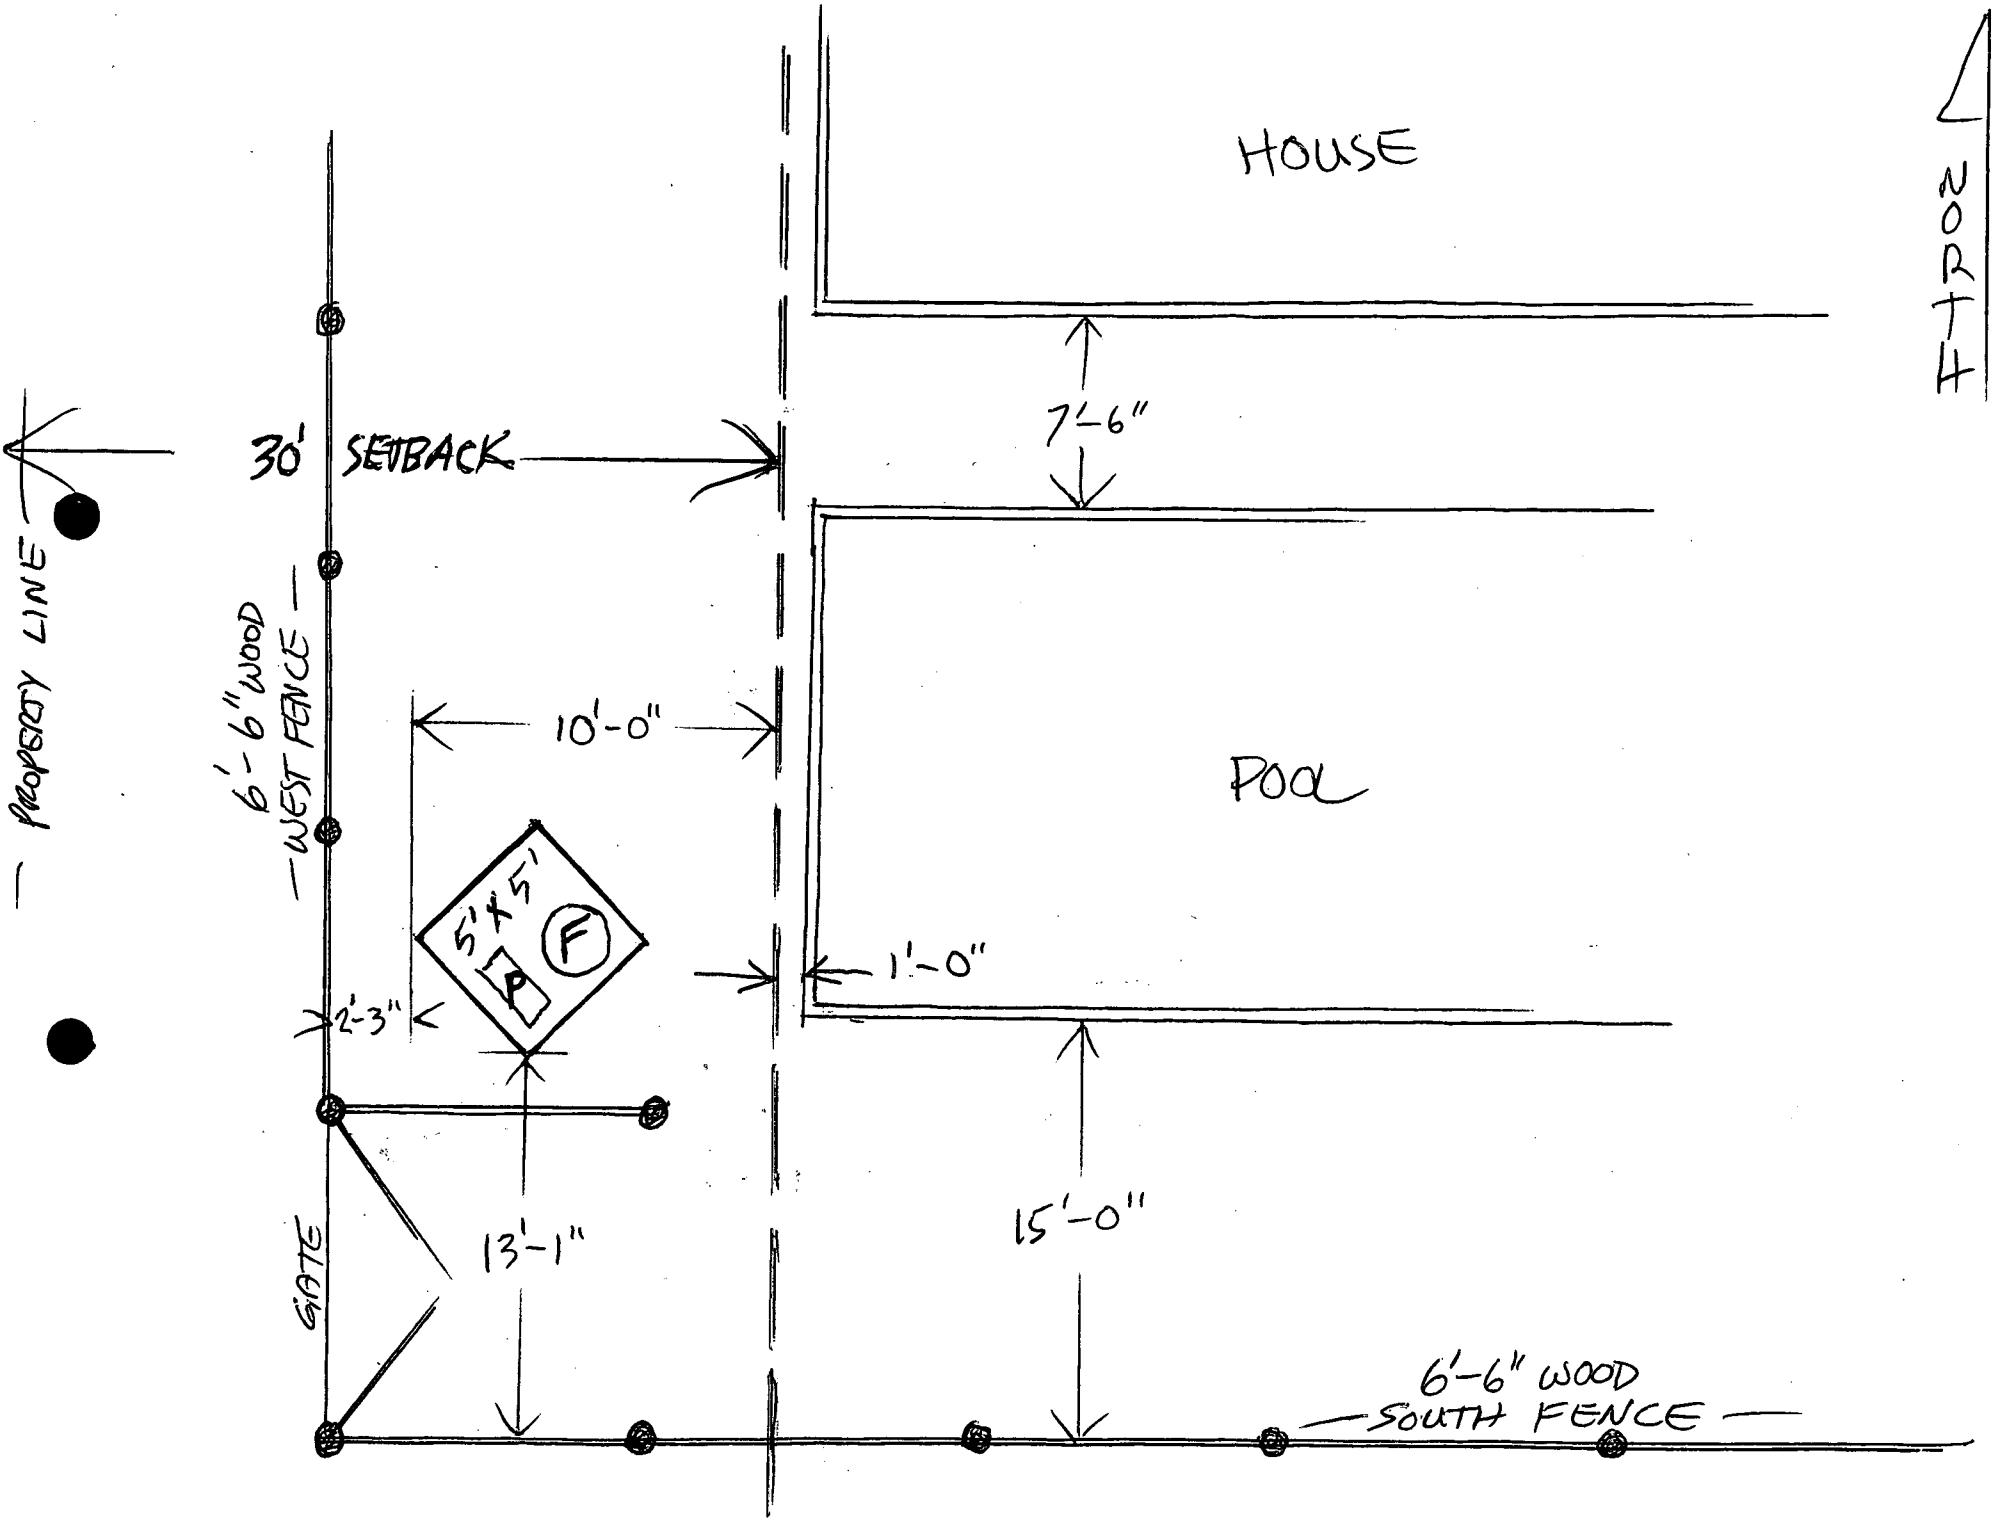
HOUSE
NORTH
PROPERTY LINE
30' SETBACK
7'-6"
6'-6" WOOD
WEST FENCE
10'-0"
POOL
5'x5'
F
P
2'-3"
1'-0"
GATE
13'-1"
15'-0"
6'-6" WOOD
SOUTH FENCE

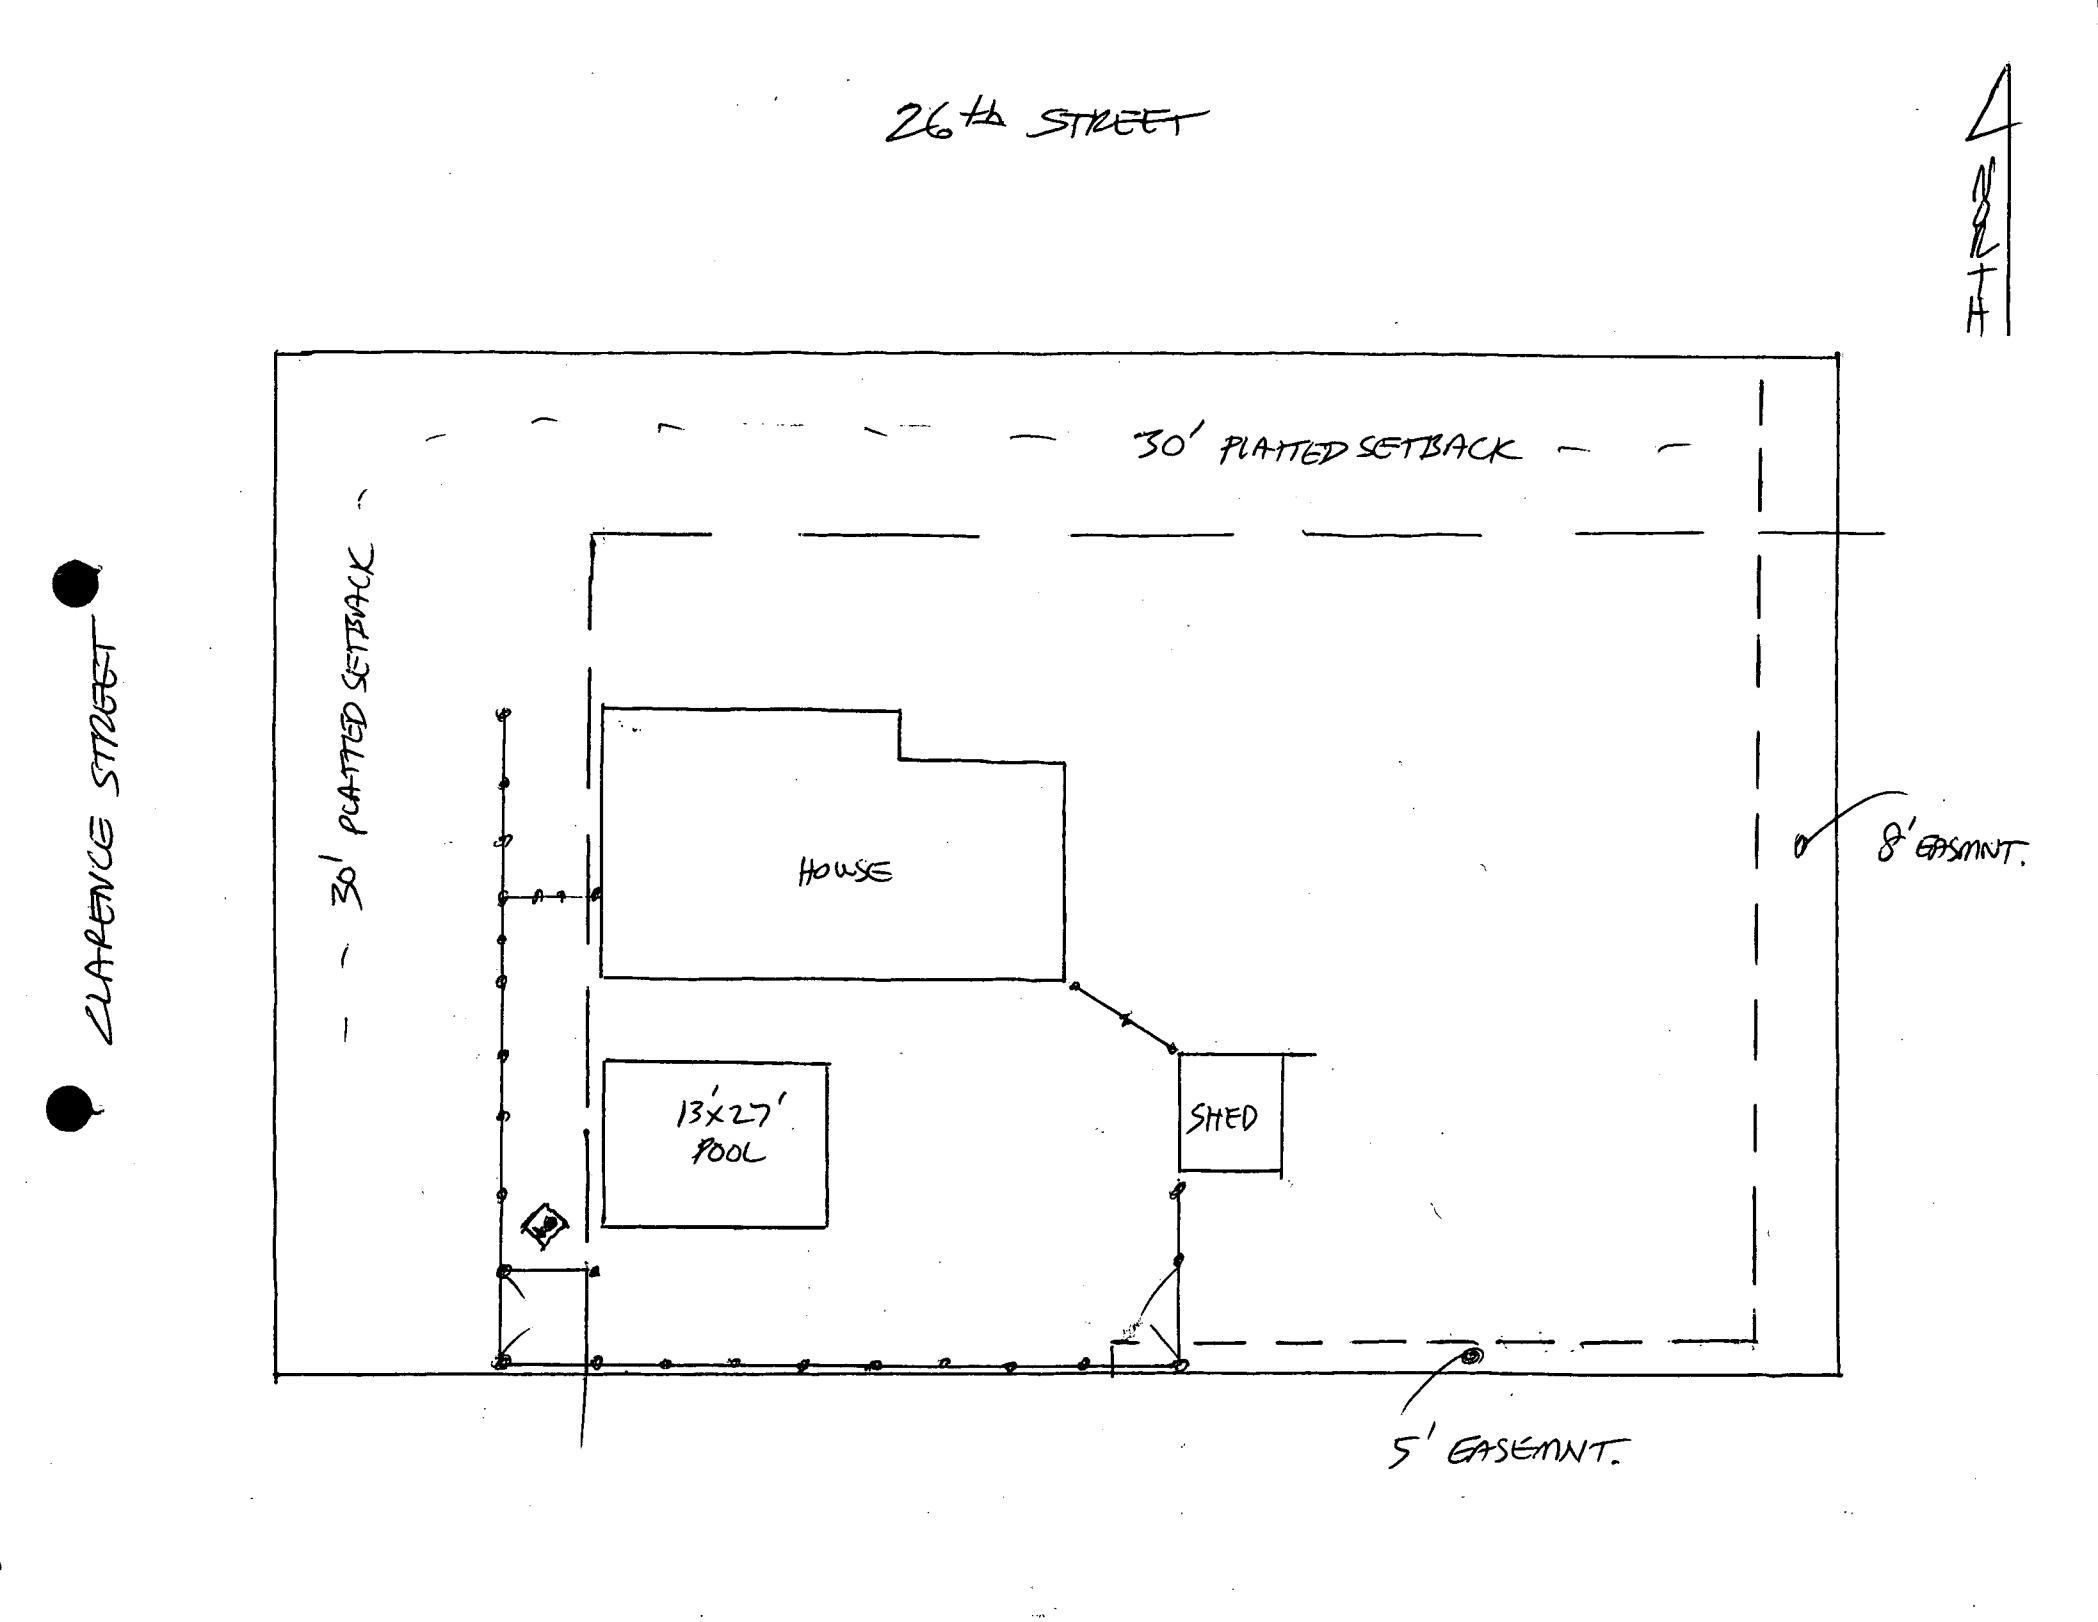
26th STREET
NORTH
CLARENCE STREET
30' PLATTED SETBACK
30' PLATTED SETBACK
HOUSE
13'x27' POOL
SHED
8' EASMNT.
5' EASEMNT.

BLD2012 -01600

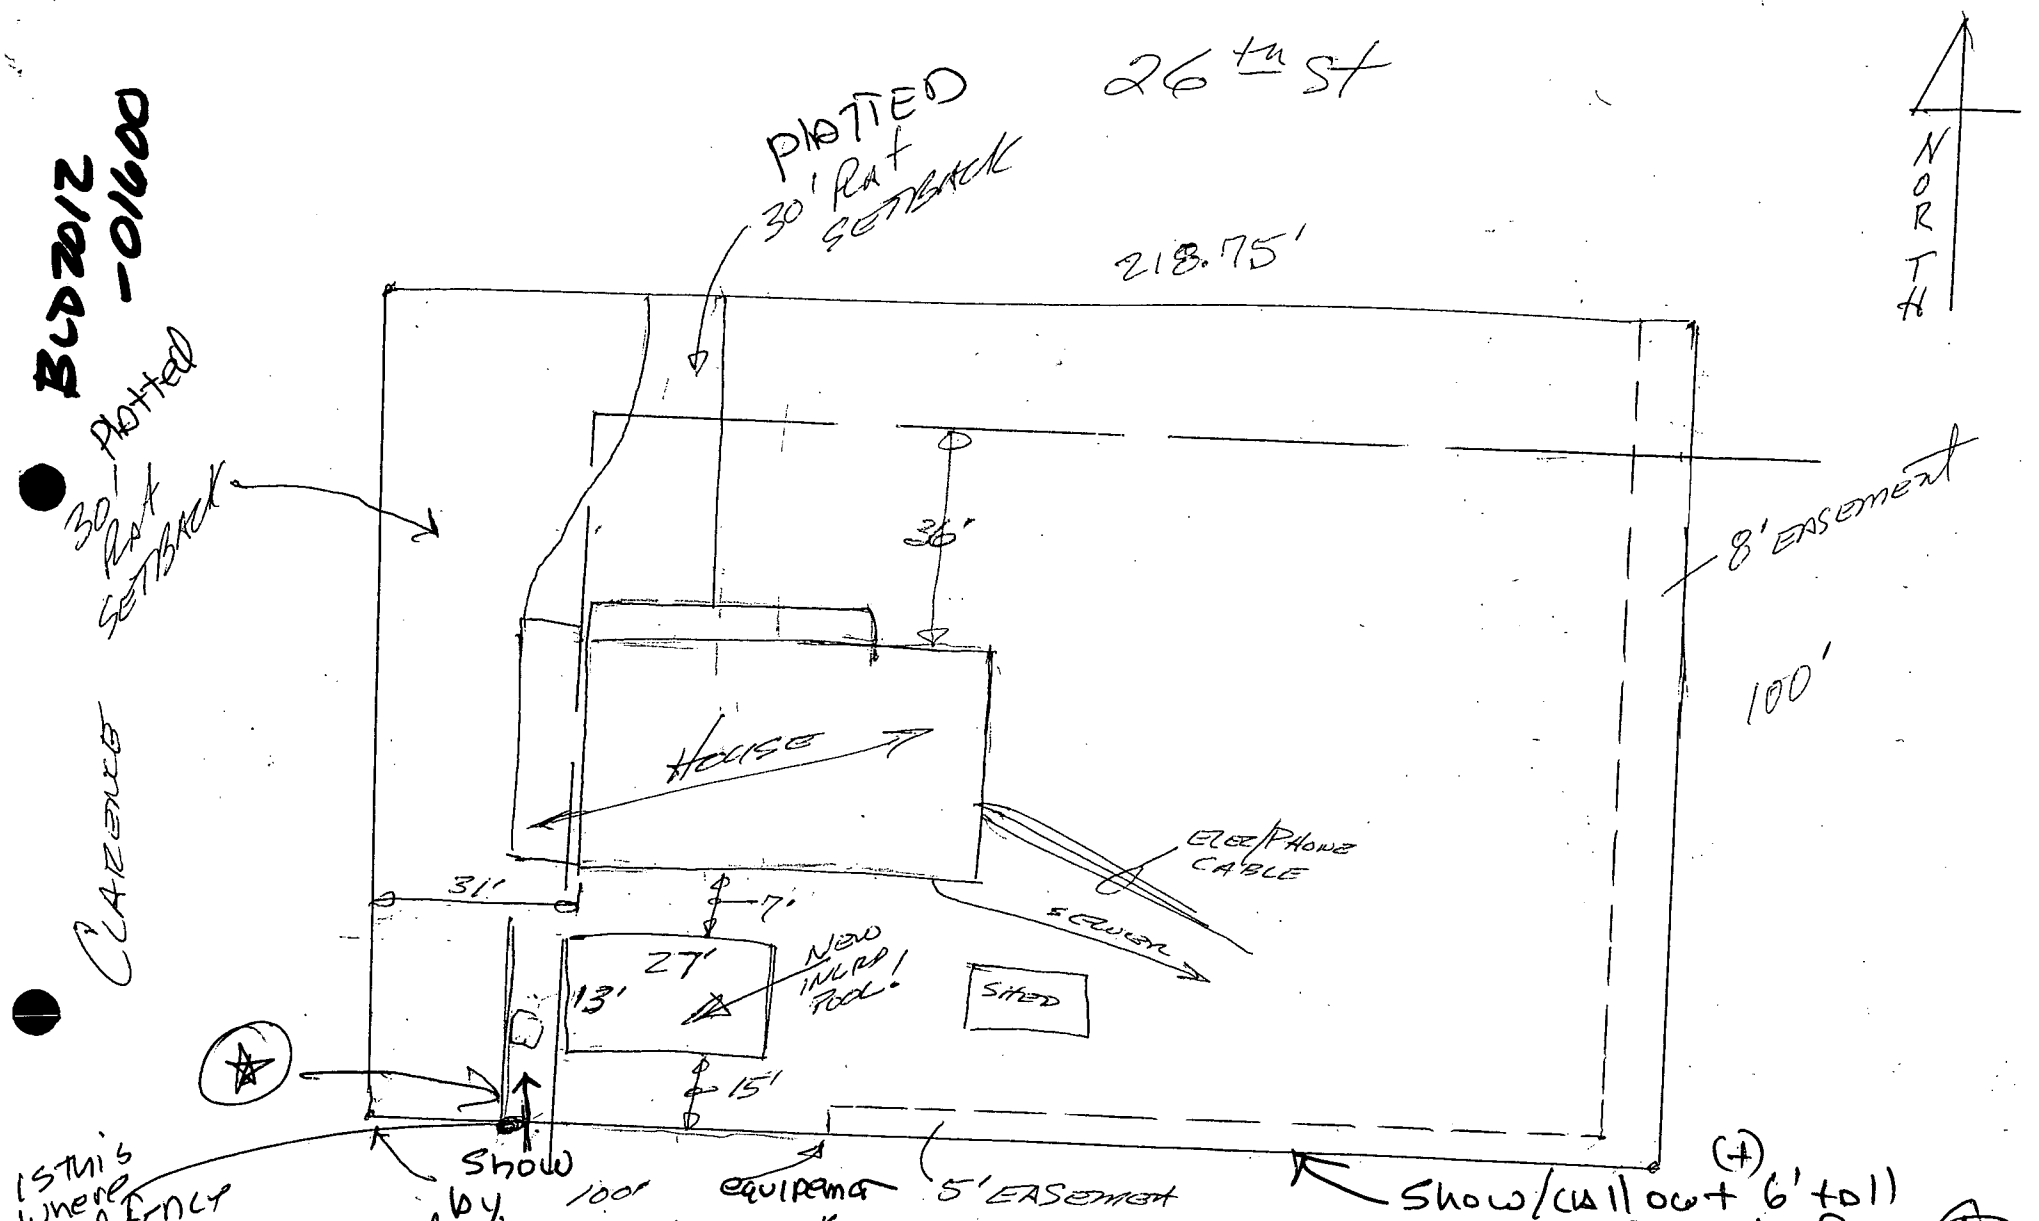

is this where wood fence located on South side ends? if so, say so

1931 W 26th St N

Lot 7 Block 3

Northwest Gardens Addn

13 June 2012