



EXHIBIT


PART OF GREAT PLAINS BUSINESS PARK 4TH ADDITION

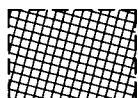

INDICATES AREA OF LEGAL DESCRIPTION
FOR DRAINAGE EASEMENT VACATION

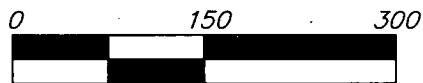

INDICATES AREA OF LEGAL DESCRIPTION
FOR DRAINAGE EASEMENT GRANT

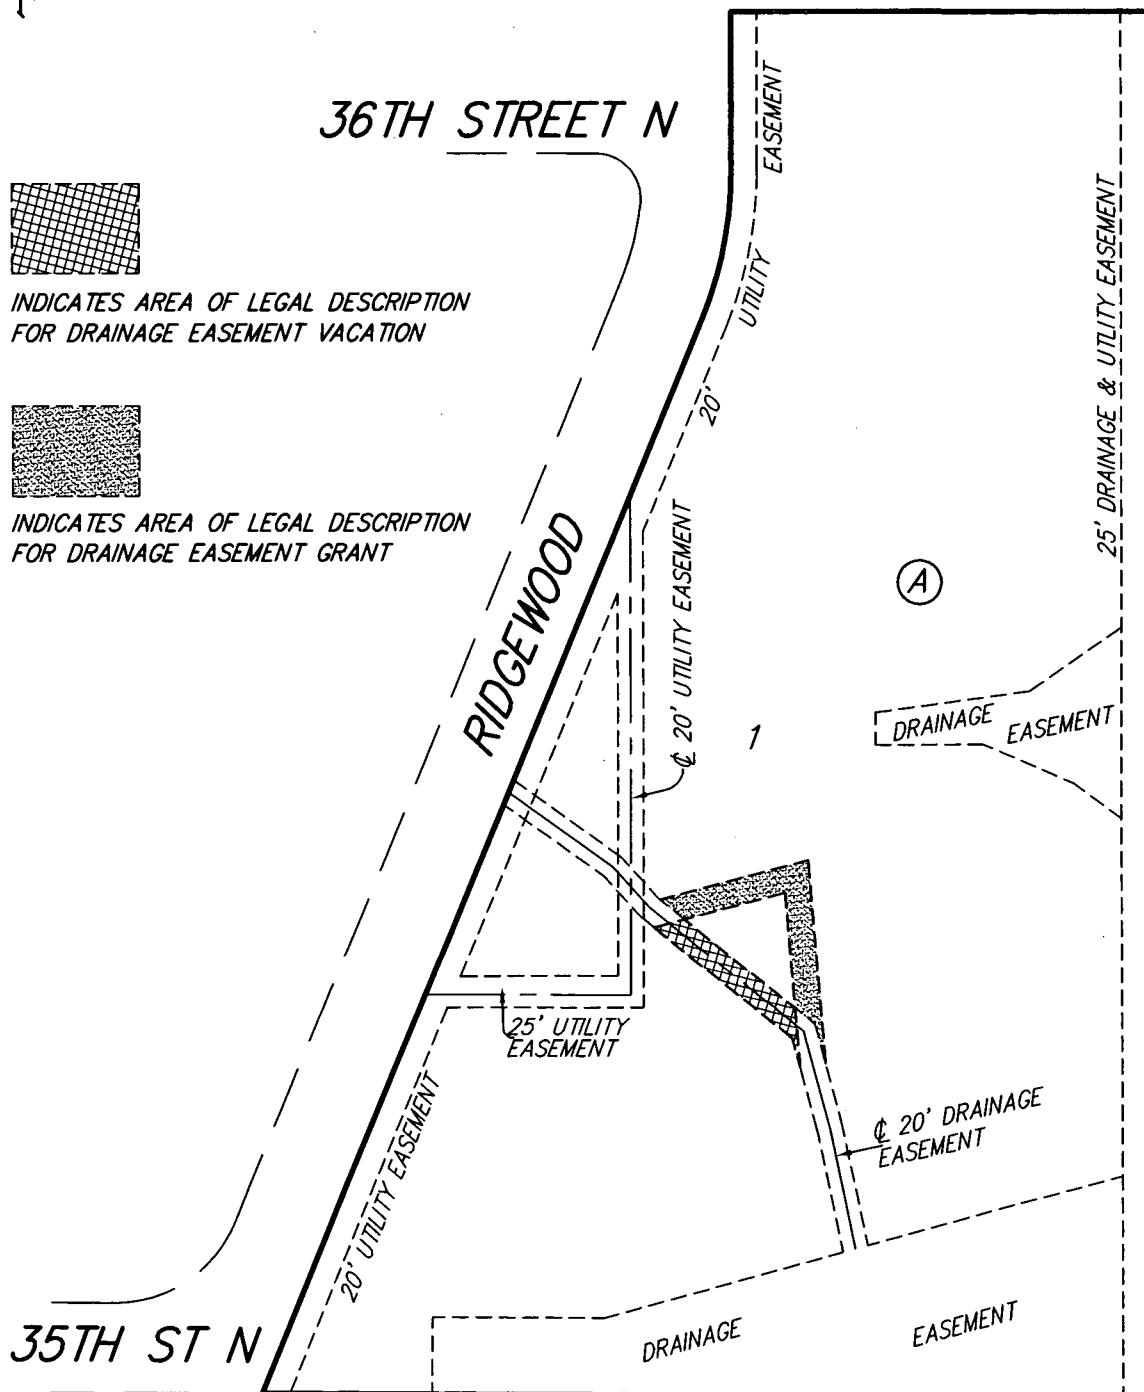

K-96 EXPRESSWAY
(COND. CASE 88C-3017)

7 NOV 2012

