



Wichita-Sedgwick County Metropolitan Area Planning Department

September 12, 2013


Kenneth L. Helms
242 N. Mead, Apt 3-A
Wichita, KS, 67202

Ref: VAC2012-00047 - Request to vacate a portion of public street right-of-way dedicated by separate instrument (Calais Street), generally located south of 31st Street South, east of Greenwich Road.

Dear Mr. Helms:

At the Wednesday, September 11, 2013, meeting of the Sedgwick County Board of County Commissioners the above-referenced vacation request was approved. If you have any questions concerning this application, please contact our office at 268-4494.


Sincerely,

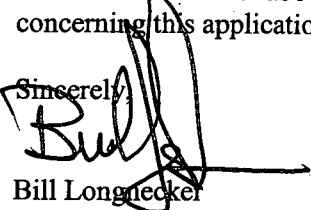

Bill Longnecker
Senior Planner

BL:kw

cc: Ivan & Soubanh Whitson, 11935 Calais Ct., Wichita, KS, 67210
Bob Parnacott – Assistant County Counselor (e-mail)
Jim Weber - Sedgwick County Public Works Engineer (e-mail)
Kelly Dixon - MABCD (e-mail)

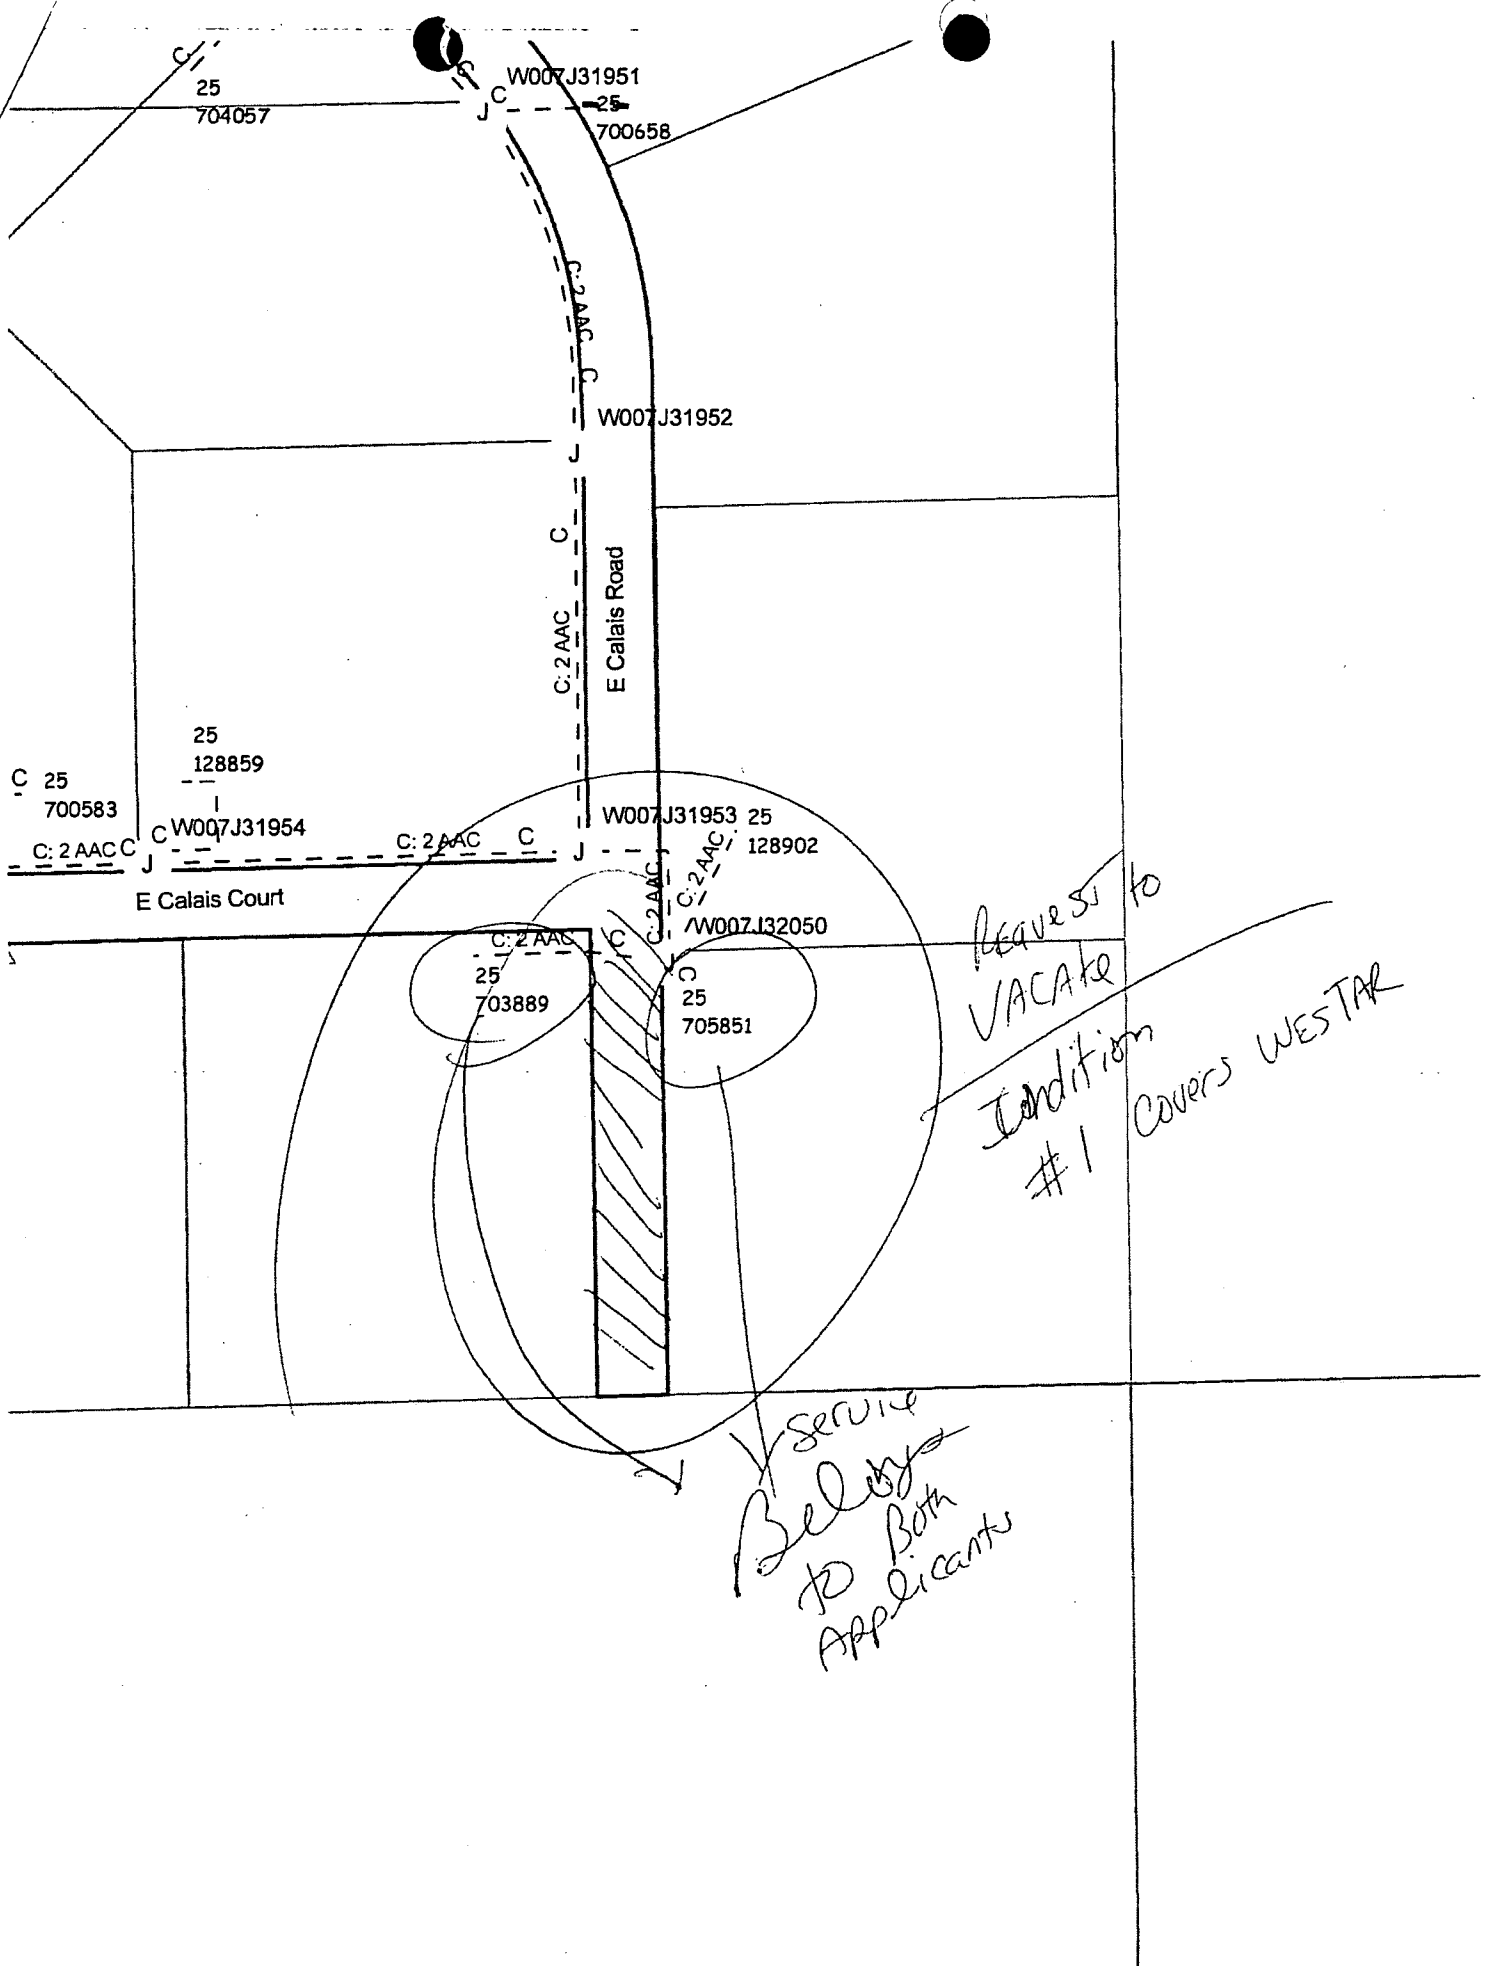

N.W. ¼ SEC. 10, TWP. 28S, R.2E.

VAC2012-47

