


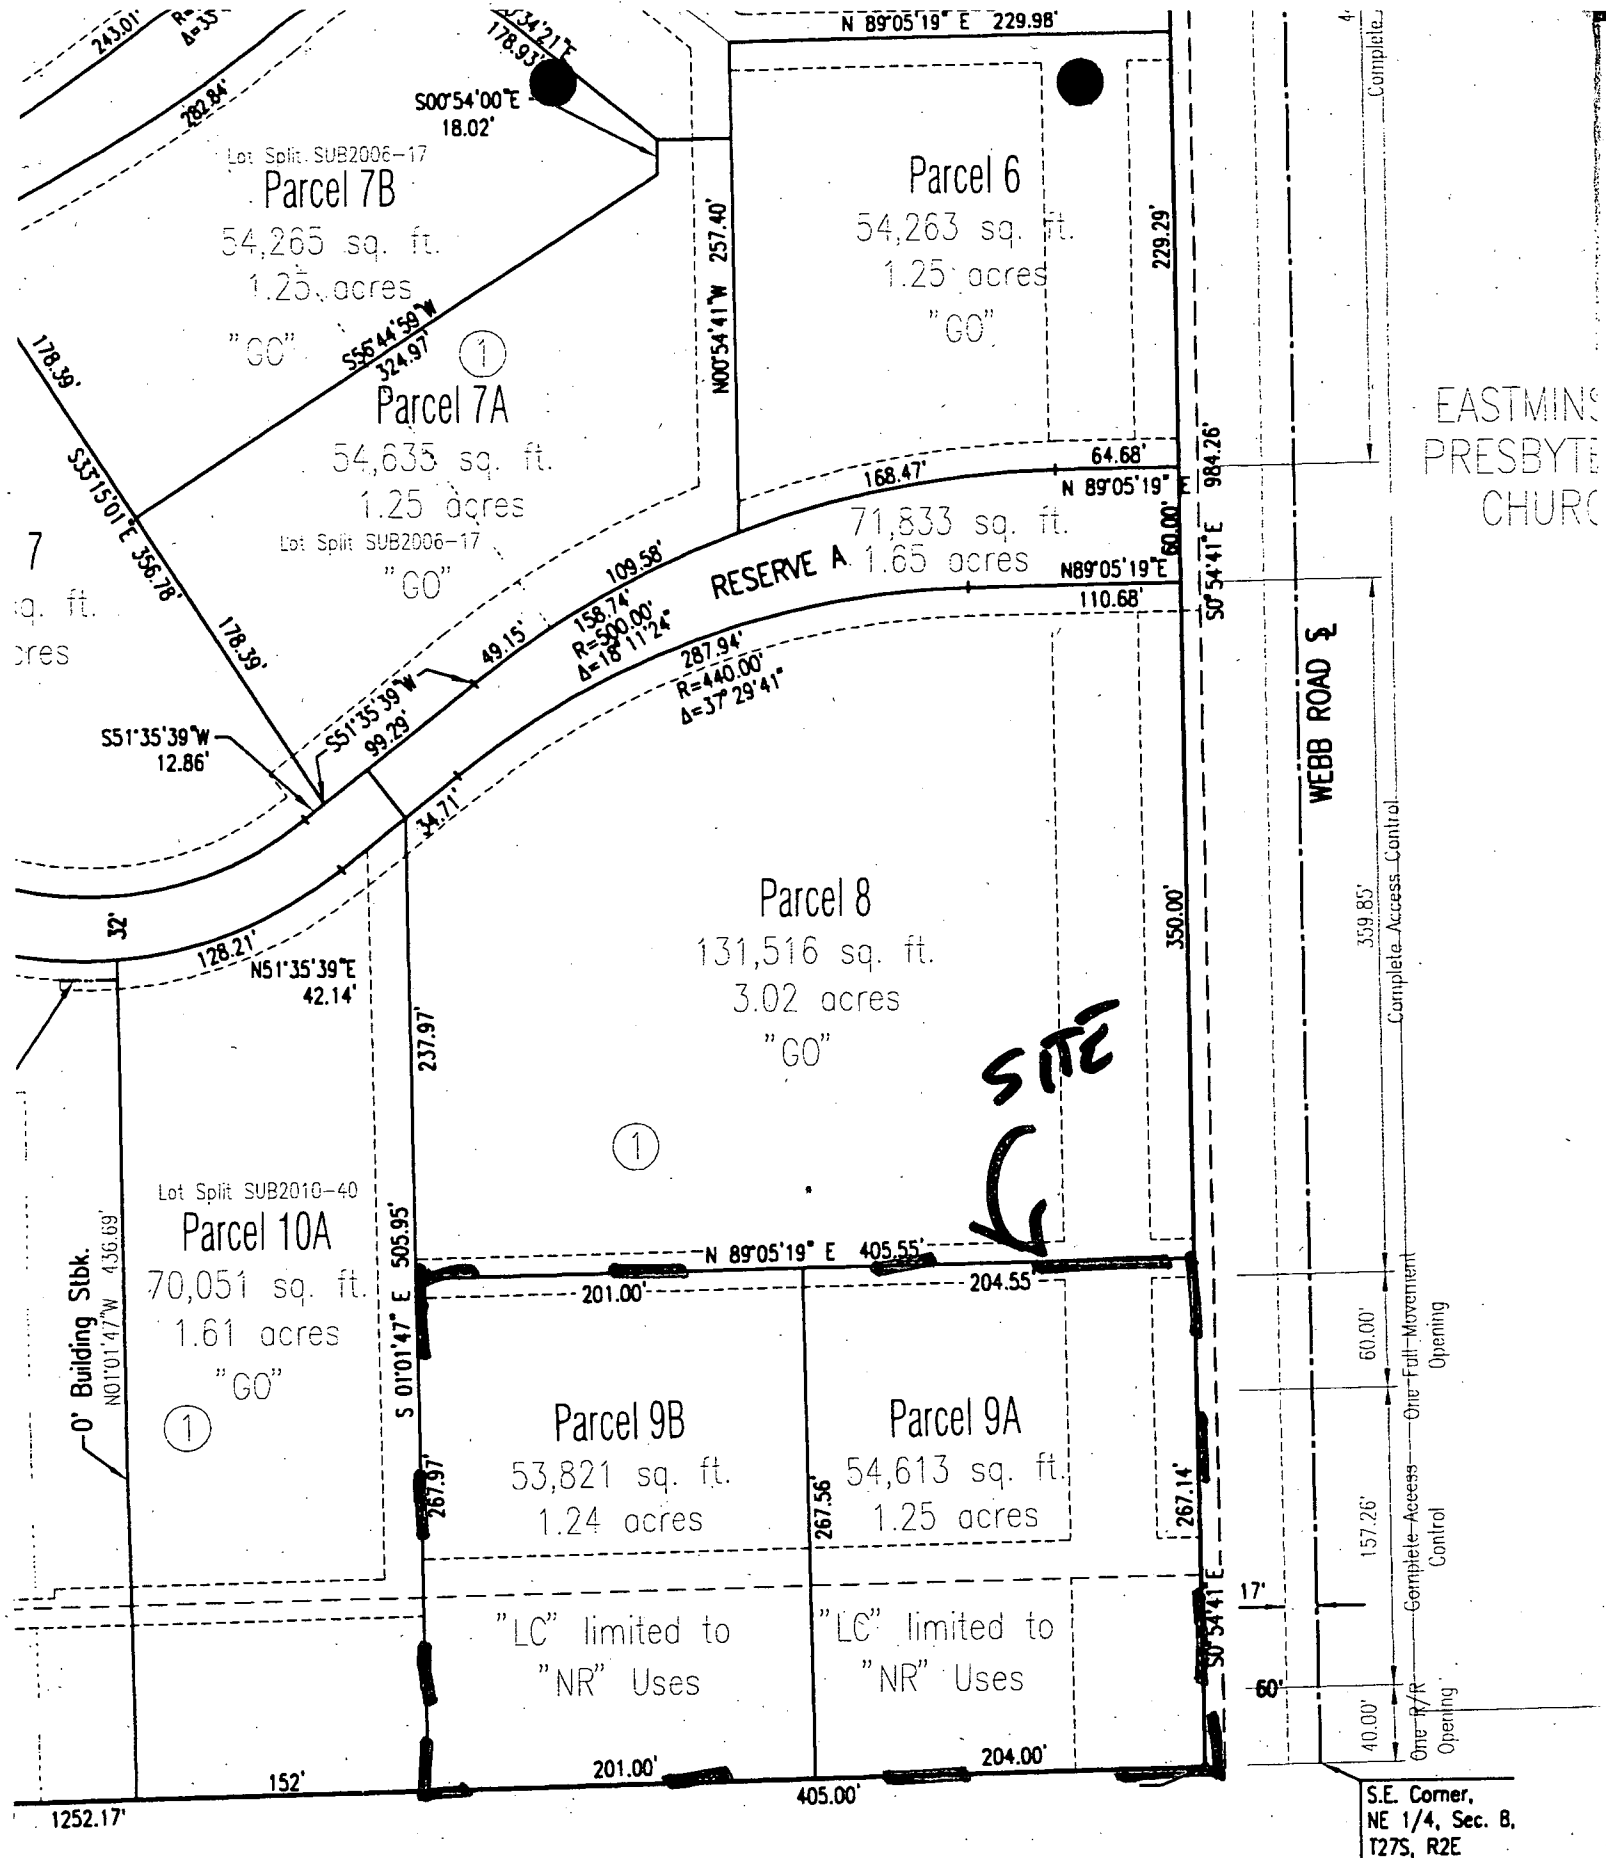

VAC2013-11