CRESTVIEW COUNTRY CLUB ESTATES

SOUTHCREST ADDITION

TO

SEDGWICK COUNTY, KANSAS

1982


NORTH

SCALE: 1"=60'

LEGEND

• 3/4" IRON OR 5/8" REBAR

REISS AND GOODNESS ENGINEERS
2160 W. 21st. ST. WICHITA, KANSAS 67203

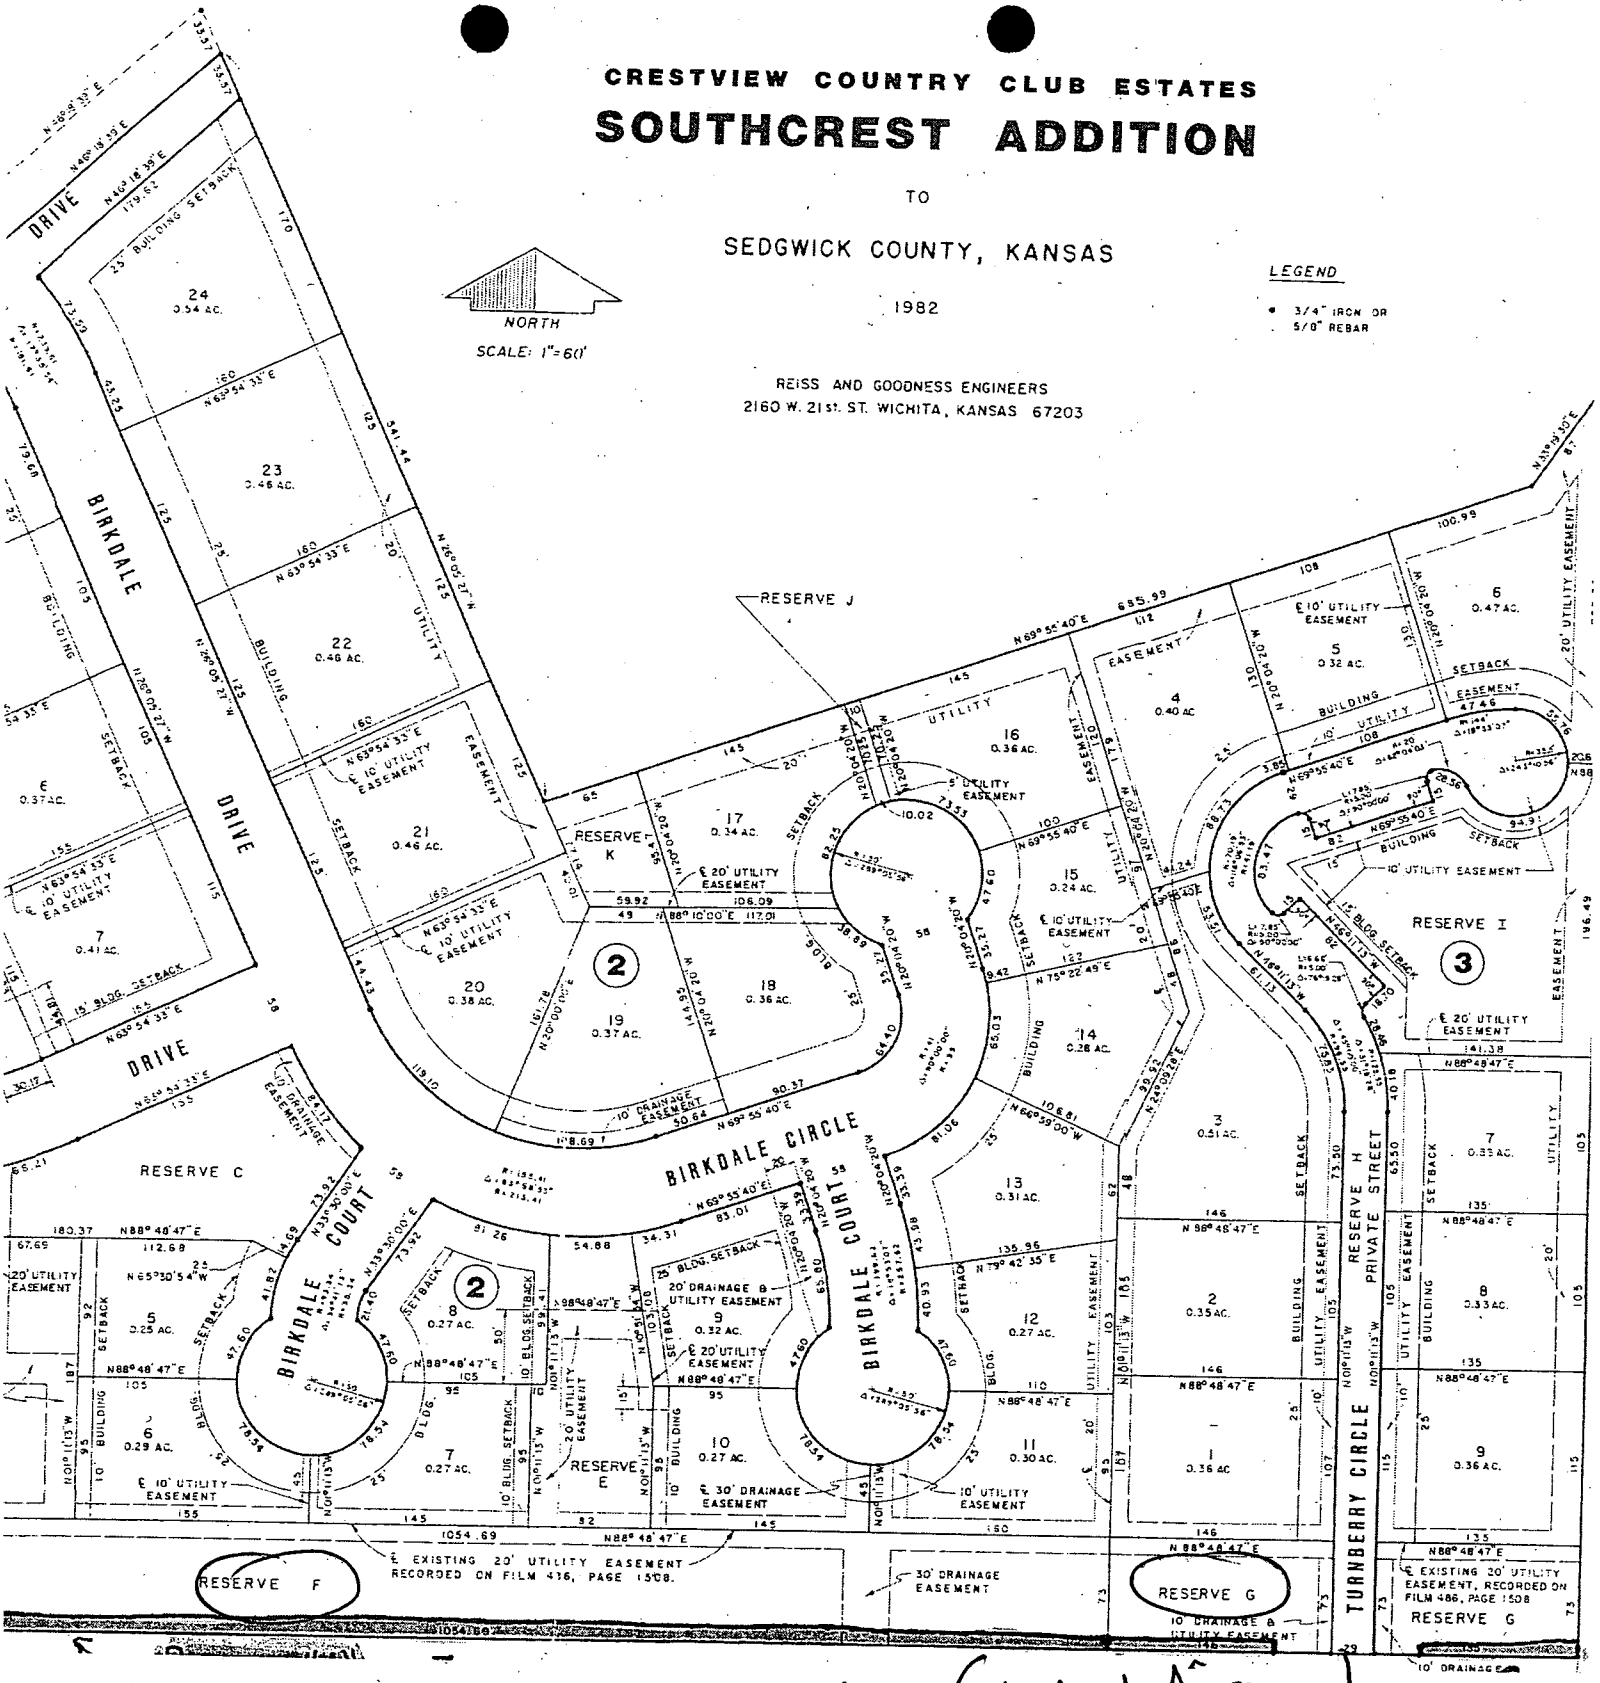

VAC2013-14 ← (Central Avenue) →