


SITE PLAN

VAC2013-26

23RD ST. N. (60' R/W)

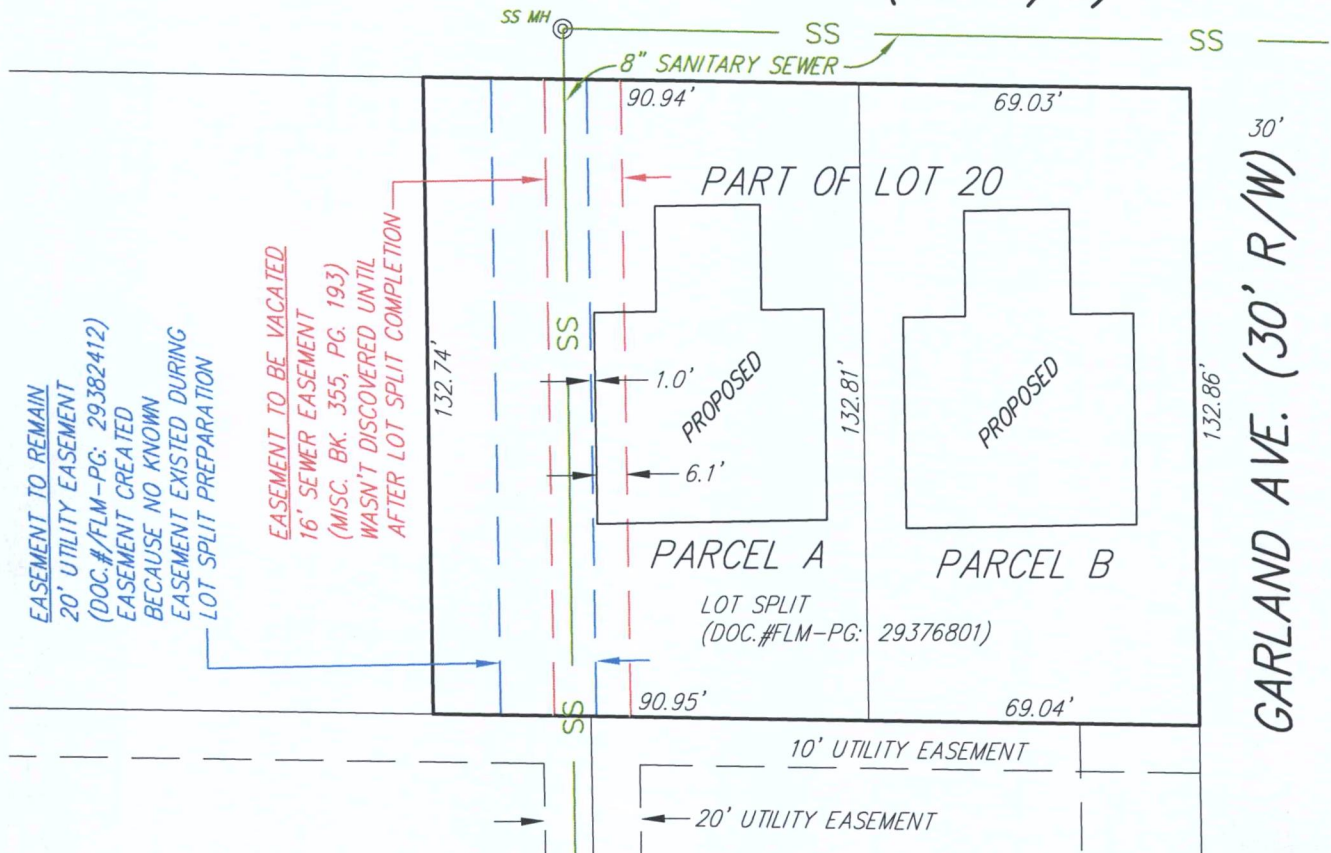

GARLAND AVE. (30' R/W)

