


VAC2013-35

N



1" = 50'
0 = iron

Minimum Red Elevation
171.0 City Datum

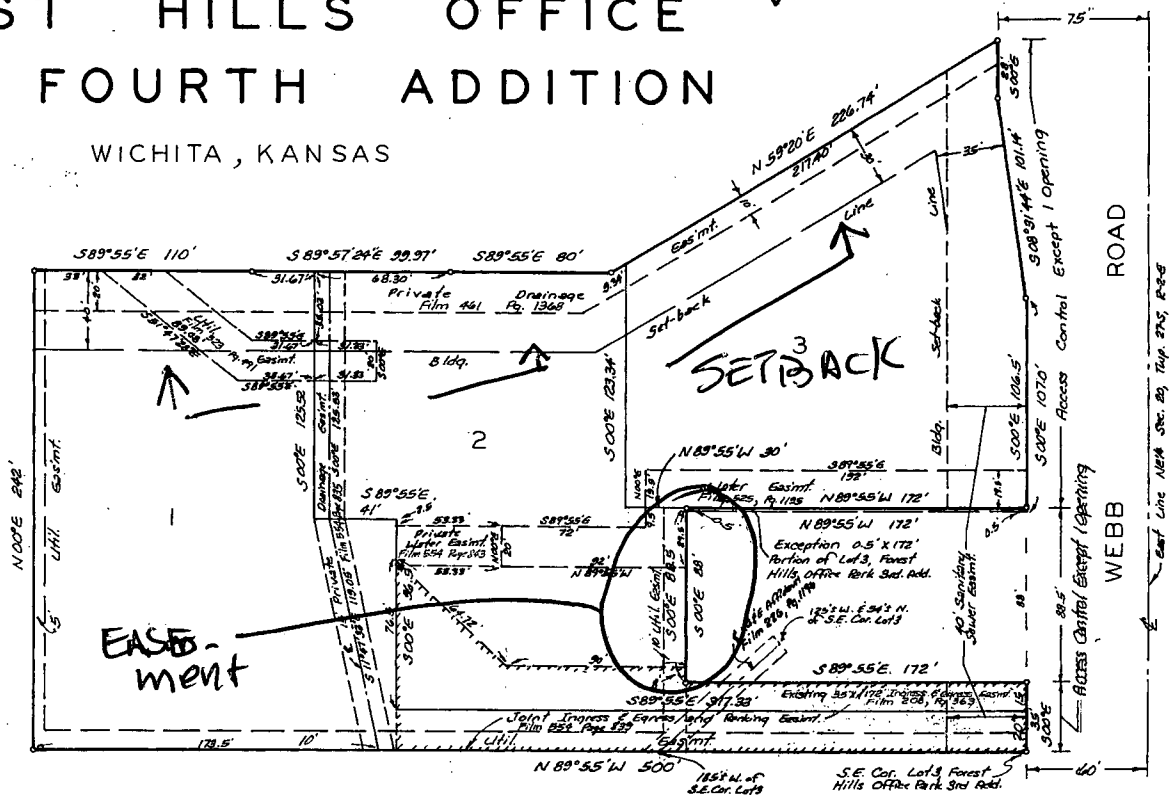

Baughman Company, P. A.

William L. Korber Surveyor
William L. Korber

This plat of "FOREST HILLS OFFICE PARK FOURTH ADDITION" Wichita, Kansas, has been submitted to and approved by the Wichita-Sedgwick County Metropolitan Area Planning Commission, Wichita, Kansas. Dated this 15 day of July, 1982. Wichita-Sedgwick County Metropolitan Area Planning Commission.

James L. Gardner II Chairman
Robert A. Lakin Secretary

This plat approved and all deductions shown hereon accepted by the Board of Commissioners of the City of Wichita, Kansas, this 16th day of Nov. 1932.

1902.

Albert J. Kirk Mayor

Donald E. Gistick City Clerk

This plat approved and all dedications shown hereon accepted by the Board of Commissioners, Sedgewick County, Kansas, this 1st day of October 1982.

 Chairman
Jack Scott
 Commissioner
Tom Scott


Donald E. Gragg
Dorothy K. White
County Clerk

Entered on transfer record this
1st day of DECEMBER 1982.



FOREST HILLS OFFICE PARK FOURTH ADDITION

WICHITA, KANSAS

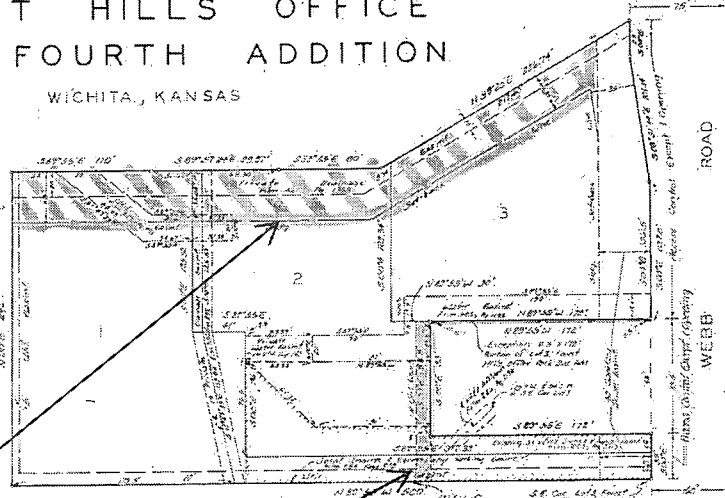

Vacation Case

Vacation Case

State of Kansas, ss. We, Beaughman Company, P.A., Surveyors in and for said county and state, do hereby certify that we have surveyed and plotted FOREST HILLS OFFICE PARK FOURTH ADDITION, Wichita, Kansas, and that the accompanying plat is a true and correct exhibit of the property surveyed, described as and being a replat of Lot 3, Forest Hills Office Park Fourth Addition, Wichita, Sedgewick 

Beaughman Company, P.A.


Know all men by these presents that we, the undersigned, have caused the land described in the surveys certificate to be replatted into lots to be known as FOREST HILLS OFFICE PARK FOURTH ADDITION, Wichita, Kansas. The utility easements are hereby granted as indicated for the construction and maintenance of all public utilities. All easements right of access to or from Webb Rd. over and across the east line of Lots 1, 2 and 3 are hereby granted to the City of Wichita, provided however that Lots 1 and 2 shall have access to Webb Rd. at 1 point and that Lot 3 shall have access to Webb Rd. at 1 point, all as shall be determined by the City Engineer of the City of Wichita, Kansas. No structure shall be constructed below a minimum pad elevation of 1760 City Datum.





















