



UAC2014-01

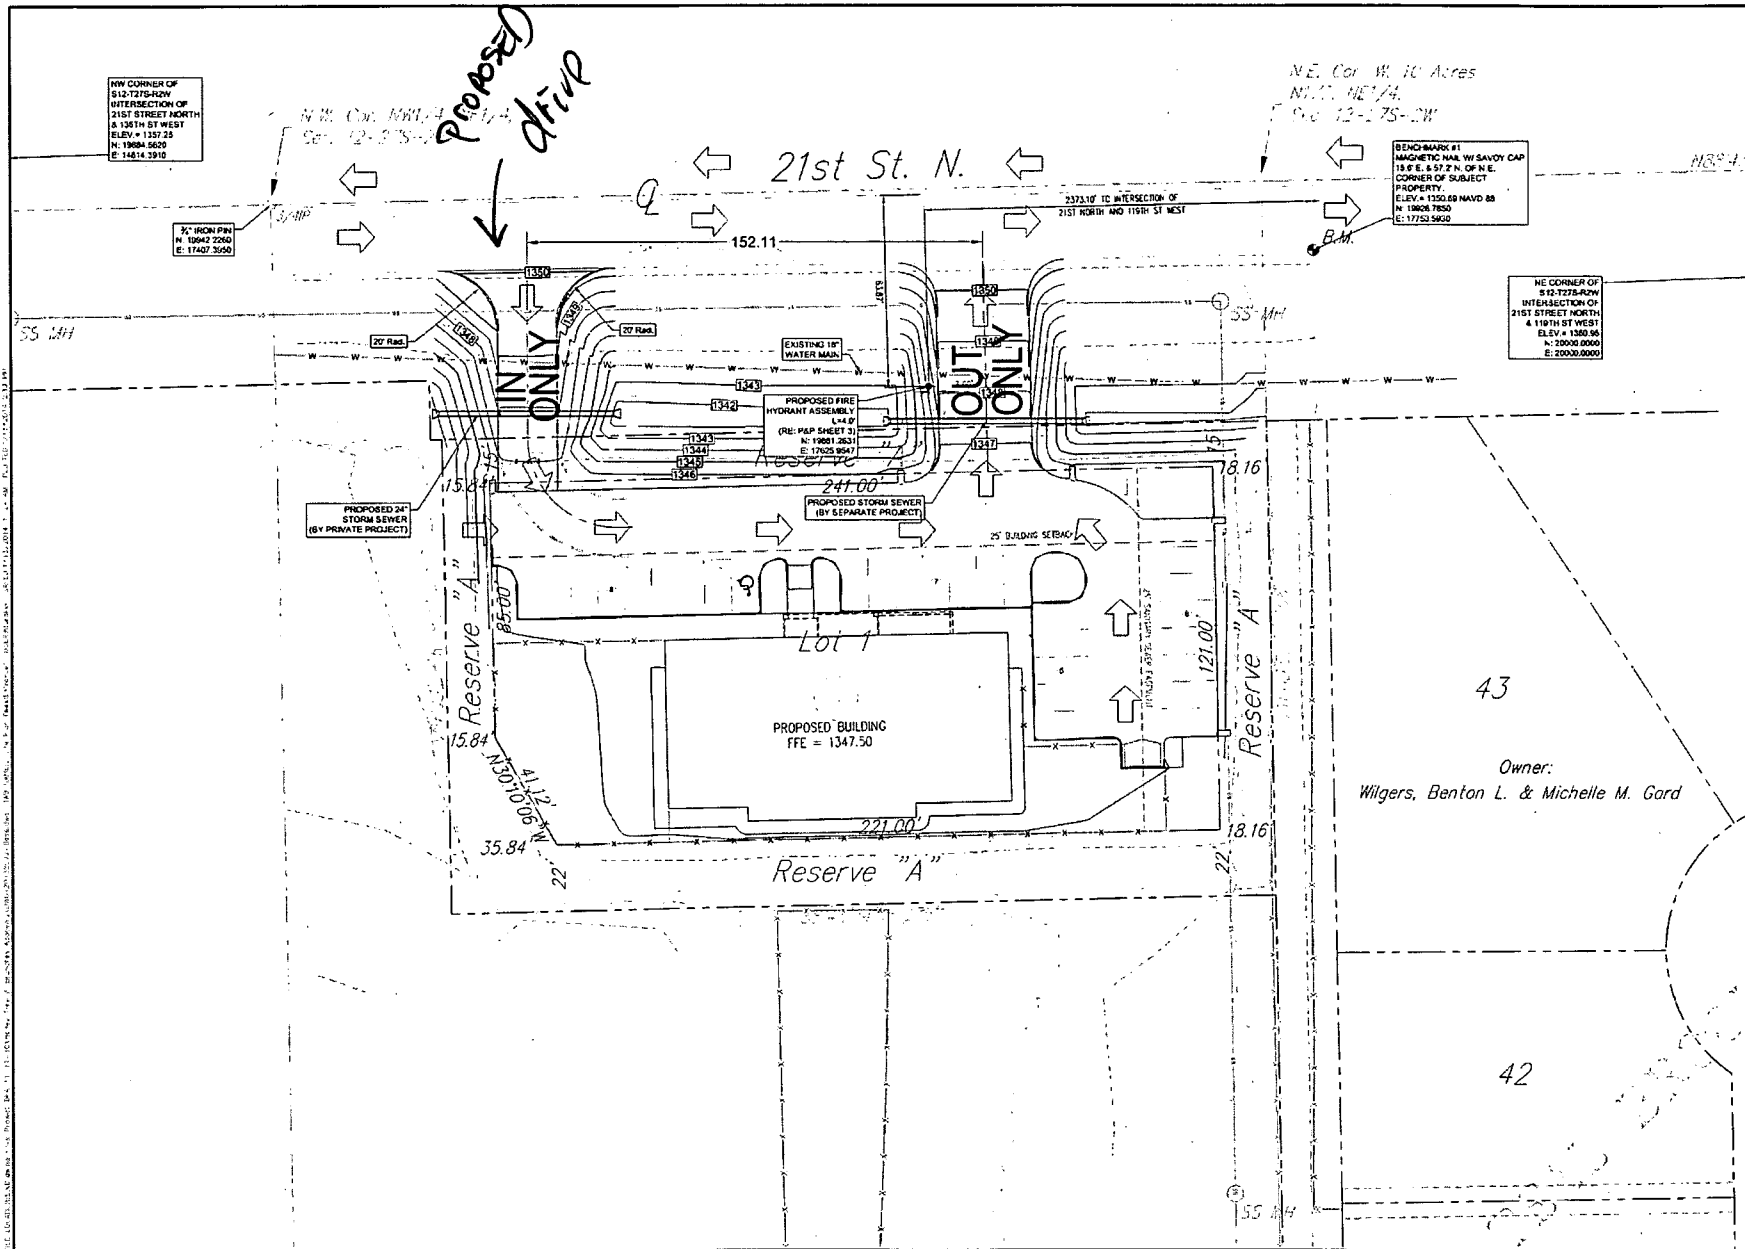

REV.	DESCRIPTION	DATE

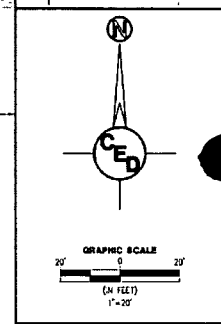

HONEY TREE & BRANCHES ACADEMY
 12807 WEST 21ST STREET NORTH
 GREIFENSTEIN SQUARE
 AN ADDITION TO
 WICHITA, SEDGWICK COUNTY, KANSAS

CERTIFIED ENGINEERING DESIGN, P.A.
 CIVIL ENGINEERING
CED
 1935 WEST MAPLE
 WICHITA, KANSAS 67213
 PH.(316)262-8808 FAX.(316)262-1669



PROJECT NO.: 20132082
 ISSUE DATE: 08/15/2013
 CONTACT: H. FORAKER L. MILLS
 CHECKED BY:
SITE PLAN FOR WEST ENTRANCE
2