

VAC2014-25

EXHIBIT

PART OF LOT 1, BLOCK A, RIDGE PORT NORTH 6TH ADDITION, WICHITA, SEDGWICK COUNTY, KANSAS




INDICATES AREA OF
LEGAL DESCRIPTION



N. LINE, NW1/4, SEC. 34,
TWP. 26-S, R-1-W

37TH STREET NORTH

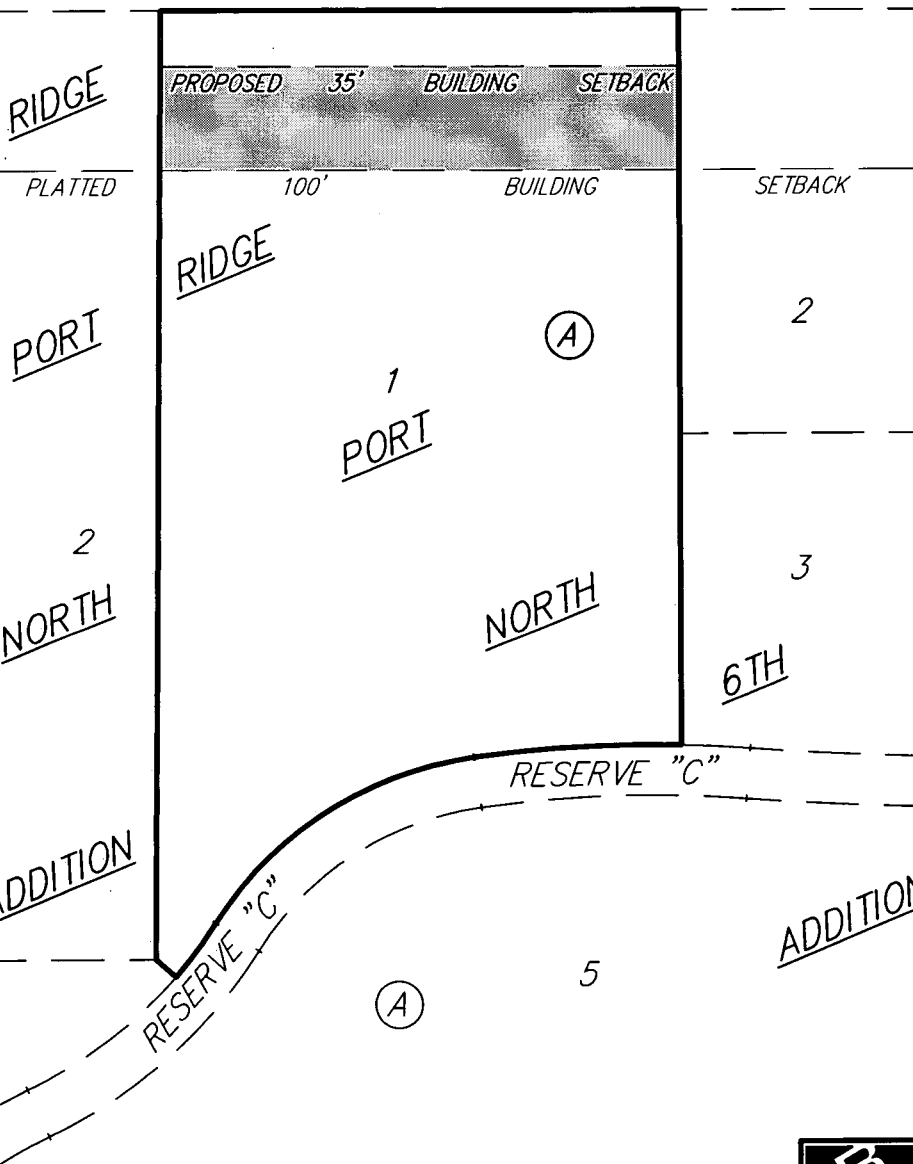

14 JULY 2014

B Baughman Company, P.A.
315 Ellis St. Wichita, KS 67211 P 316-262-7271 F 316-262-0149
Baughman ENGINEERING | SURVEYING | PLANNING | LANDSCAPE ARCHITECTURE