
VAC2014-25

EXHIBIT

PART OF LOT 1, BLOCK A, RIDGE PORT NORTH 6TH ADDITION, WICHITA, SEDGWICK COUNTY, KANSAS

0 120 240

INDICATES AREA OF LEGAL DESCRIPTION

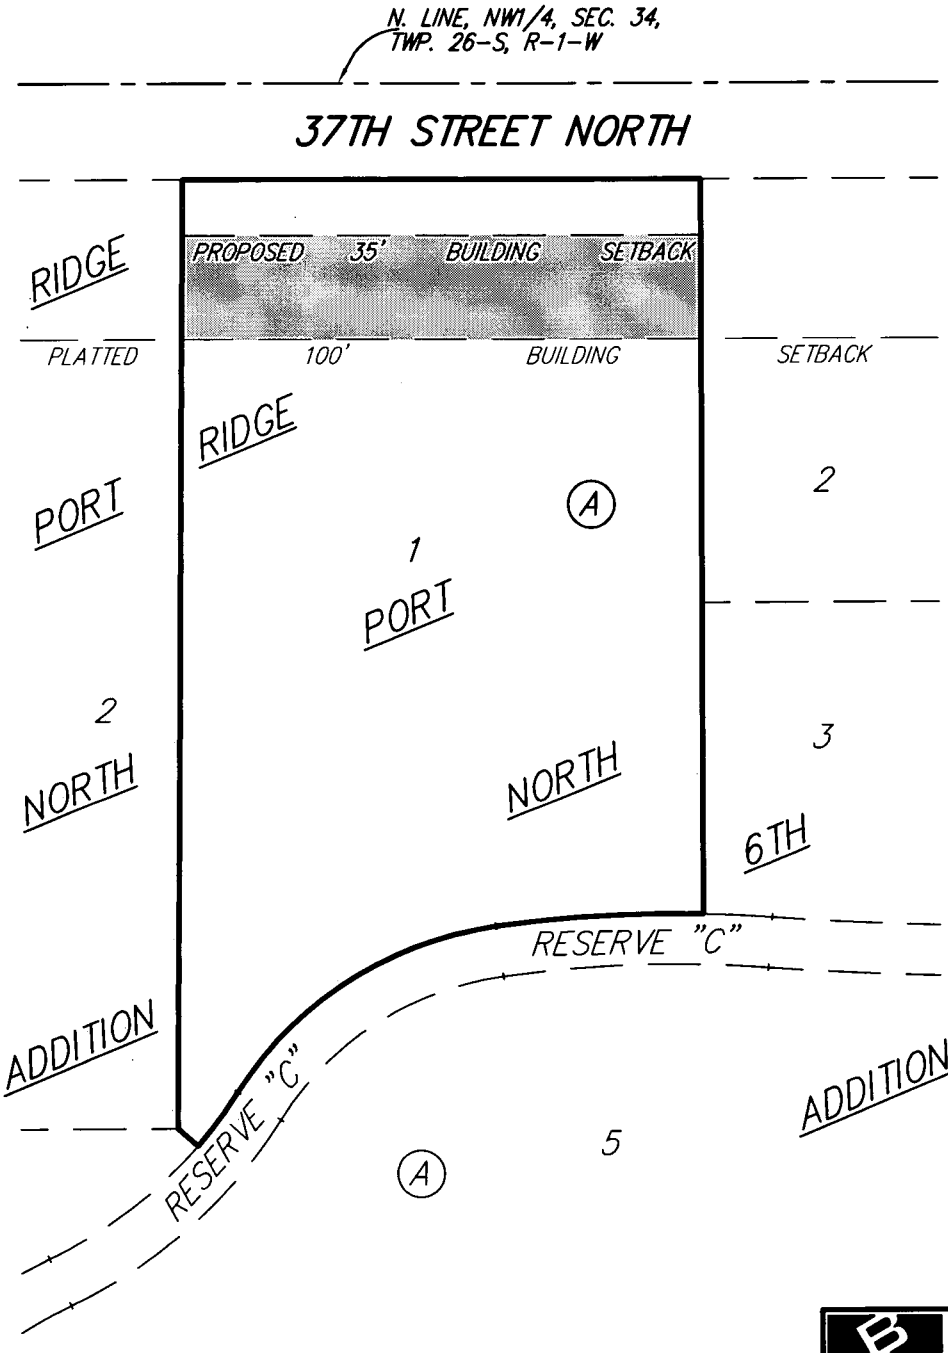

14 JULY 2014

Baughman Company, P.A.
315 Ellis St. Wichita, KS 67211 P 316-262-7271 F 316-262-0149
Baughman ENGINEERING | SURVEYING | PLANNING | LANDSCAPE ARCHITECTURE

F:\BAUGHMAN LIBRARY\SURVEYING INFO.\EXHIBITS\EXHIBITS\RIDGE PORT NORTH 6TH SB VAC.DWG-MGC