
VAC2014-33

Building Locate
300 Cedar Crest
Wichita, Kansas

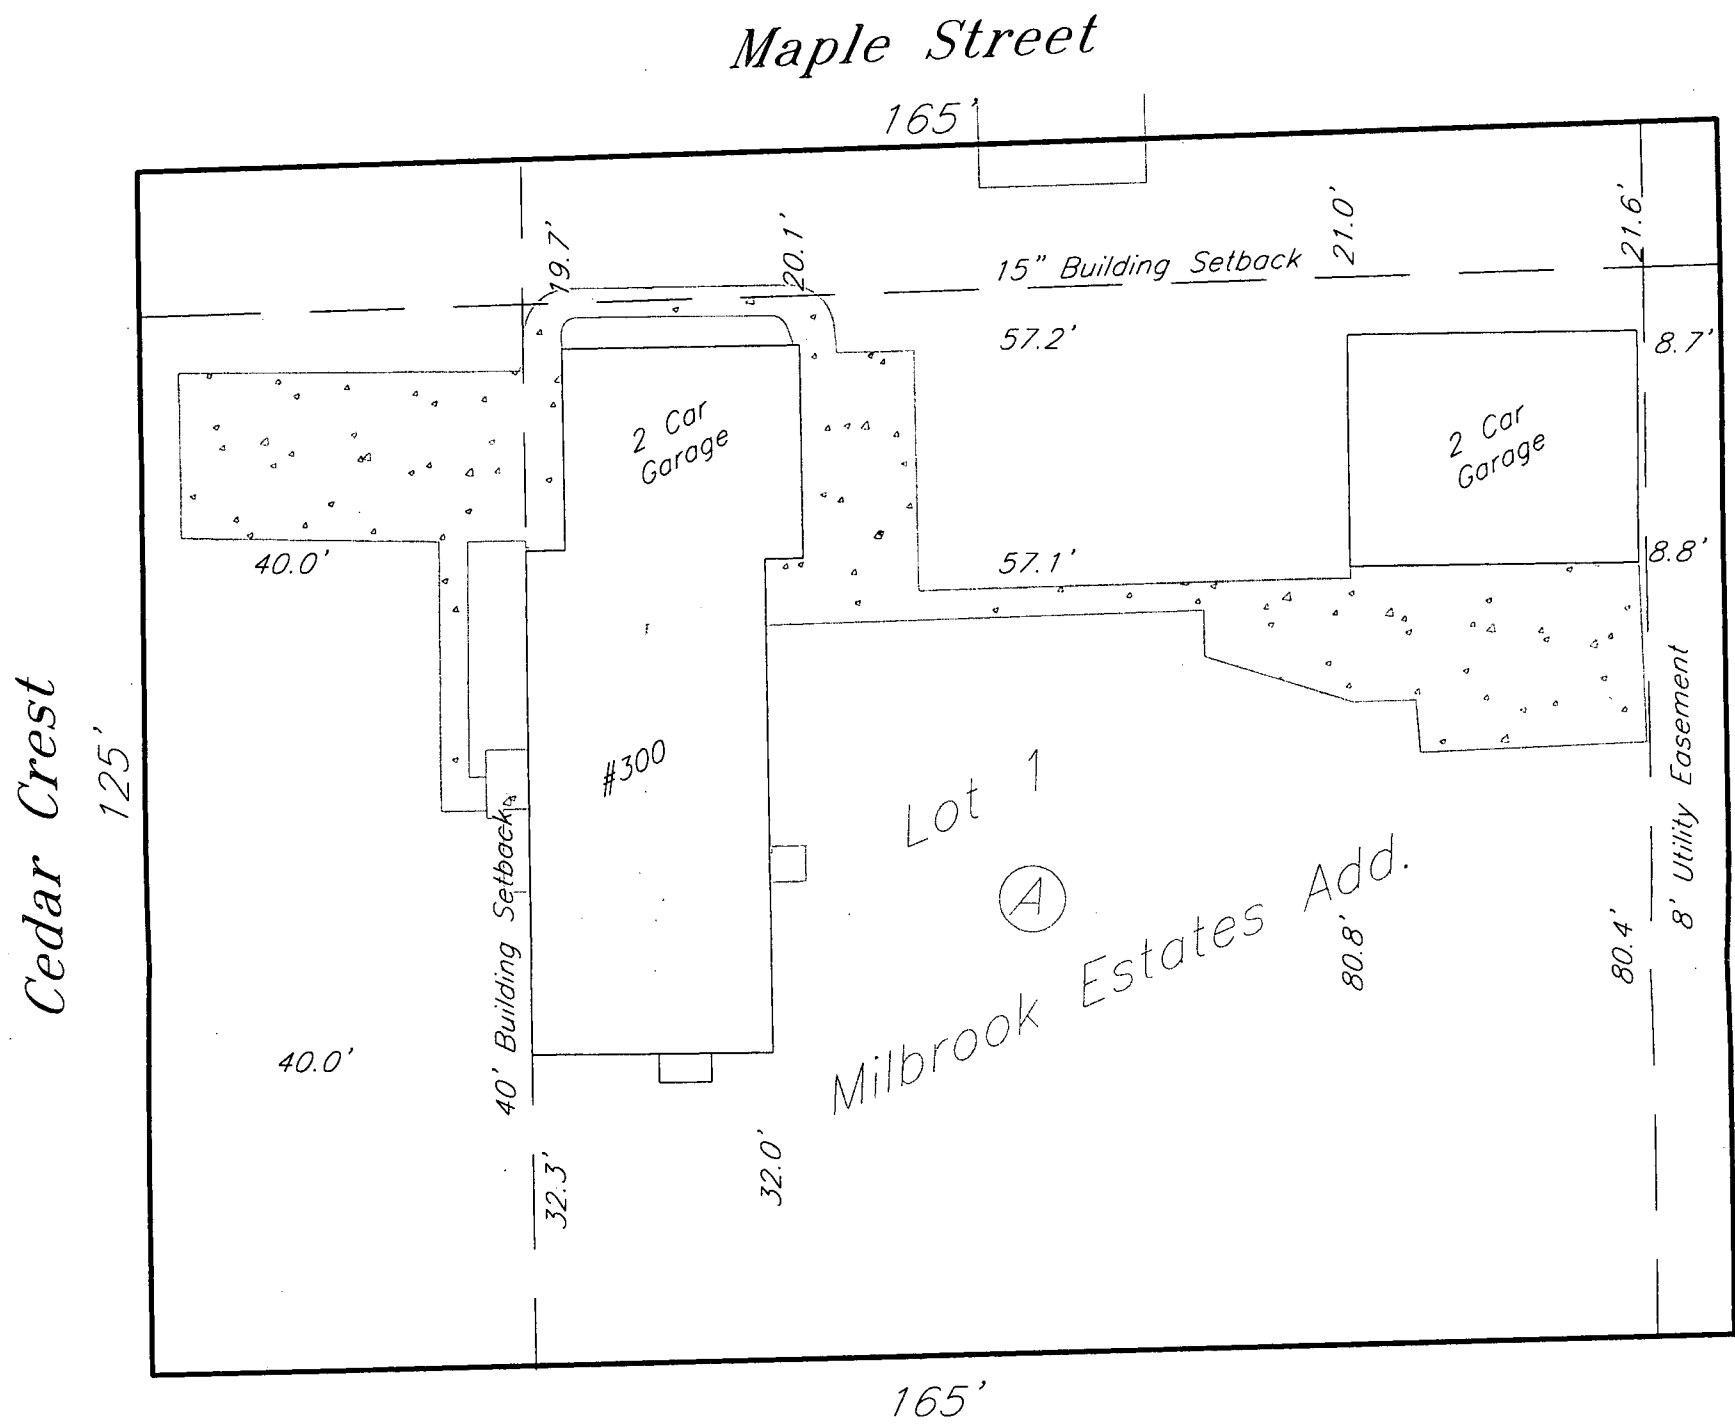

Legal Description
Lot 1, Block A, Millbrook Estates Addition. Wichita, Sedgwick County, Kansas.

KEMILLER ENGINEERING PA