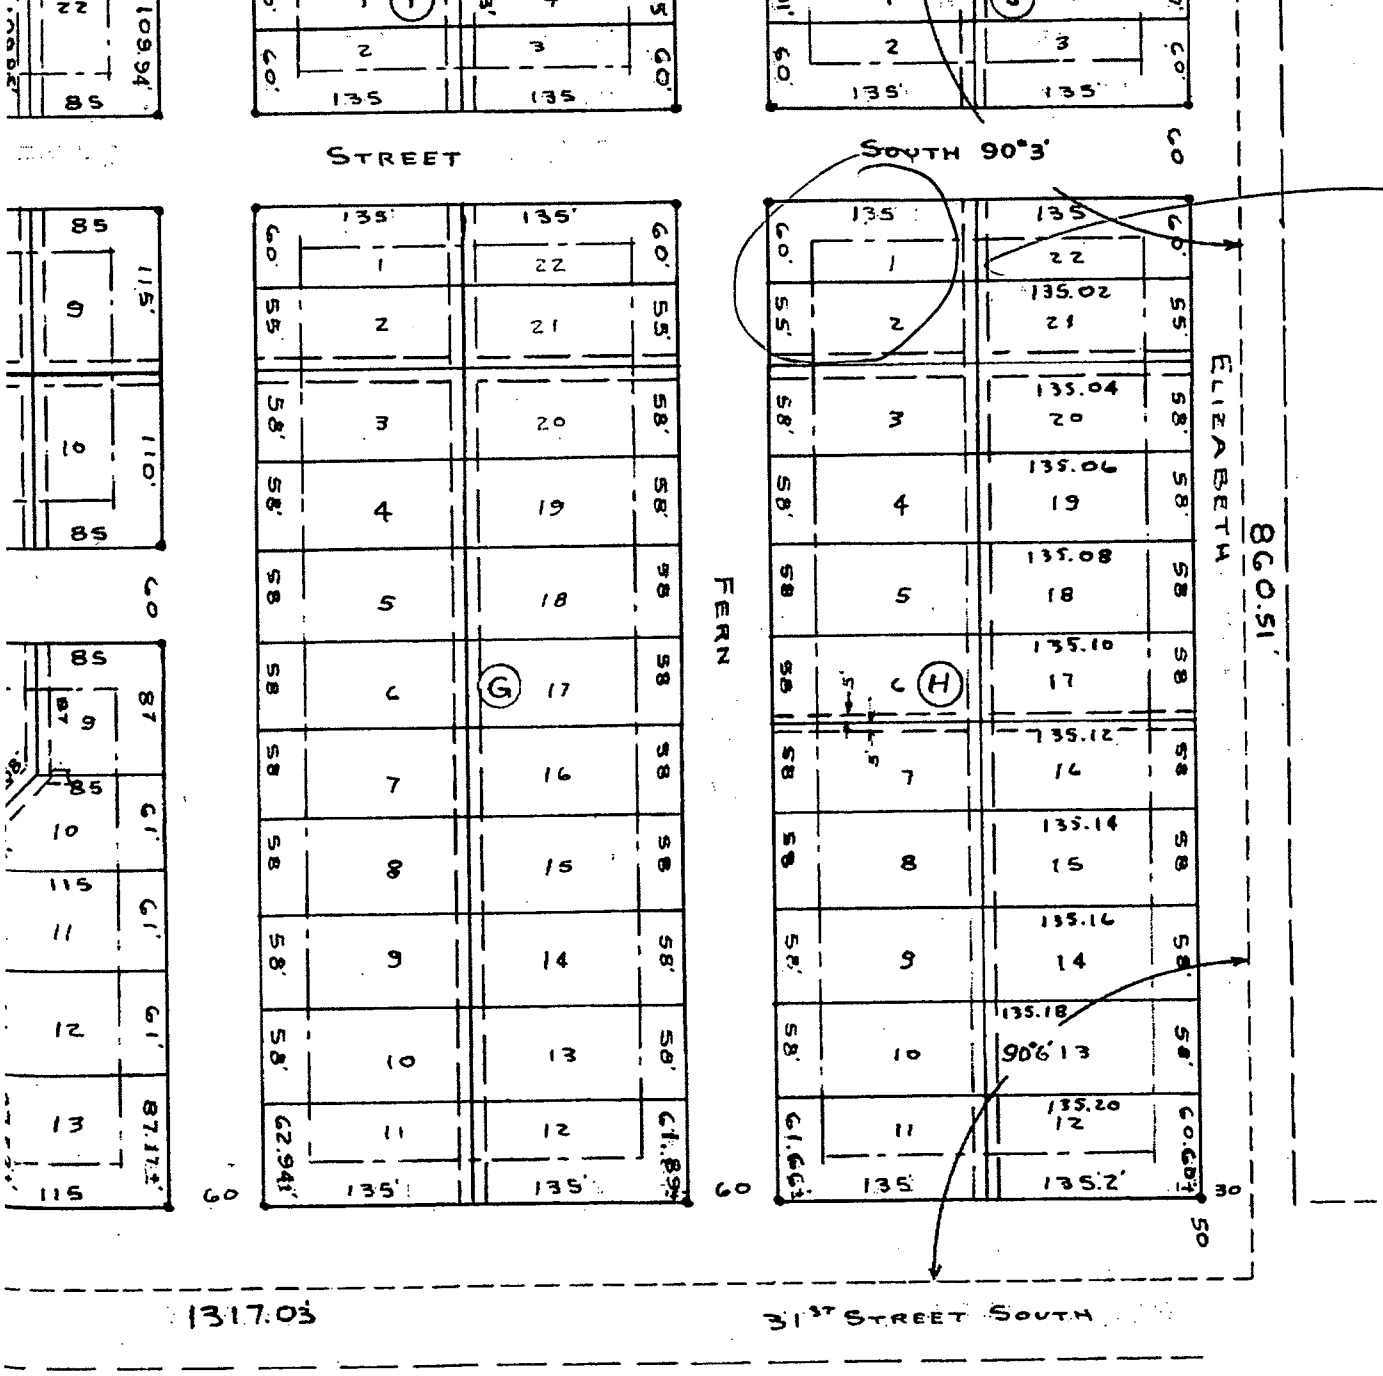

VACATION M 424 P 417

ORDER OF VACATION Book M357- 15
Approval of Loc. by Arch. Con. Com. M380 P.