92-5 O-N

EMERSON ADDITION

WICHITA, SEDGWICK COUNTY, KANSAS

This plat approved and all dedications shown hereon accepted by the Board of County Commissioners of Sedgwick County, Kansas, this 12th day of May, 1980.

Everett Patrick, Chairman

Tom Scott, Commissioner

Donald E. Dragg, Commissioner

ATTEST:

Dorothy K. White, County Clerk

Entered on transfer record this 12 day of May, 19 80.

Dorothy K. White, County Clerk


State of Kansas, County of Sedgwick, ss.

This is to certify that this instrument was filed for record in the Register of Deeds Office, at 2:00 o'clock P m., on the 12TH day of MAY, 1980.

Bette F. McCart, Register of Deeds

Pat Kettler, Deputy

#488418

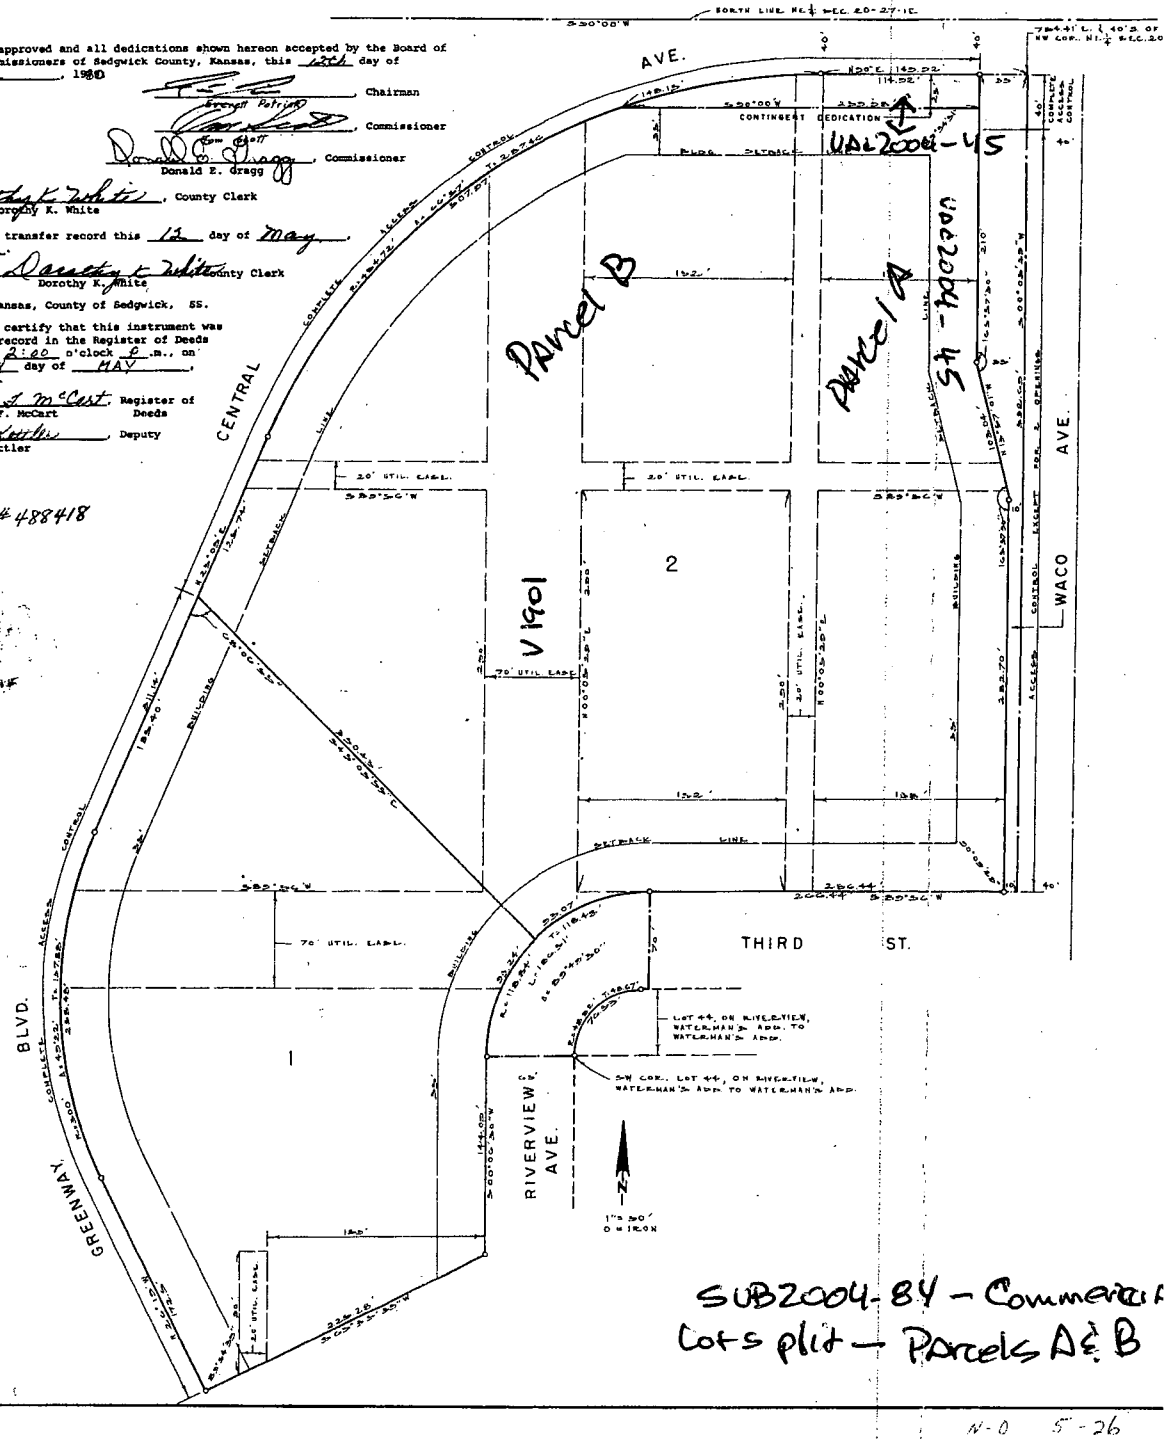

SUB2004-84 - Commercial
Lots plit - Parcels A & B


20.00

N-O 5-26

VAC2015-08

This digital plat record accurately reproduces in all details the original plat filed with the Sedgwick County Register of Deeds. Digitized under the supervision of Register of Deeds Bill Meek by Sedgwick County Geographic Information Systems.

Bill Meek, Register of Deeds
Digitized facsimile of original signature

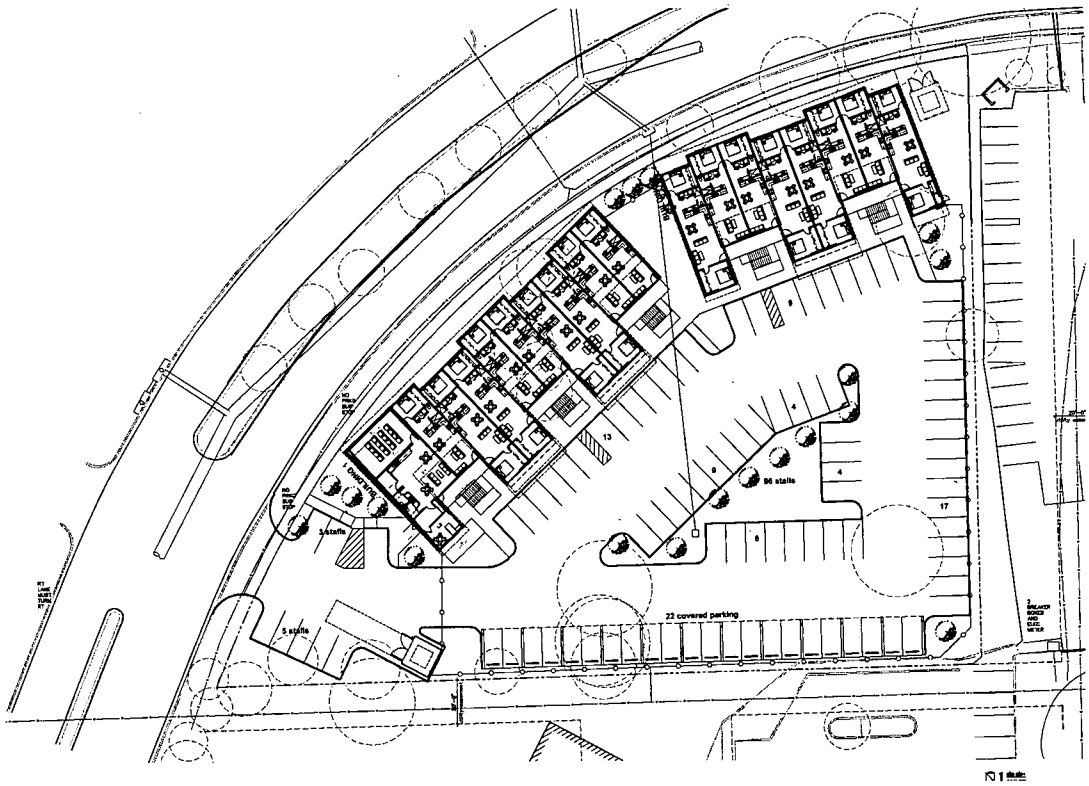

JDC 2015-08

3TEN STUDIO

APARTMENT COMPLEX

SA1.1