



WAC2015-10

# UTILITY MAP

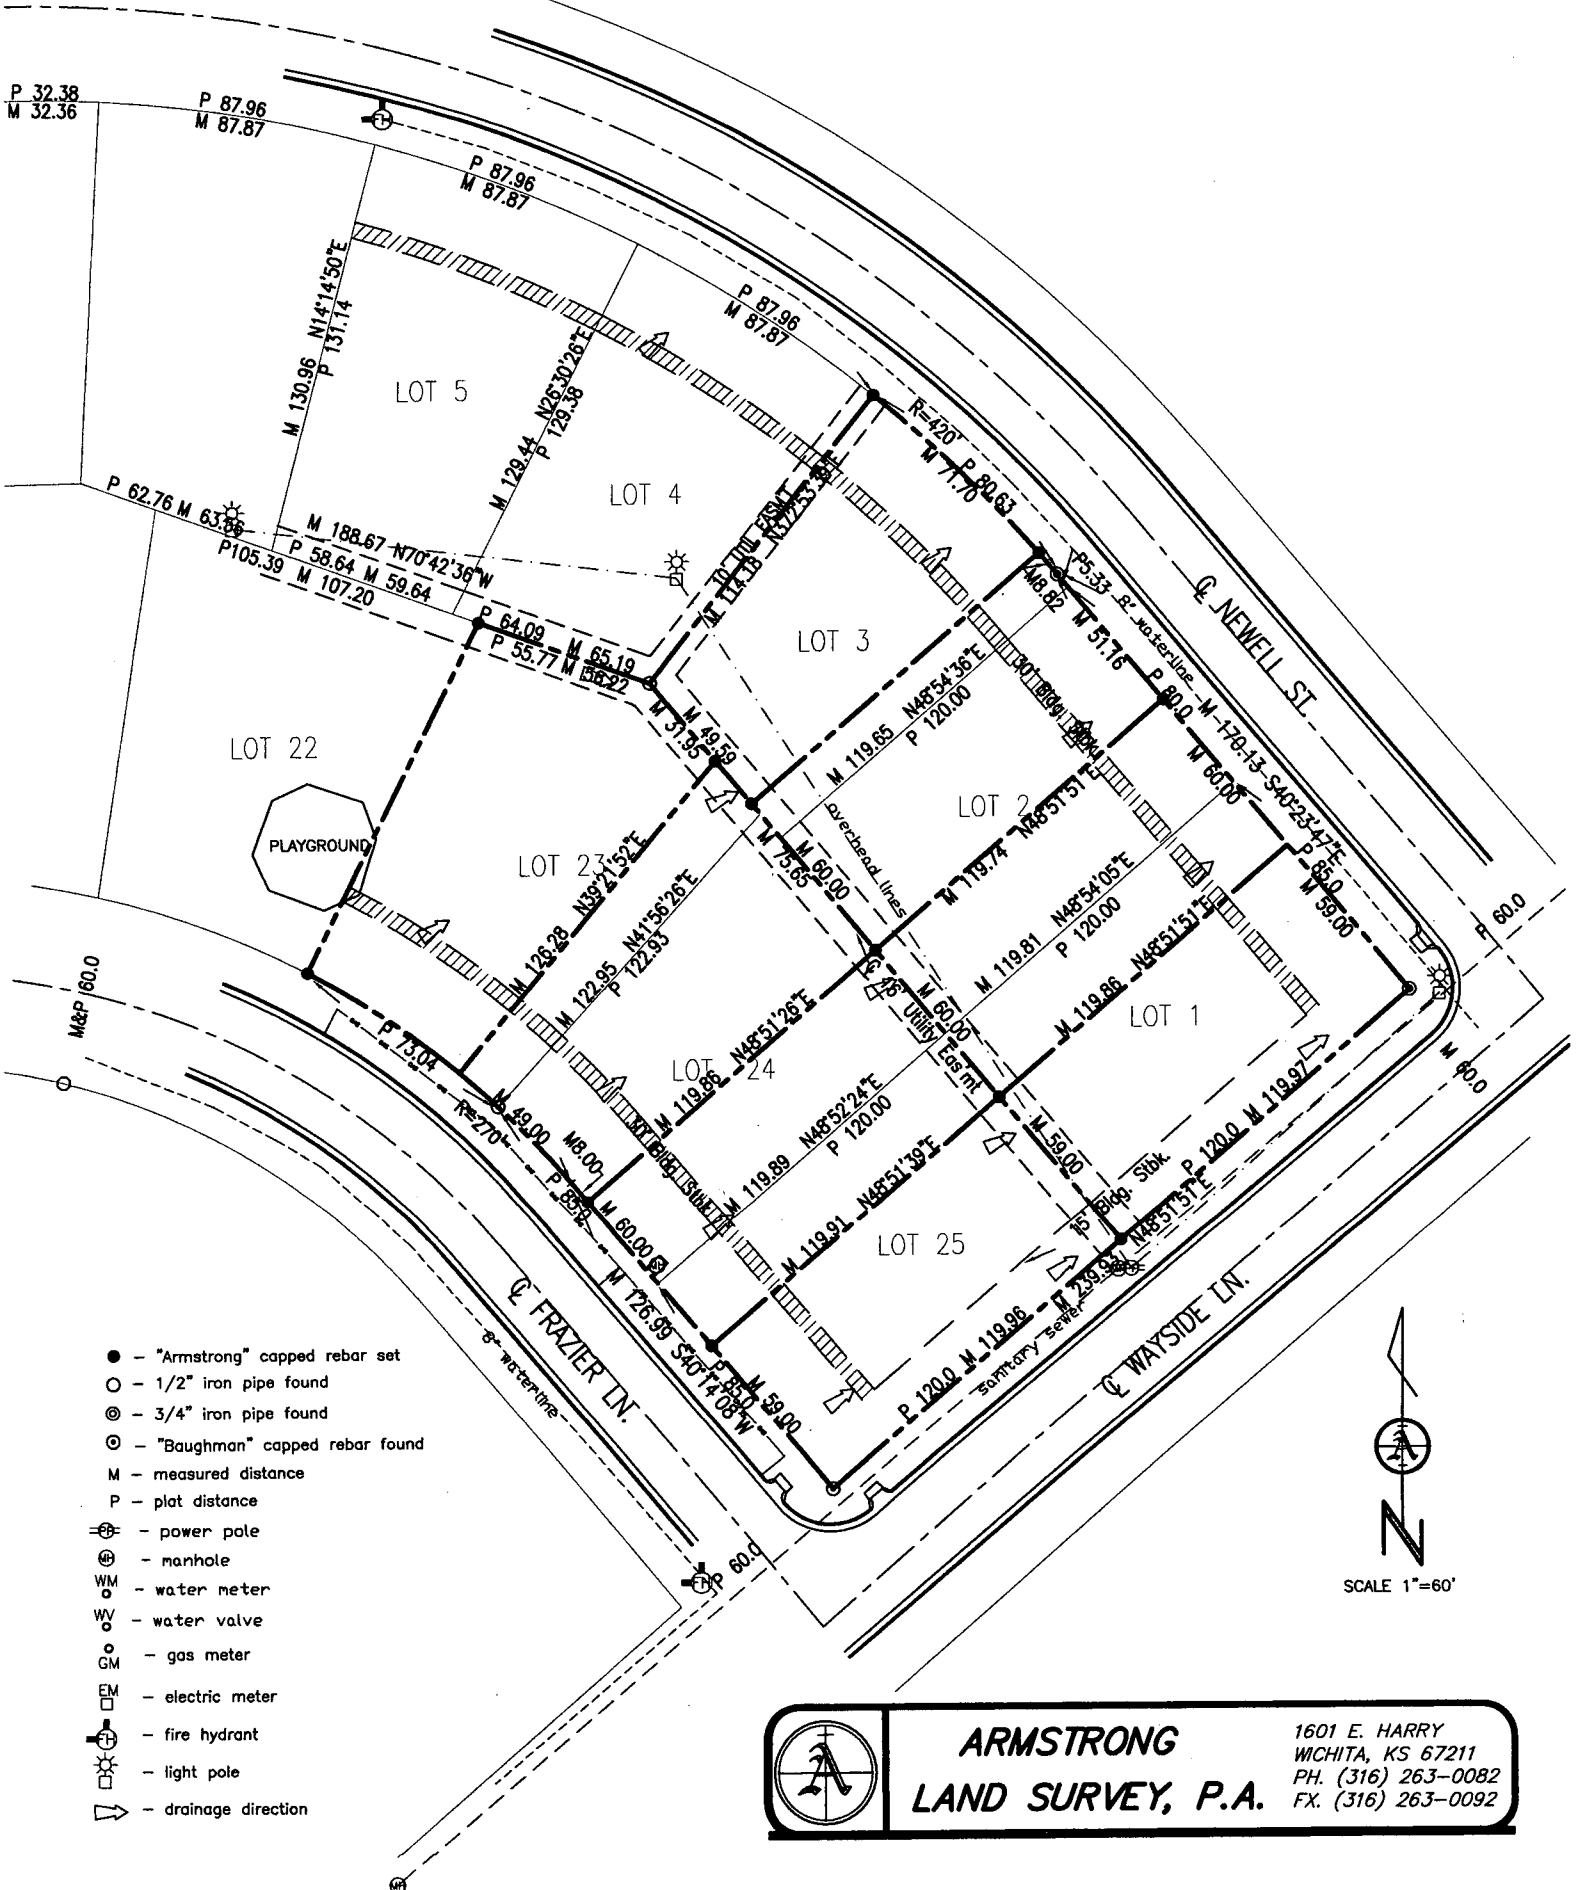

- - "Armstrong" capped rebar set
- - 1/2" iron pipe found
- ⊙ - 3/4" iron pipe found
- ⊙ - "Baughman" capped rebar found
- M - measured distance
- P - plat distance
- ⊕ - power pole
- ⊕ - manhole
- WM - water meter
- WV - water valve
- GM - gas meter
- EM - electric meter
- ⊕ - fire hydrant
- ☀ - light pole
- ↘ - drainage direction

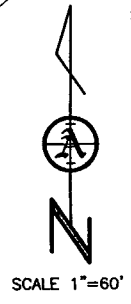

**ARMSTRONG**  
**LAND SURVEY, P.A.**

1601 E. HARRY  
 WICHITA, KS 67211  
 PH. (316) 263-0082  
 FX. (316) 263-0092