
VAC2015-10

UTILITY MAP

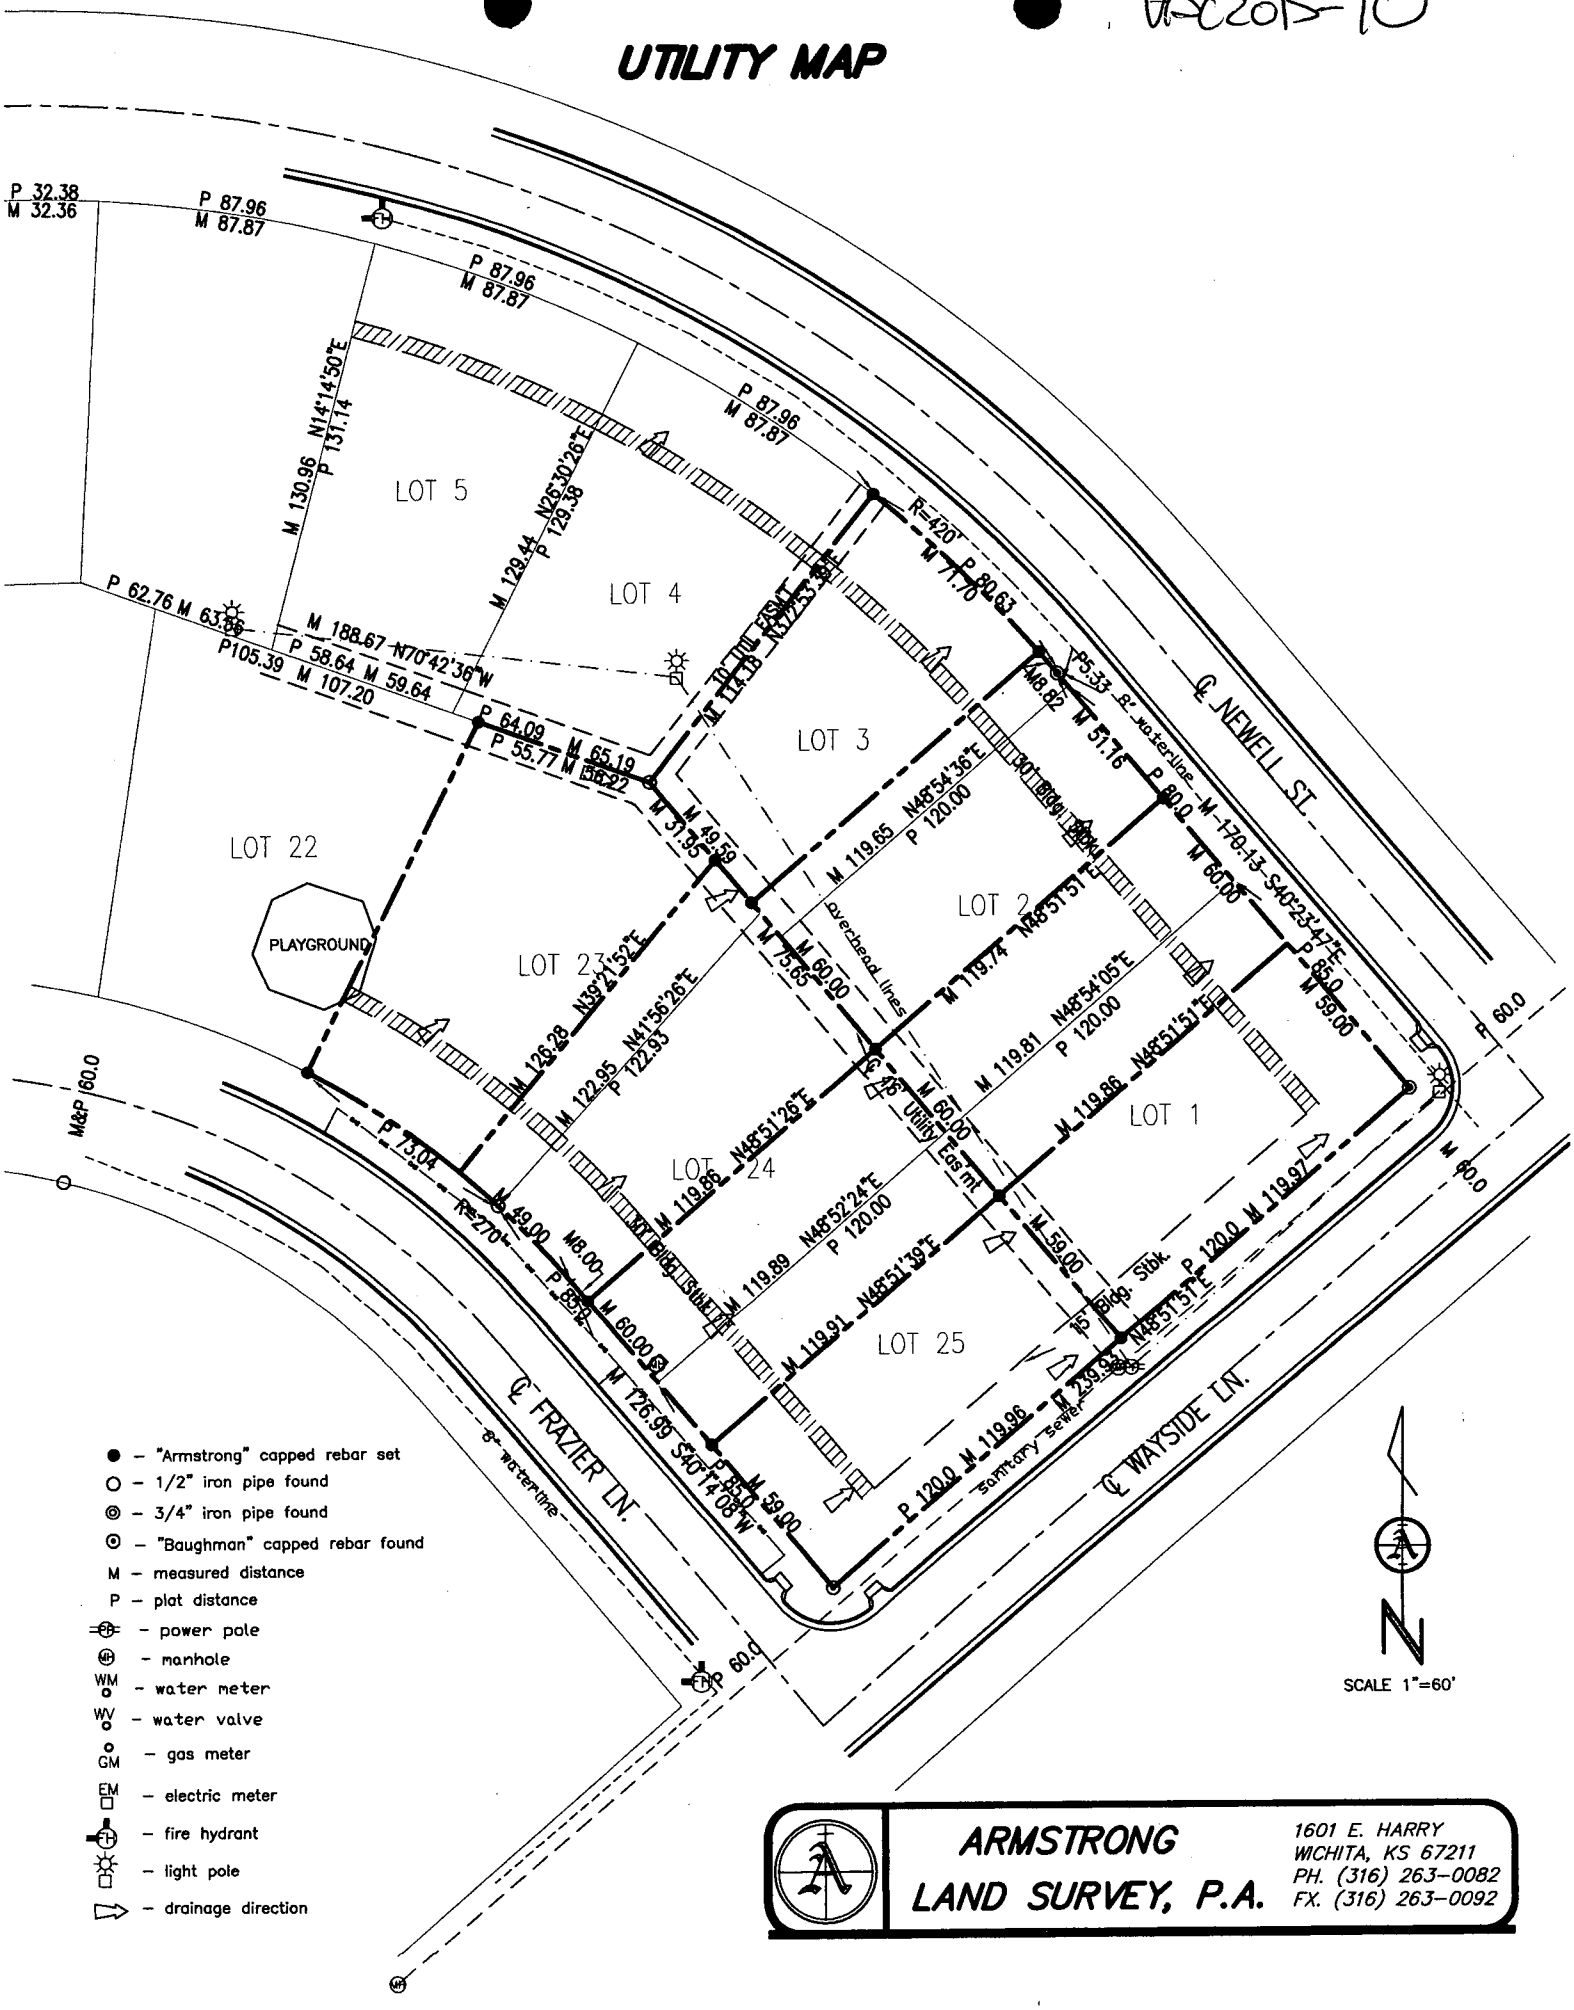

- ● – "Armstrong" capped rebar set
- ○ – 1/2" iron pipe found
- ◎ – 3/4" iron pipe found
- ⊙ – "Baughman" capped rebar found
- M – measured distance
- P – plat distance
- PP – power pole
- MH – manhole
- WM – water meter
- WV – water valve
- GM – gas meter
- EM – electric meter
- FH – fire hydrant
- LP – light pole
- ⇨ – drainage direction

SCALE 1"=60'

ARMSTRONG LAND SURVEY, P.A.
1601 E. HARRY
WICHITA, KS 67211
PH. (316) 263-0082
FX. (316) 263-0092