


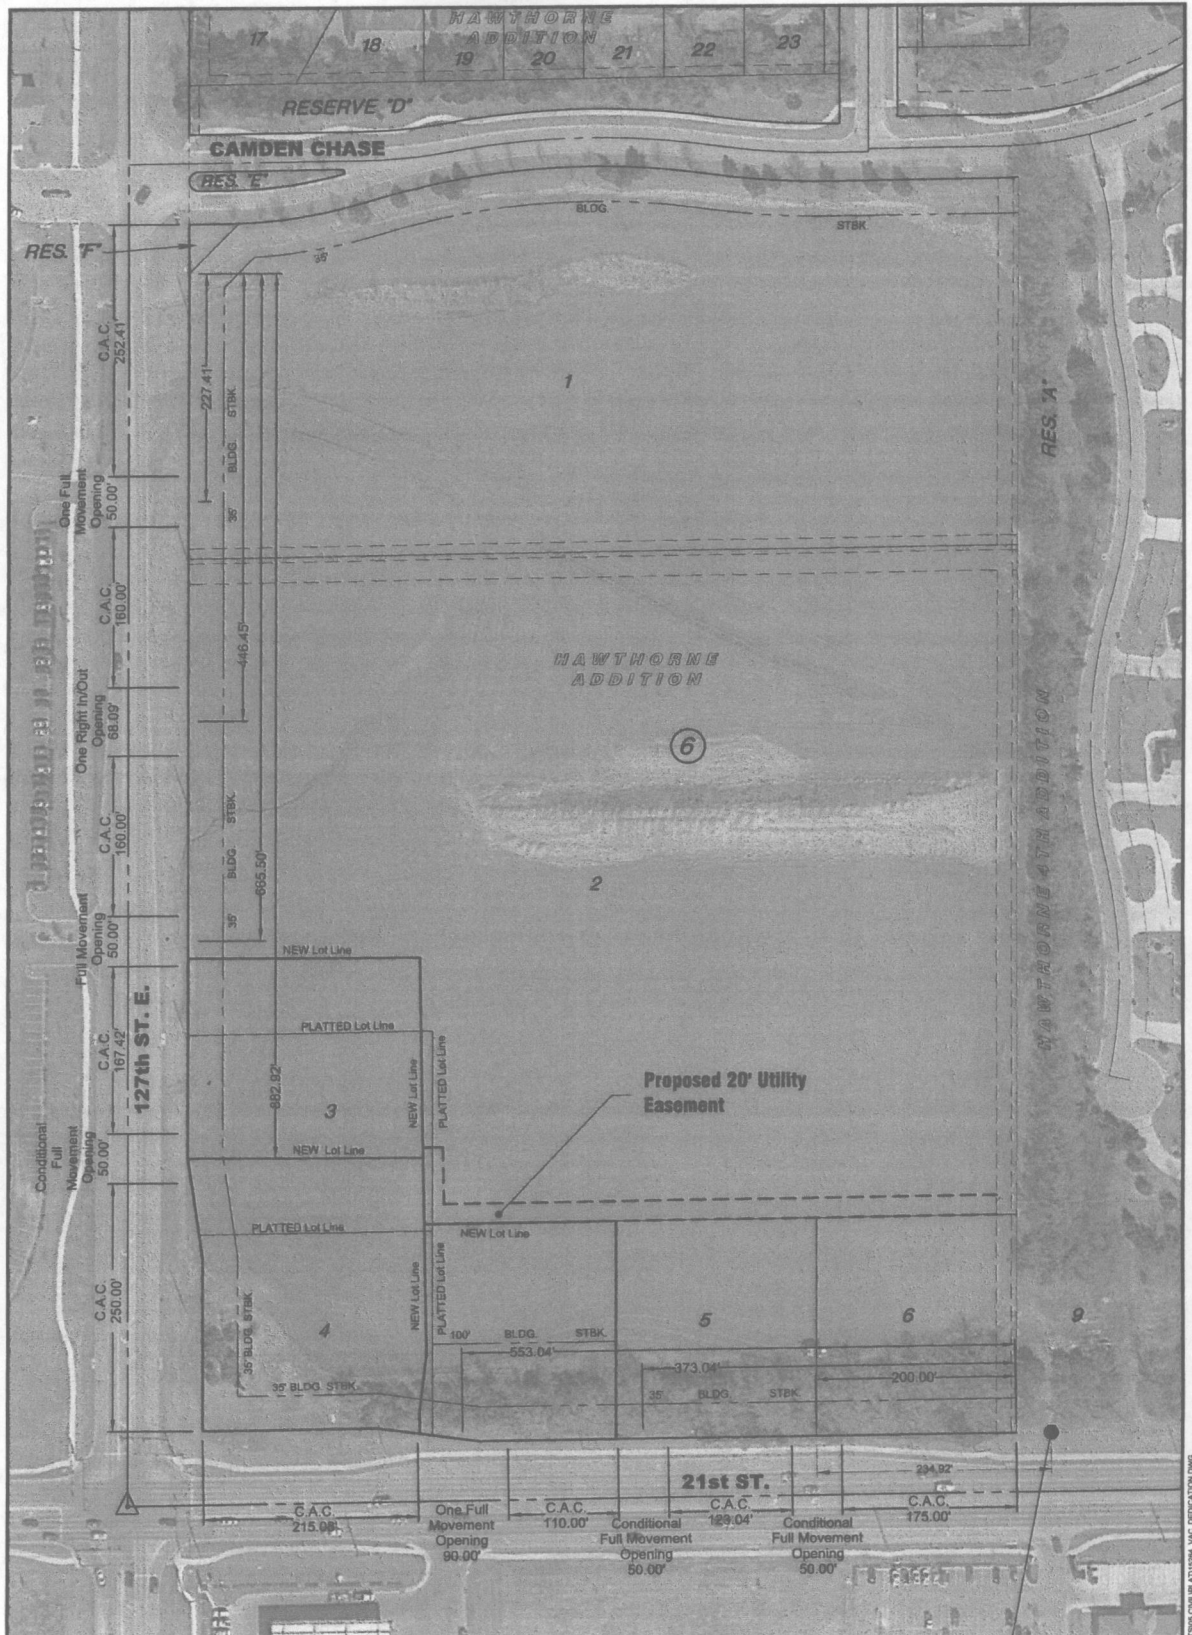

NOTES:

1. The two access points labeled Conditional Opening 50.00' on Lots 5 and 6 are conditional based on the event that the City of Wichita exercises its right to construct a center median in 21st Street at its cost; at such time said conditional openings shall become right-in / right-out only.
2. The conditional full movement access point on 127th Street providing access to Lots 3 and 4 is conditional based on the land use on Lot 4 producing traffic trips generations similar to or less than that of a bank with drive thru lanes. Bank drive-in trip generations shall be quantified by the current edition of the Institute of Transportation Engineers, Trip Generation Manual.

Centerline of
Anticipated
Future Full
Movement Drive



©2015
MKEC Engineering
All Rights Reserved
www.mkec.com
These drawings and their contents,
including, but not limited to, all
concepts, designs, & ideas are the
exclusive property of MKEC
Engineering (MKEC), and may not be
used or reproduced in any way without
the express consent of MKEC.



ACCESS CONTROL DEDICATION EXHIBIT HAWTHORNE ADDITION LOTS 1, 2, 3, 4, 5, AND 6, BLOCK 6

PROJECT NO. 1501010264	DATE: JUNE 2015	SHEET NO.
DRAWN BY: JGD	DESIGNED BY: JGD	APPROVED BY: BDL
		1 OF 1

J:\PROJECTS\2015\1501010264 - HAWTHORNE ADDITION - 127TH AND 21ST - 15064 CADD\21ST CIVIL PLAN\SSA, LAC, DEDICATION.DWG