
SITE PLAN

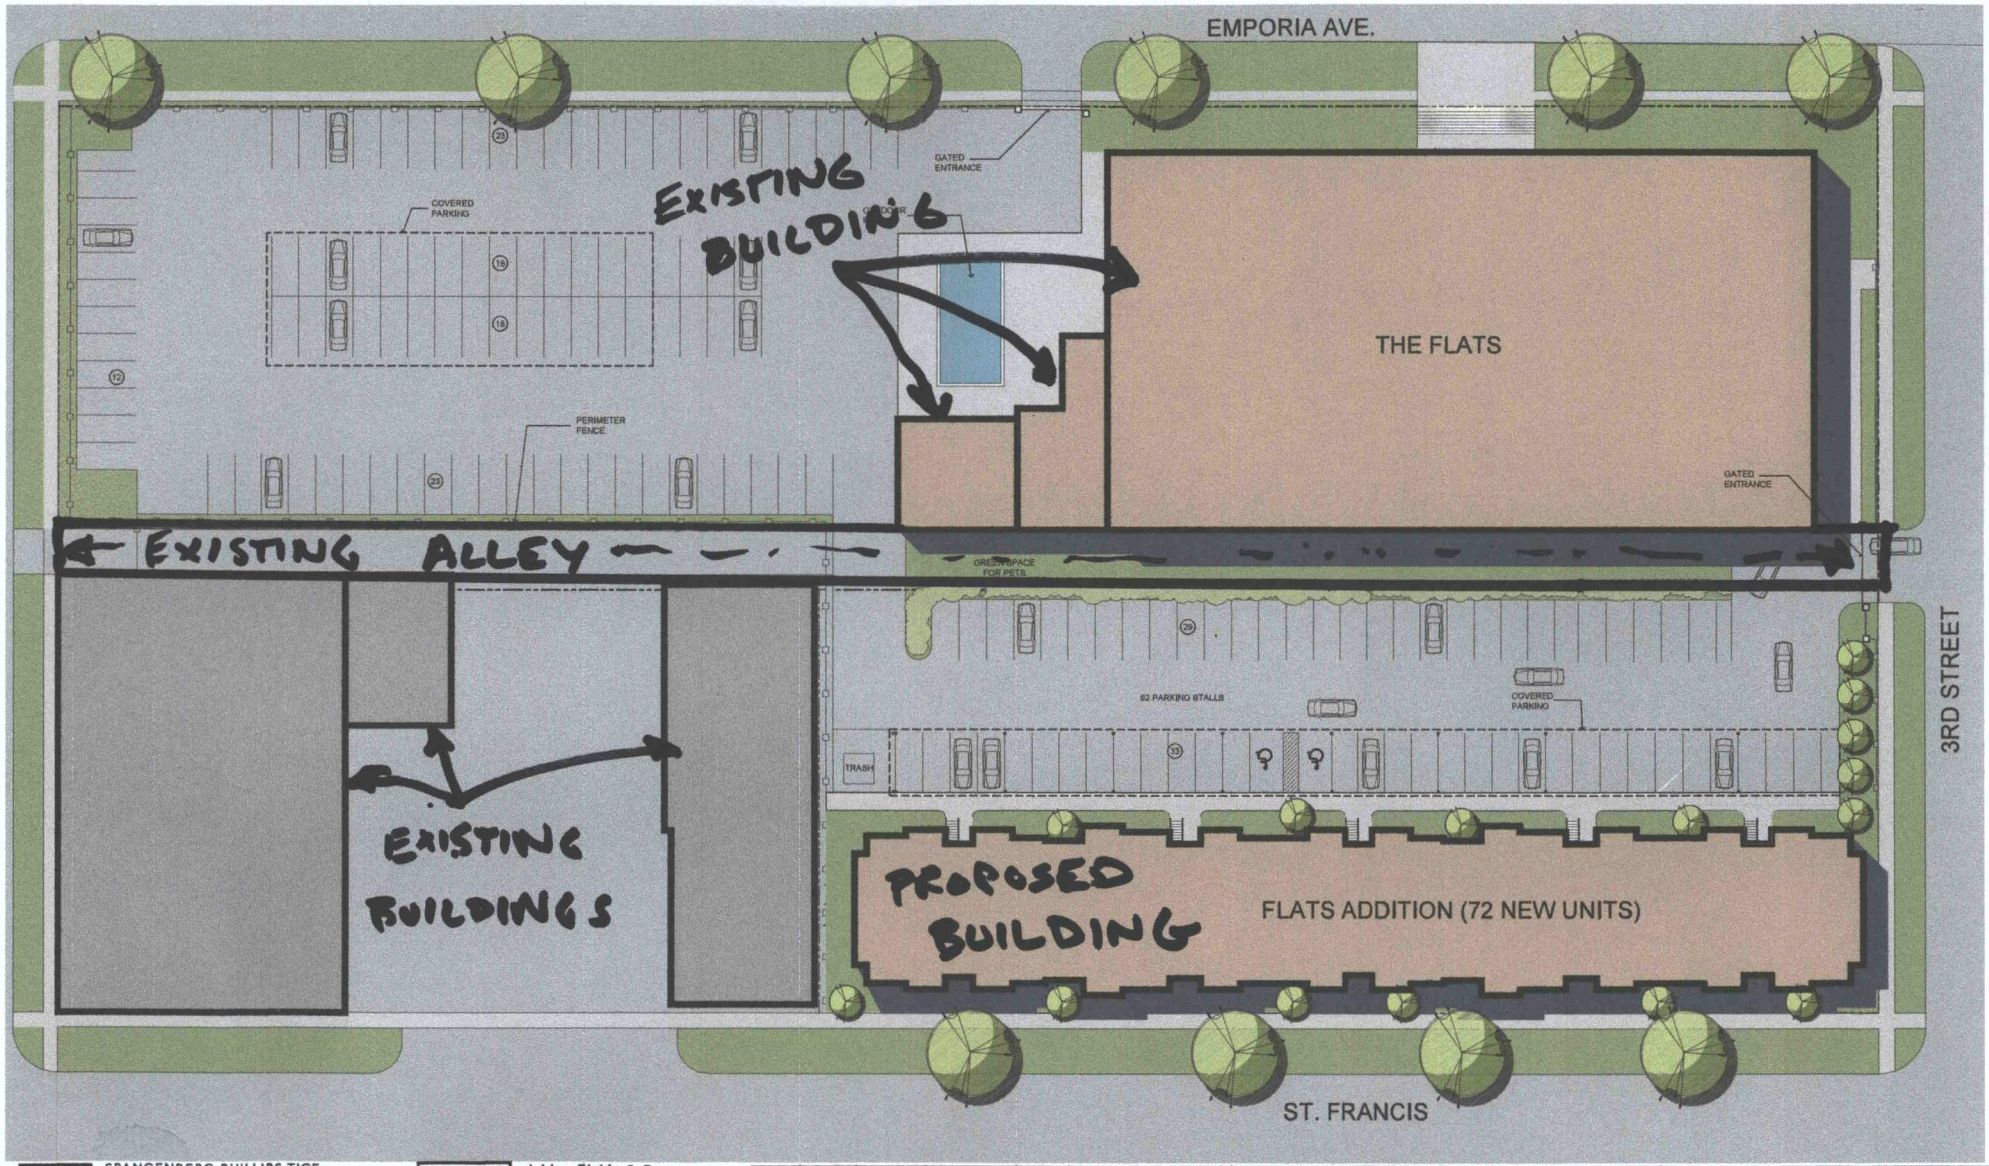

SPANGENBERG PHILLIPS TICE ARCHITECTURE
121 N Mead Ste 201 Wichita KS 67202
T 316.267.4002 F 316.267.1509
www.sptarchitecture.com

J. Van Sickle & Company
151 N. Rock Island, Suite 1C
Wichita, Kansas 67202
UNITAS

VDC2015-19

THIRD STREET APARTMENTS

EXPANSION OF FLATS-324 APARTMENTS

30APR15