


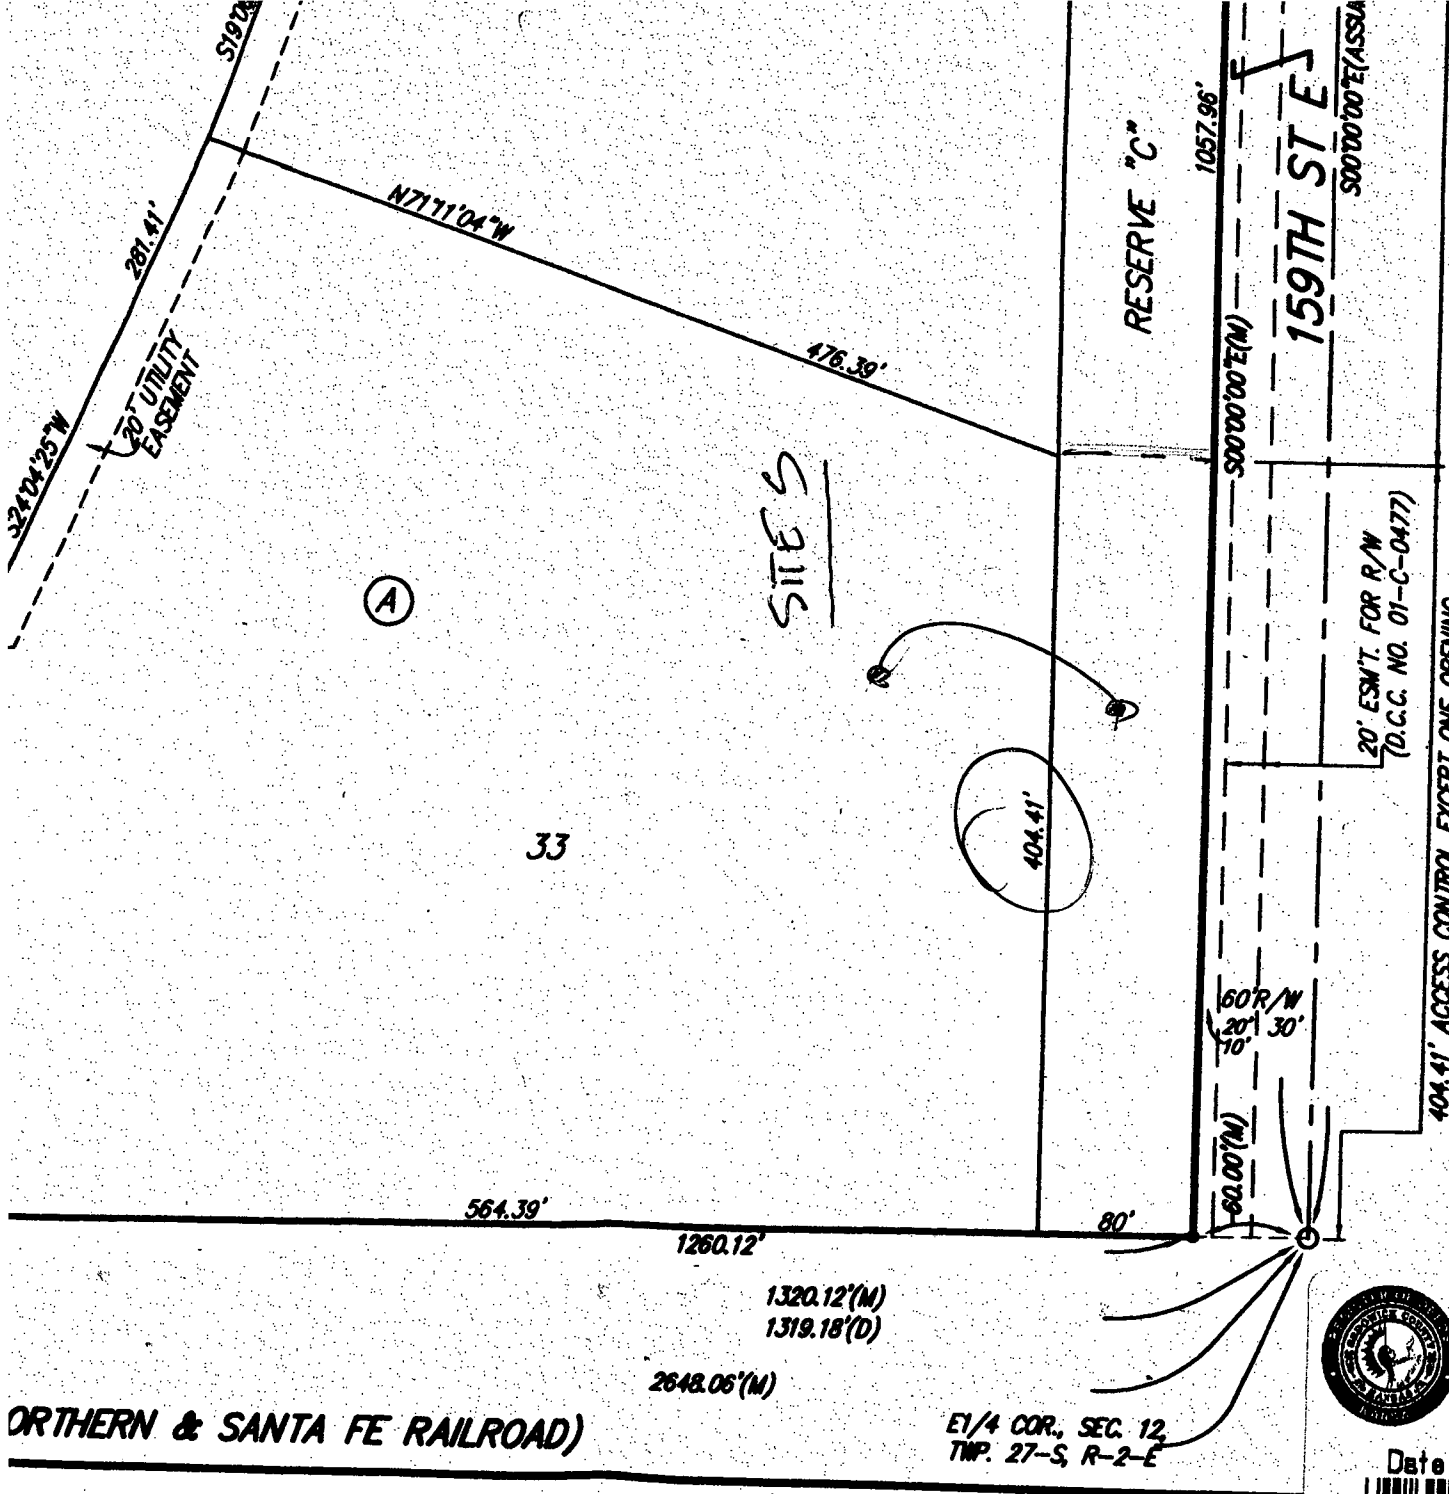

Accepted by
of NOVEM

29th day

CLERK OF SEDGWICK COUNTY

of Decem

State of Kansas
Sedgwick County
the office of the
at 2:13:30'clock

N
↑

VAC2015-20

Sedgwick Co.
Register of Deeds--
DOC.#/FLM-PG:
Receipt #: 1880768
Pages Recorded: 1
Cashier Initials: MLM

Date Recorded: 12/13/20

STATE OF KANSAS
Sedgwick County
REGISTER OF DEEDS



Wichita-Sedgwick County Metropolitan Area Planning Department

November 28, 2016

Baughman Company, P.A.
Attn: Phil Meyer
315 Ellis
Wichita, KS, 67211


Ref: VAC2015-00020 - Request to Vacate a Portion of Platted Complete Access Control on Property Generally Located Between East 13th Street North and East 21st Street North on the West Side of North 159th Street East (District II)

Dear Mr. Meyer:

At its regular meeting on Tuesday, November 22, 2016, the Wichita City Council considered the above-referenced request. The action of the City Council was to **APPROVE** subject to the recommendation by the MAPC.

If you have any questions about this matter, please call 268-4421.

Sincerely,

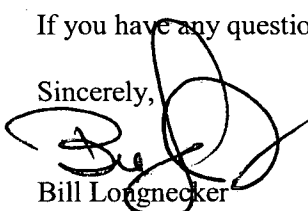

Bill Longnecker
Senior Planner

BL:klw

cc: RBR Land LLC, Kevin Mullen, 8100 E 22nd St N, Bldg 1000, Wichita KS 67226
Timothy J Buchanan Revocable Trust, 8415 E 21st St N, Suite 100, Wichita KS 67206