



Wichita-Sedgwick County Metropolitan Area Planning Department

September 8, 2015

Newmarket Office, LLC
Attn: David Hambrick
727 N. Waco
Wichita, KS, 67203


Ref: VAC2015-00024: City request to vacate the platlor's text to amend the uses allowed within platted reserves on property generally location west of Maize Road on the north side of 29th Street North.

Dear Mr. Hambrick:

At its regular meeting on Tuesday, September 8, 2015, the Wichita City Council considered the above-referenced request. The action of the City Council was to **APPROVE** subject to the recommendation by the MAPC.

If you have any questions about this matter, please call 268-4421.

Sincerely,

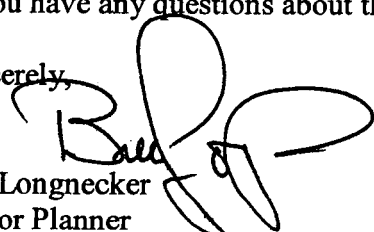
Bill Longnecker
Senior Planner

BL:klw

cc: Charlie Brown, PEC, 303 S Topeka, Wichita KS 67202

PC 227-3



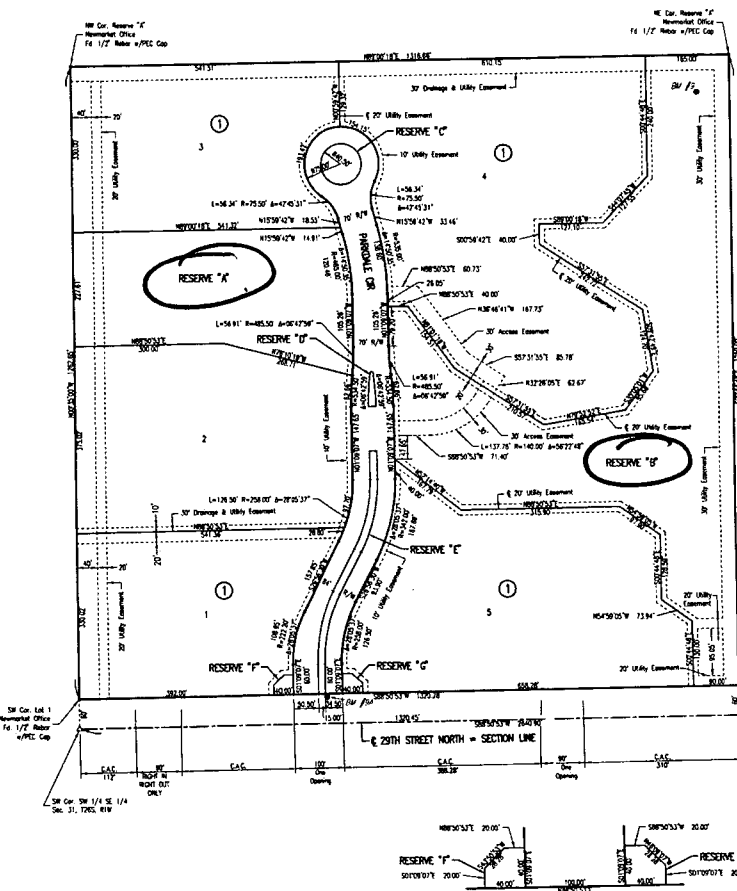





JAMES R. BECKETT, R.E.S. NO. 1832

CAUSED THE LAND TO BE SURVEYED AND PLATTED INTO LOTS, A BLOCK, AND RESERVES THE SAME TO BE KNOWN AS NEWMARKET OFFICE 2ND, AN ADDITION TO MONTH, SECDORCK COUNTY, KANSAS.

APR 1987
FPM-PG: 29219108
LJ60693
Authorized By [Signature] Recording Fee \$25.00

PC 227-3