

4/29/15
UST

DOUGLAS


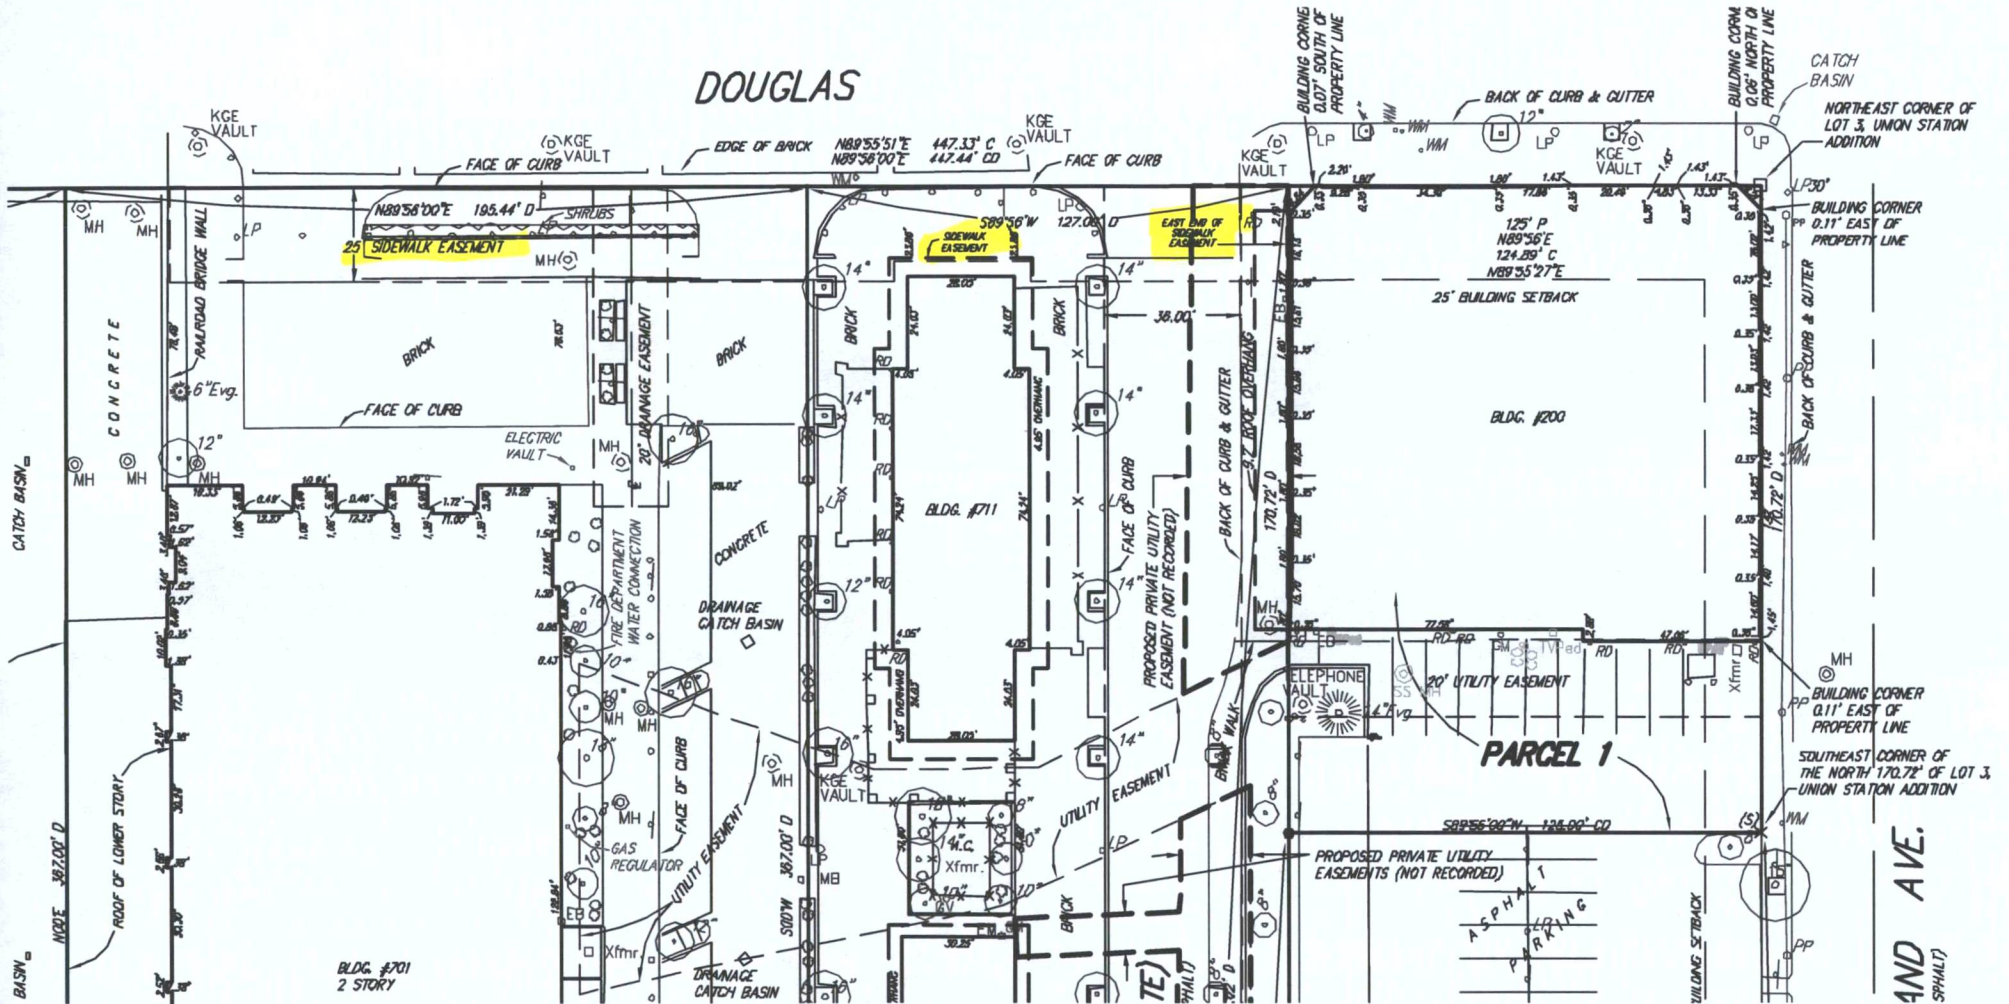


Exhibit A

Vacation of sidewalk easement.

Union Station, Wichtiam Kansas.

VAC2015-25

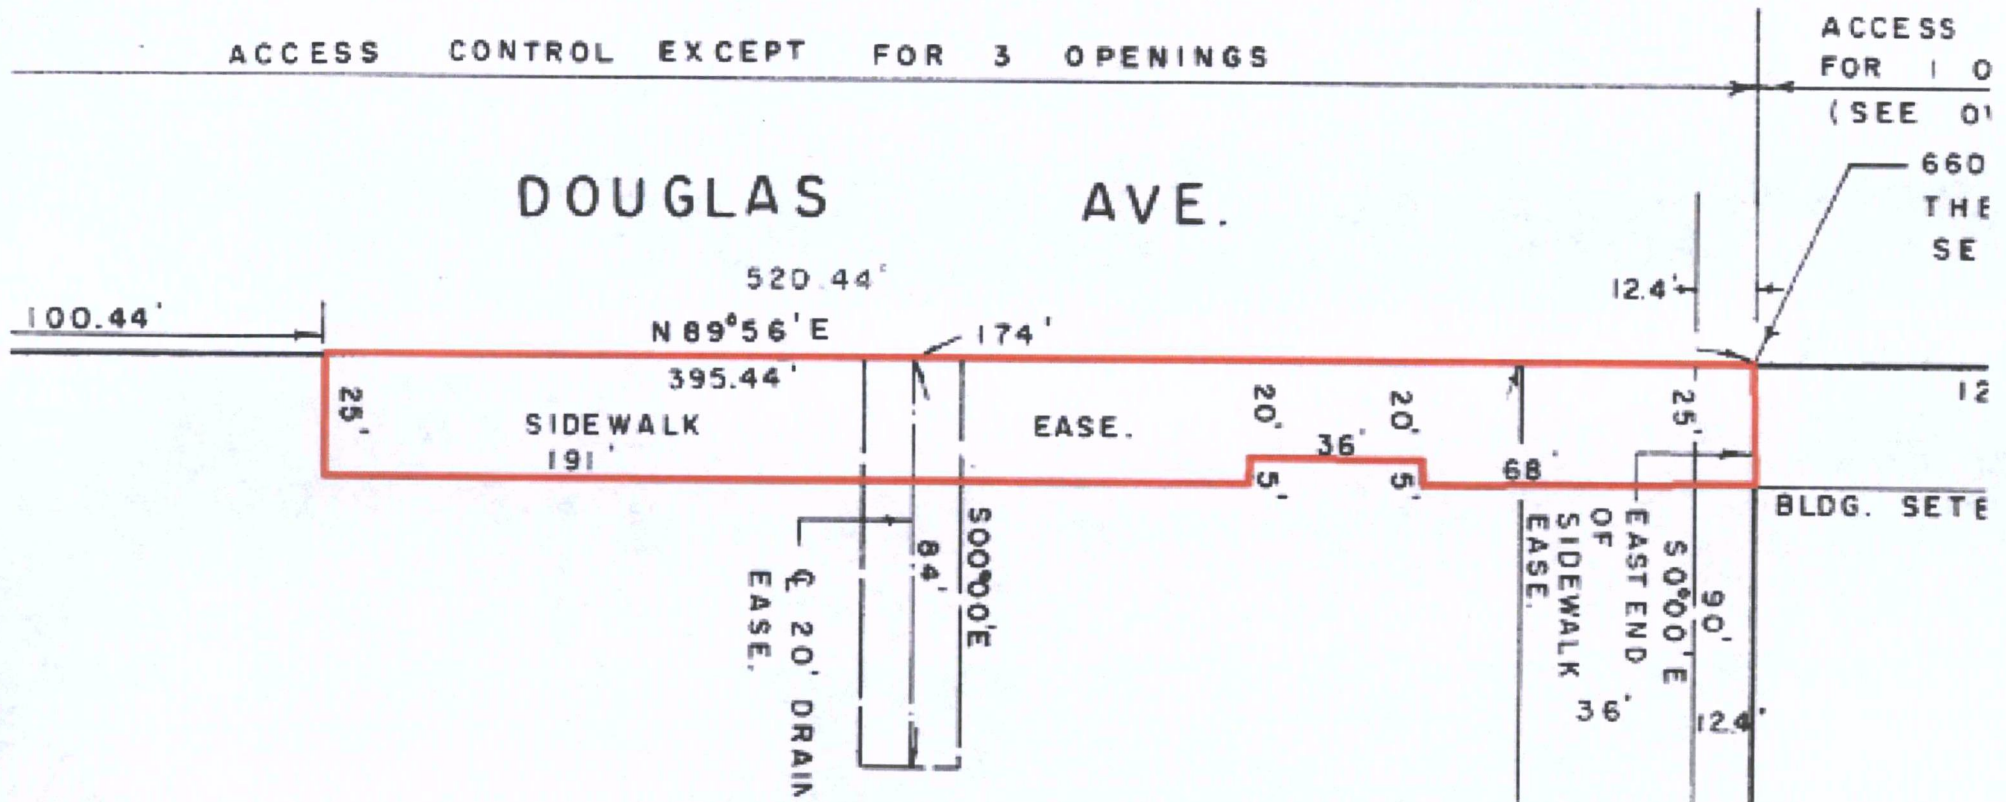

All of the sidewalk easement platted in lot 1.

Union Station Addition

Wichita, Sedwick County, Kansas.