


NOTE:

VAC2015-30

1. The Conditional Full Movement Opening on Lot 13 is conditional based on in the event that the City of Wichita exercises its right to construct a center median in Rock Road at the cities cost; at such time said conditional opening shall become right-in / right-out only.

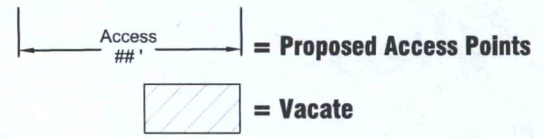

©2015
MKEC Engineering
All Rights Reserved
www.mkec.com
These drawings and their contents, including, but not limited to, all concepts, designs, & ideas are the exclusive property of MKEC Engineering (MKEC), and may not be used or reproduced in any way without the express consent of MKEC.



<p>LOT 13 BRAD BOONE ADDITION VACATION - EXHIBIT</p>		
PROJECT NO. 1501010392	DATE: JUNE 2015	SHEET NO.
DRAWN BY: JGD	DESIGNED BY: JGD	APPROVED BY: BDL
		1 OF 1