



Wichita-Sedgwick County Metropolitan Area Planning Department

May 17, 2016

Julius Properties, L.P.
Attn: Brad Julius
4011 E. 31st Street S.
Wichita, KS 67210


Ref: VAC2016-00007 - Request to Vacate a Platted Drainage Easement on Property Generally Located West of Interstate Highway I-35 and Southeast of the East 31st Street South and South Navajo Street Intersection (District III).

Dear Mr. Julius:

At its regular meeting on Tuesday, May 10, 2016, the Wichita City Council considered the above-referenced request. The action of the City Council was to **APPROVE** subject to the recommendation by the MAPC.

If you have any questions about this matter, please call 268-4421.

Sincerely,

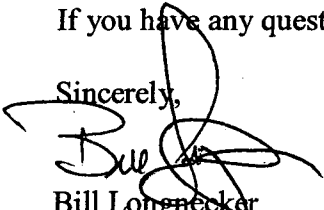
Bill Longnecker
Senior Planner

BL:klw


cc: Julius Properties LP, PO Box 74, Atlanta KS 67008

R. NE 1/4, SEC. 11,
R1E, 6TH T. 28S,
72° BEAR

ALTA/ACSM LAND TITLE SURVEY

A Portion of the NE 1/4, SEC. 11, T28S, R1E

to be vacated
KANSAS TURNPIKE
CONDAMNATION CASE NO. A-56278
HWY I-35

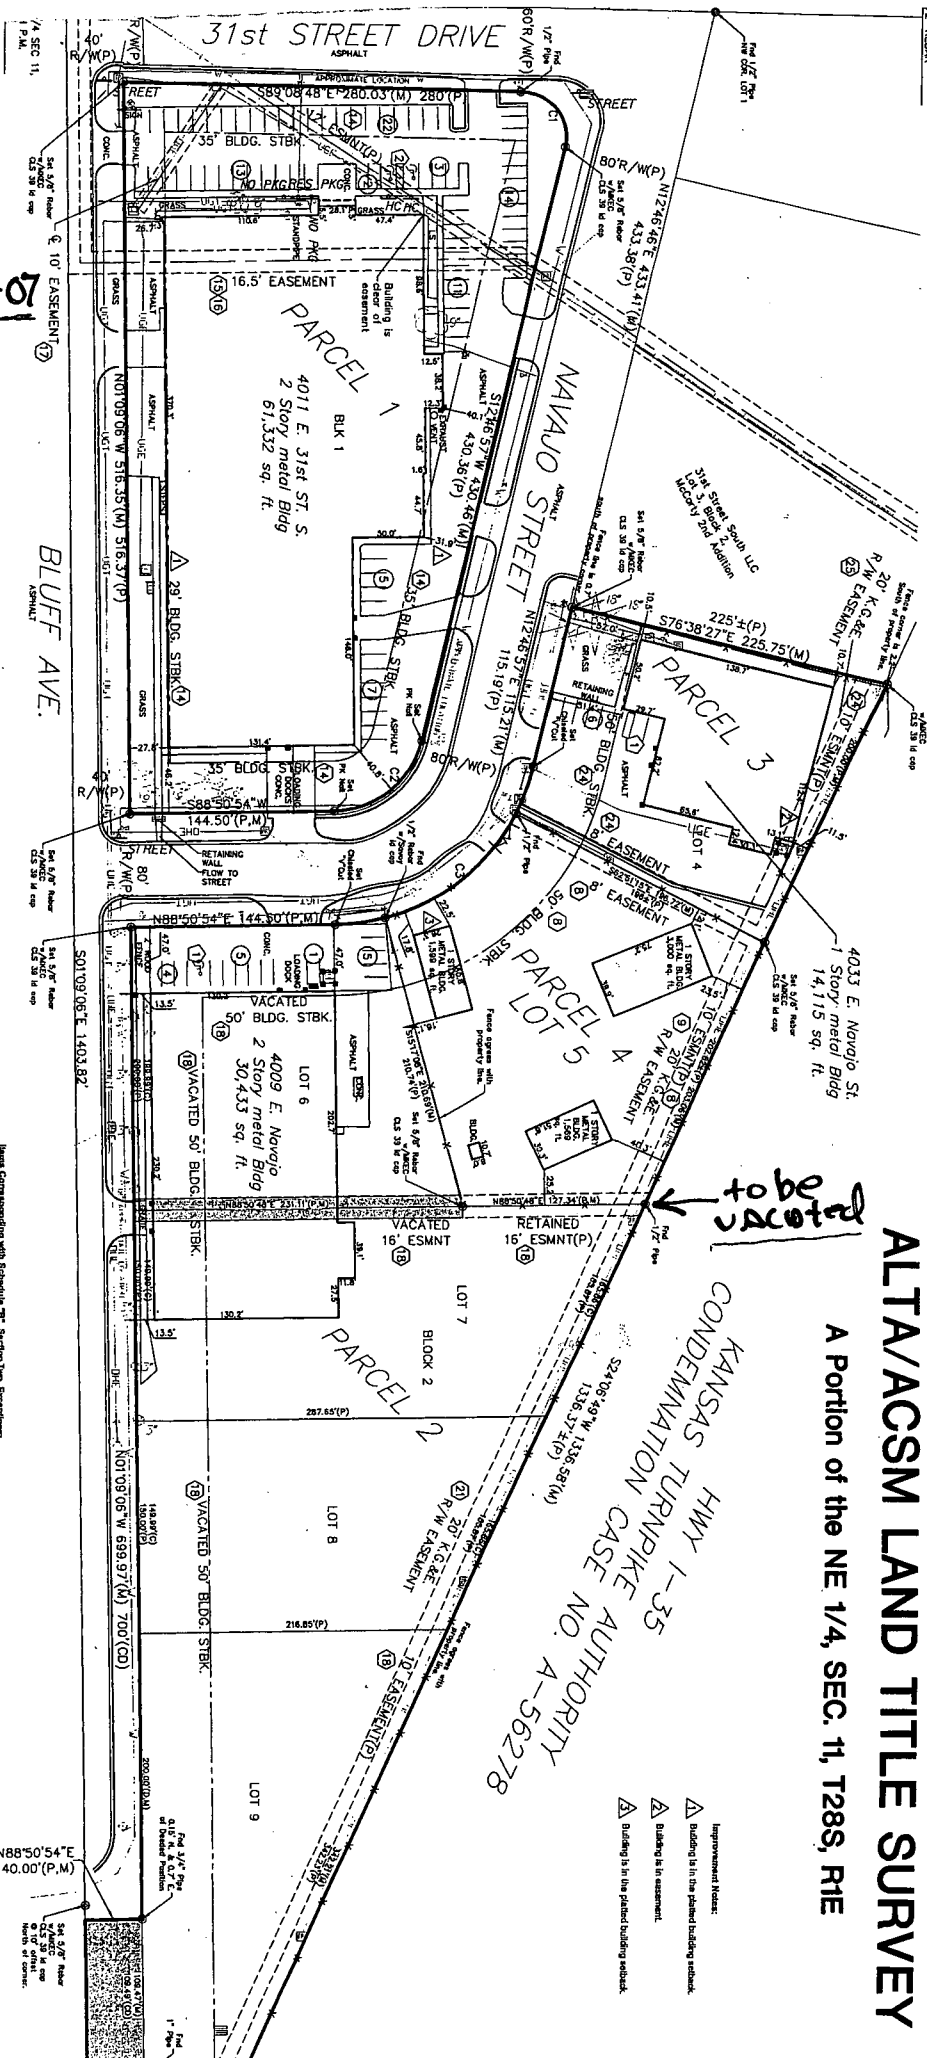

LEGEND

- TELEPHONE RISER
- UNDERGROUND TELEPHONE LINE
- GAS METER
- GAS LINE
- POWER POLE AND DEADMAN
- POWER POLE
- AIR CONDITIONING UNIT
- ELECTRICAL CONTROL BOX
- ELECTRIC TRANSFORMER
- POWER POLE WITH LIGHT
- UNDERGROUND ELECTRIC LINE
- OVERHEAD ELECTRIC LINE

Land Area:
Parcel 1 - 130.83 sq. ft. or 3.00 Acres
Parcel 2 - 168.67 sq. ft. or 4.35 Acres
Parcel 3 - 30.27 sq. ft. or 0.63 Acres
Lot 5 - 47.87 sq. ft. or 1.10 Acres

Curve Data:
C1
R=32.67' (M)
Δ=101°54'57\"/>

- Notes:
 - The underground electric lines shown herein were installed in the field by the utility owners in accordance with the applicable codes and standards.
 - The following matters shown on or disclosed by the recorded plat referred to in the legal description, including related lines and easements:
 - ALTA/ACSM Land Title Survey, 2147754, First American Title Insurance Company of Kansas, dated October 8, 2015.
 - THE FOLLOWING ITEMS AFFECT PARCEL 1:
 - 1. The following matters shown on or disclosed by the field or recorded map referred to in the legal description, including related lines and easements:
